



ML N° 892
87M

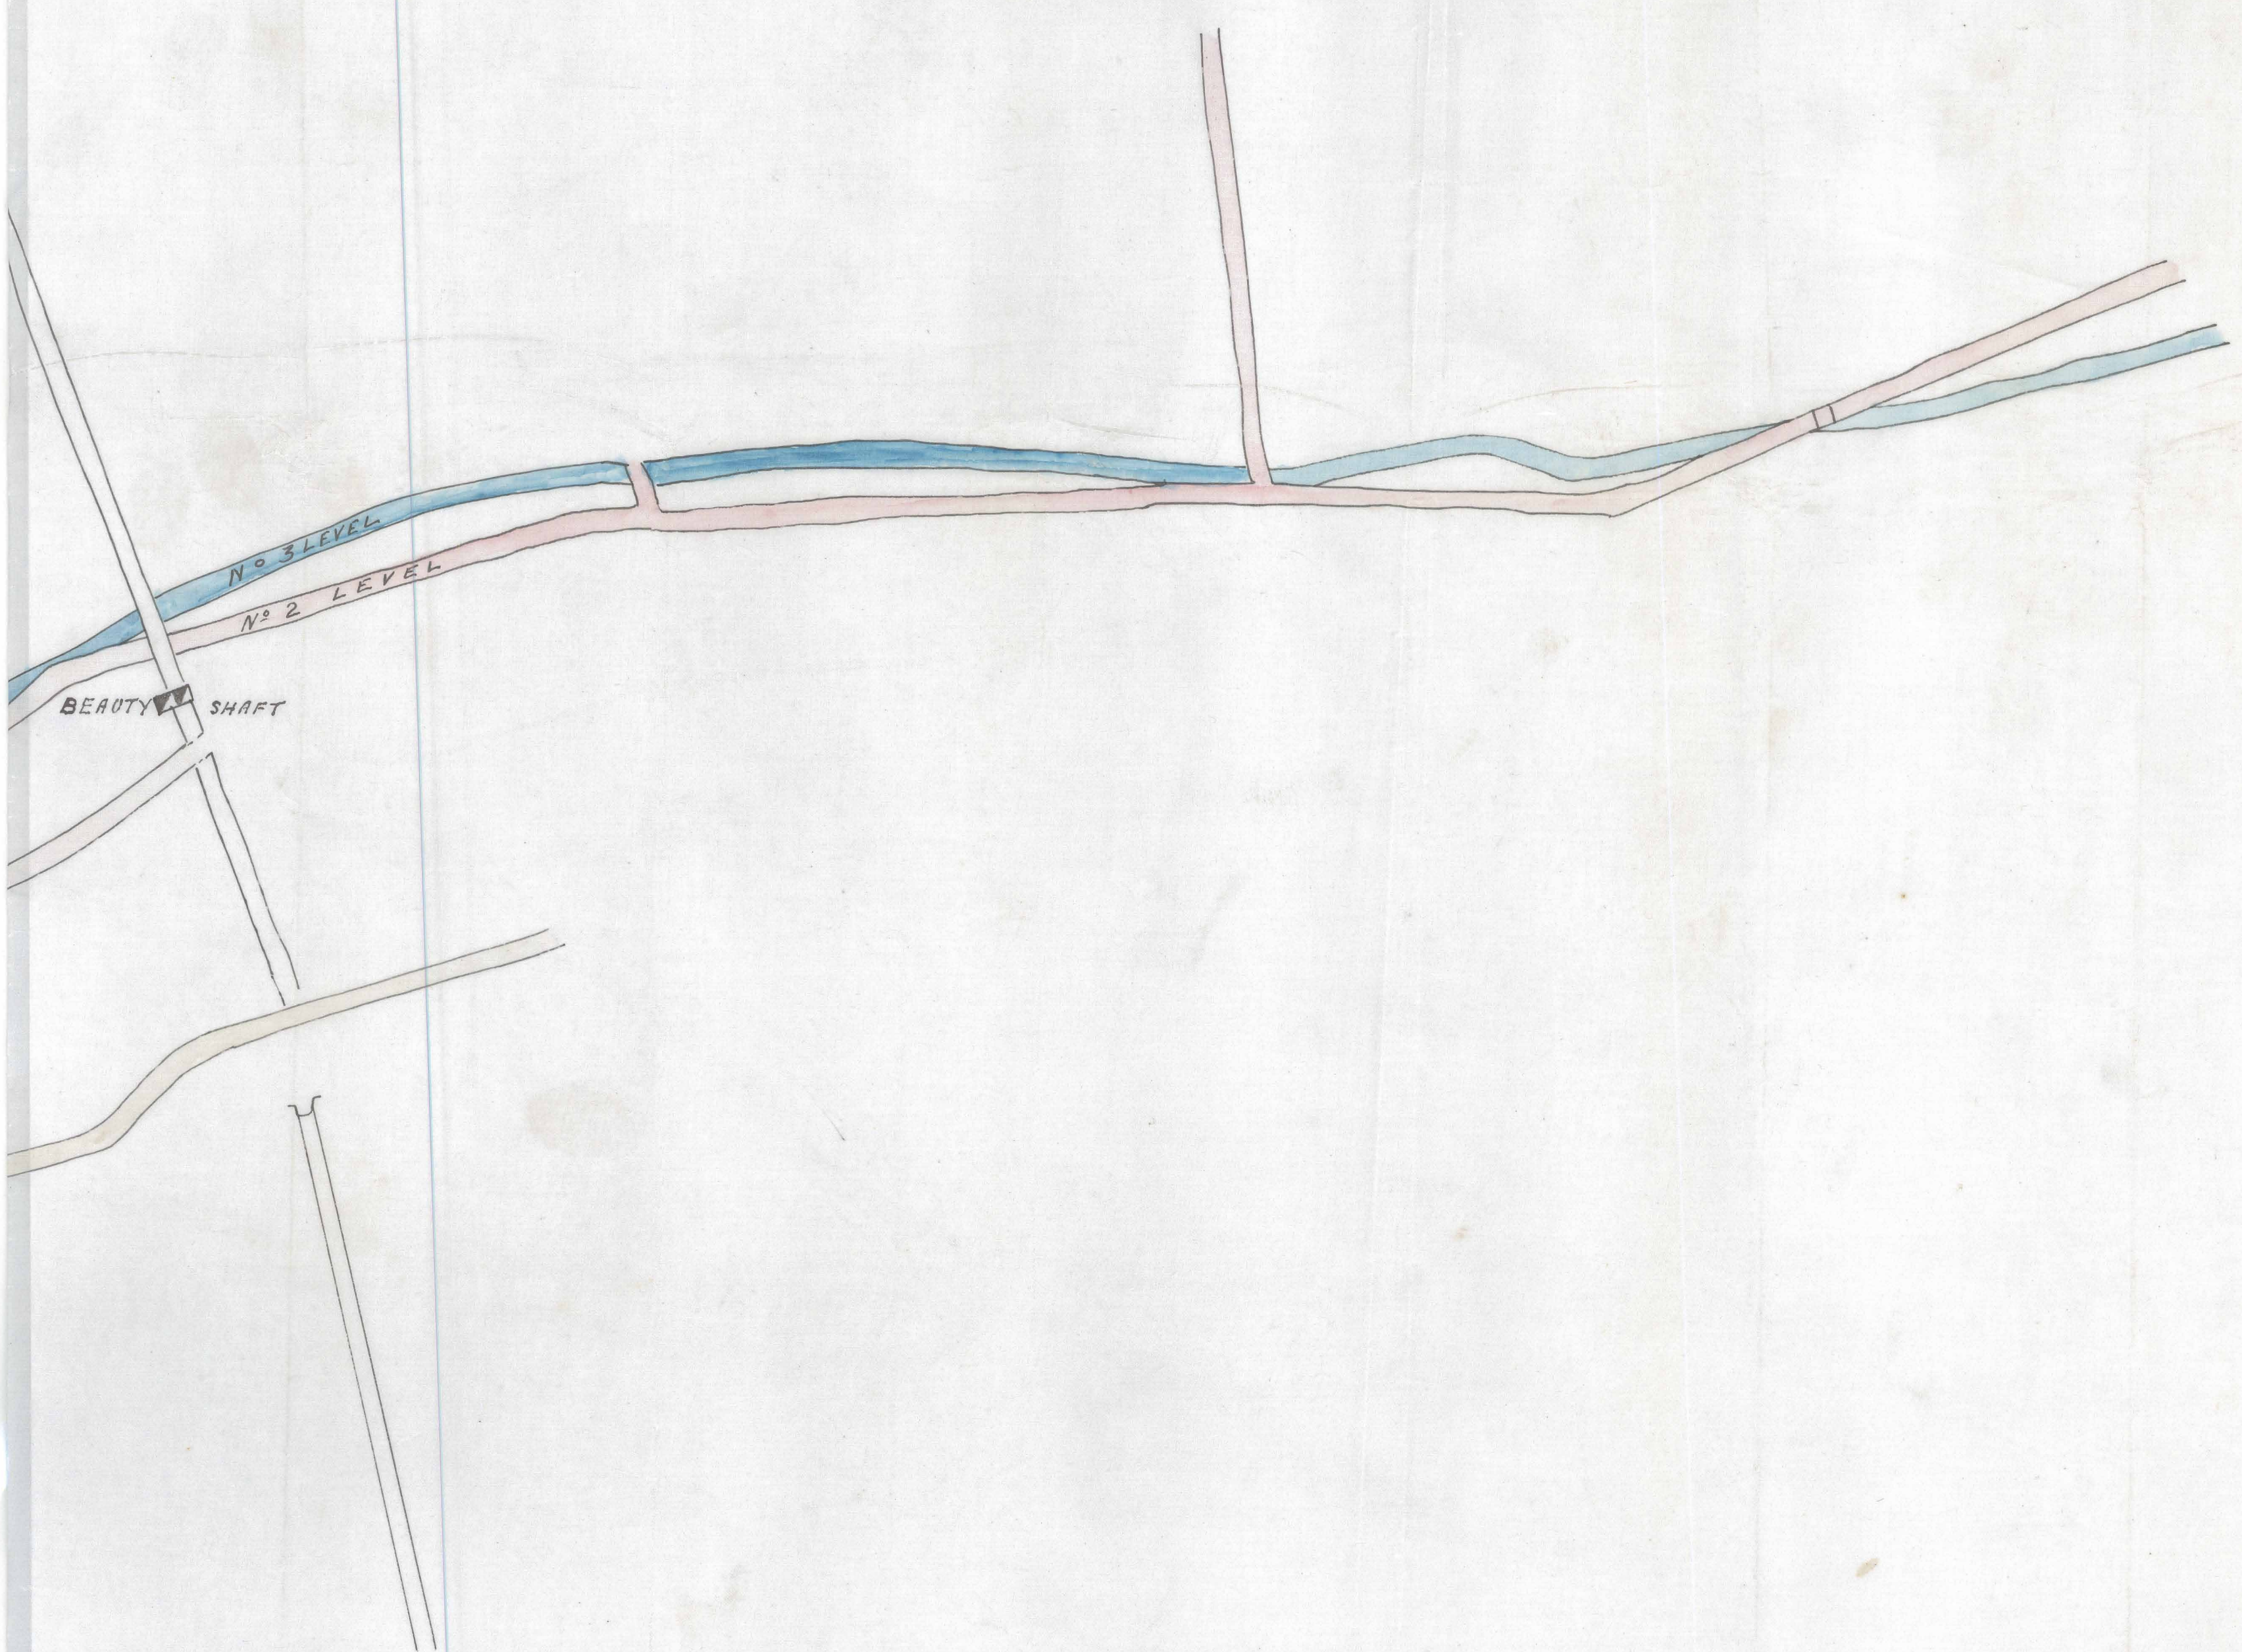

ML N° 756
87M

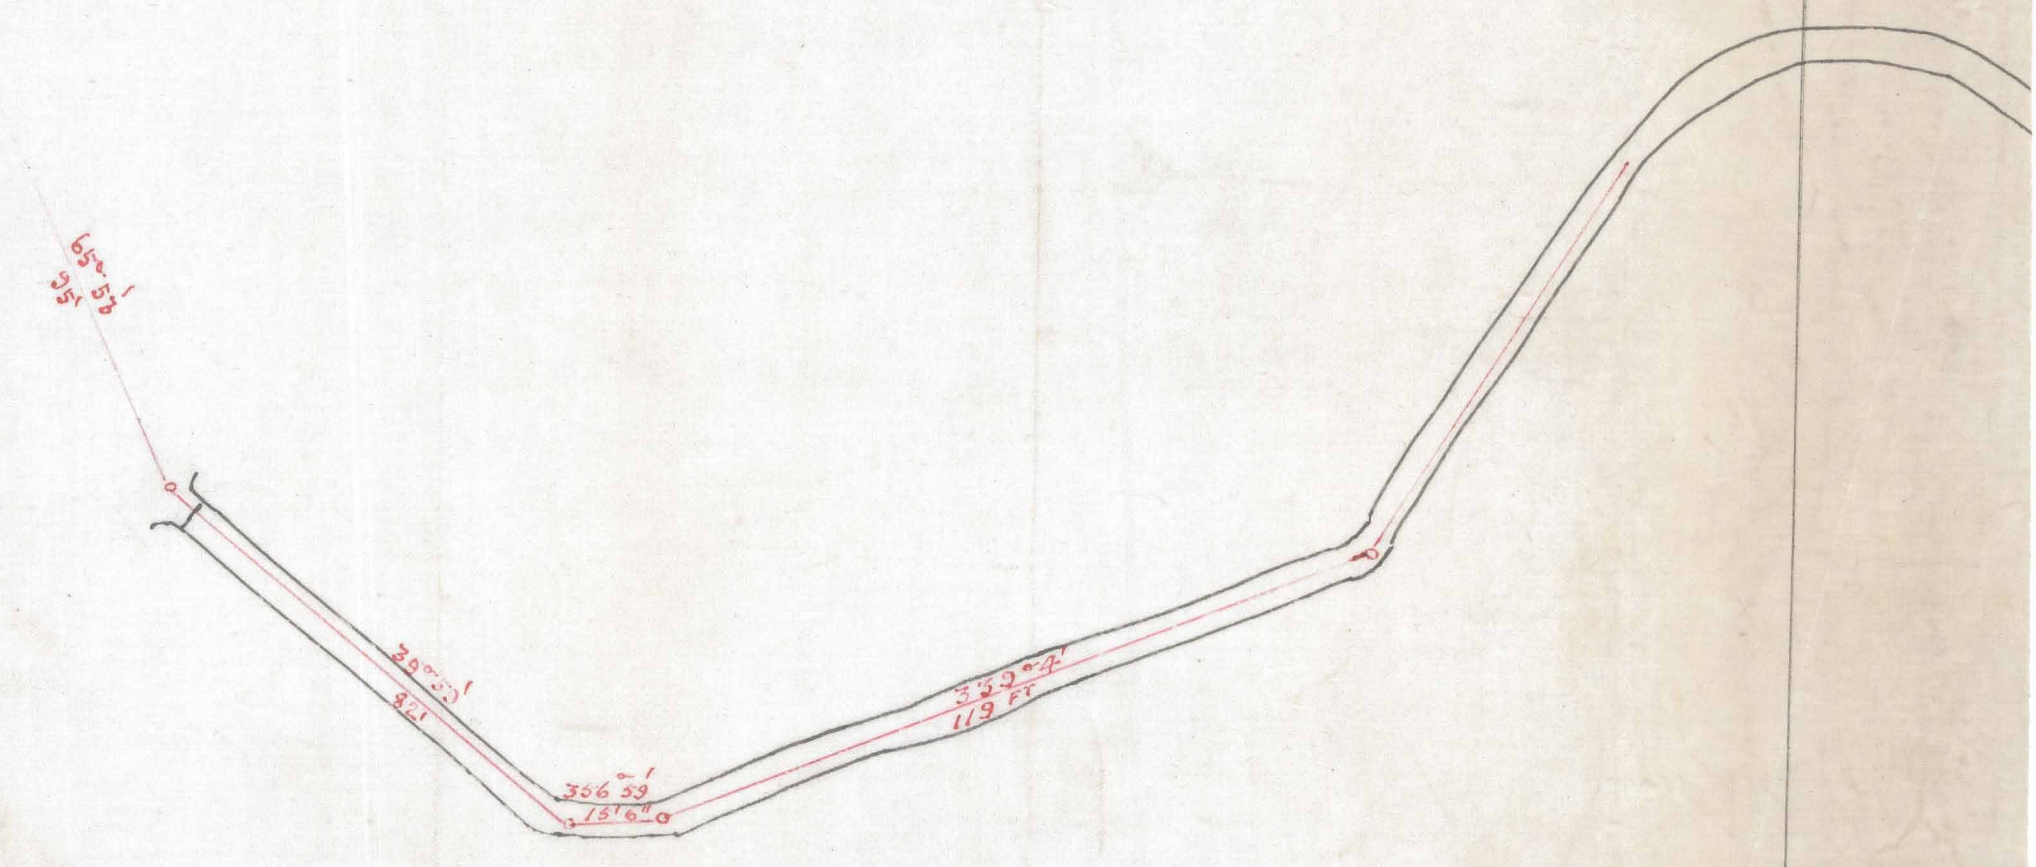

II