


1898

2 MAY 1898

5 cm

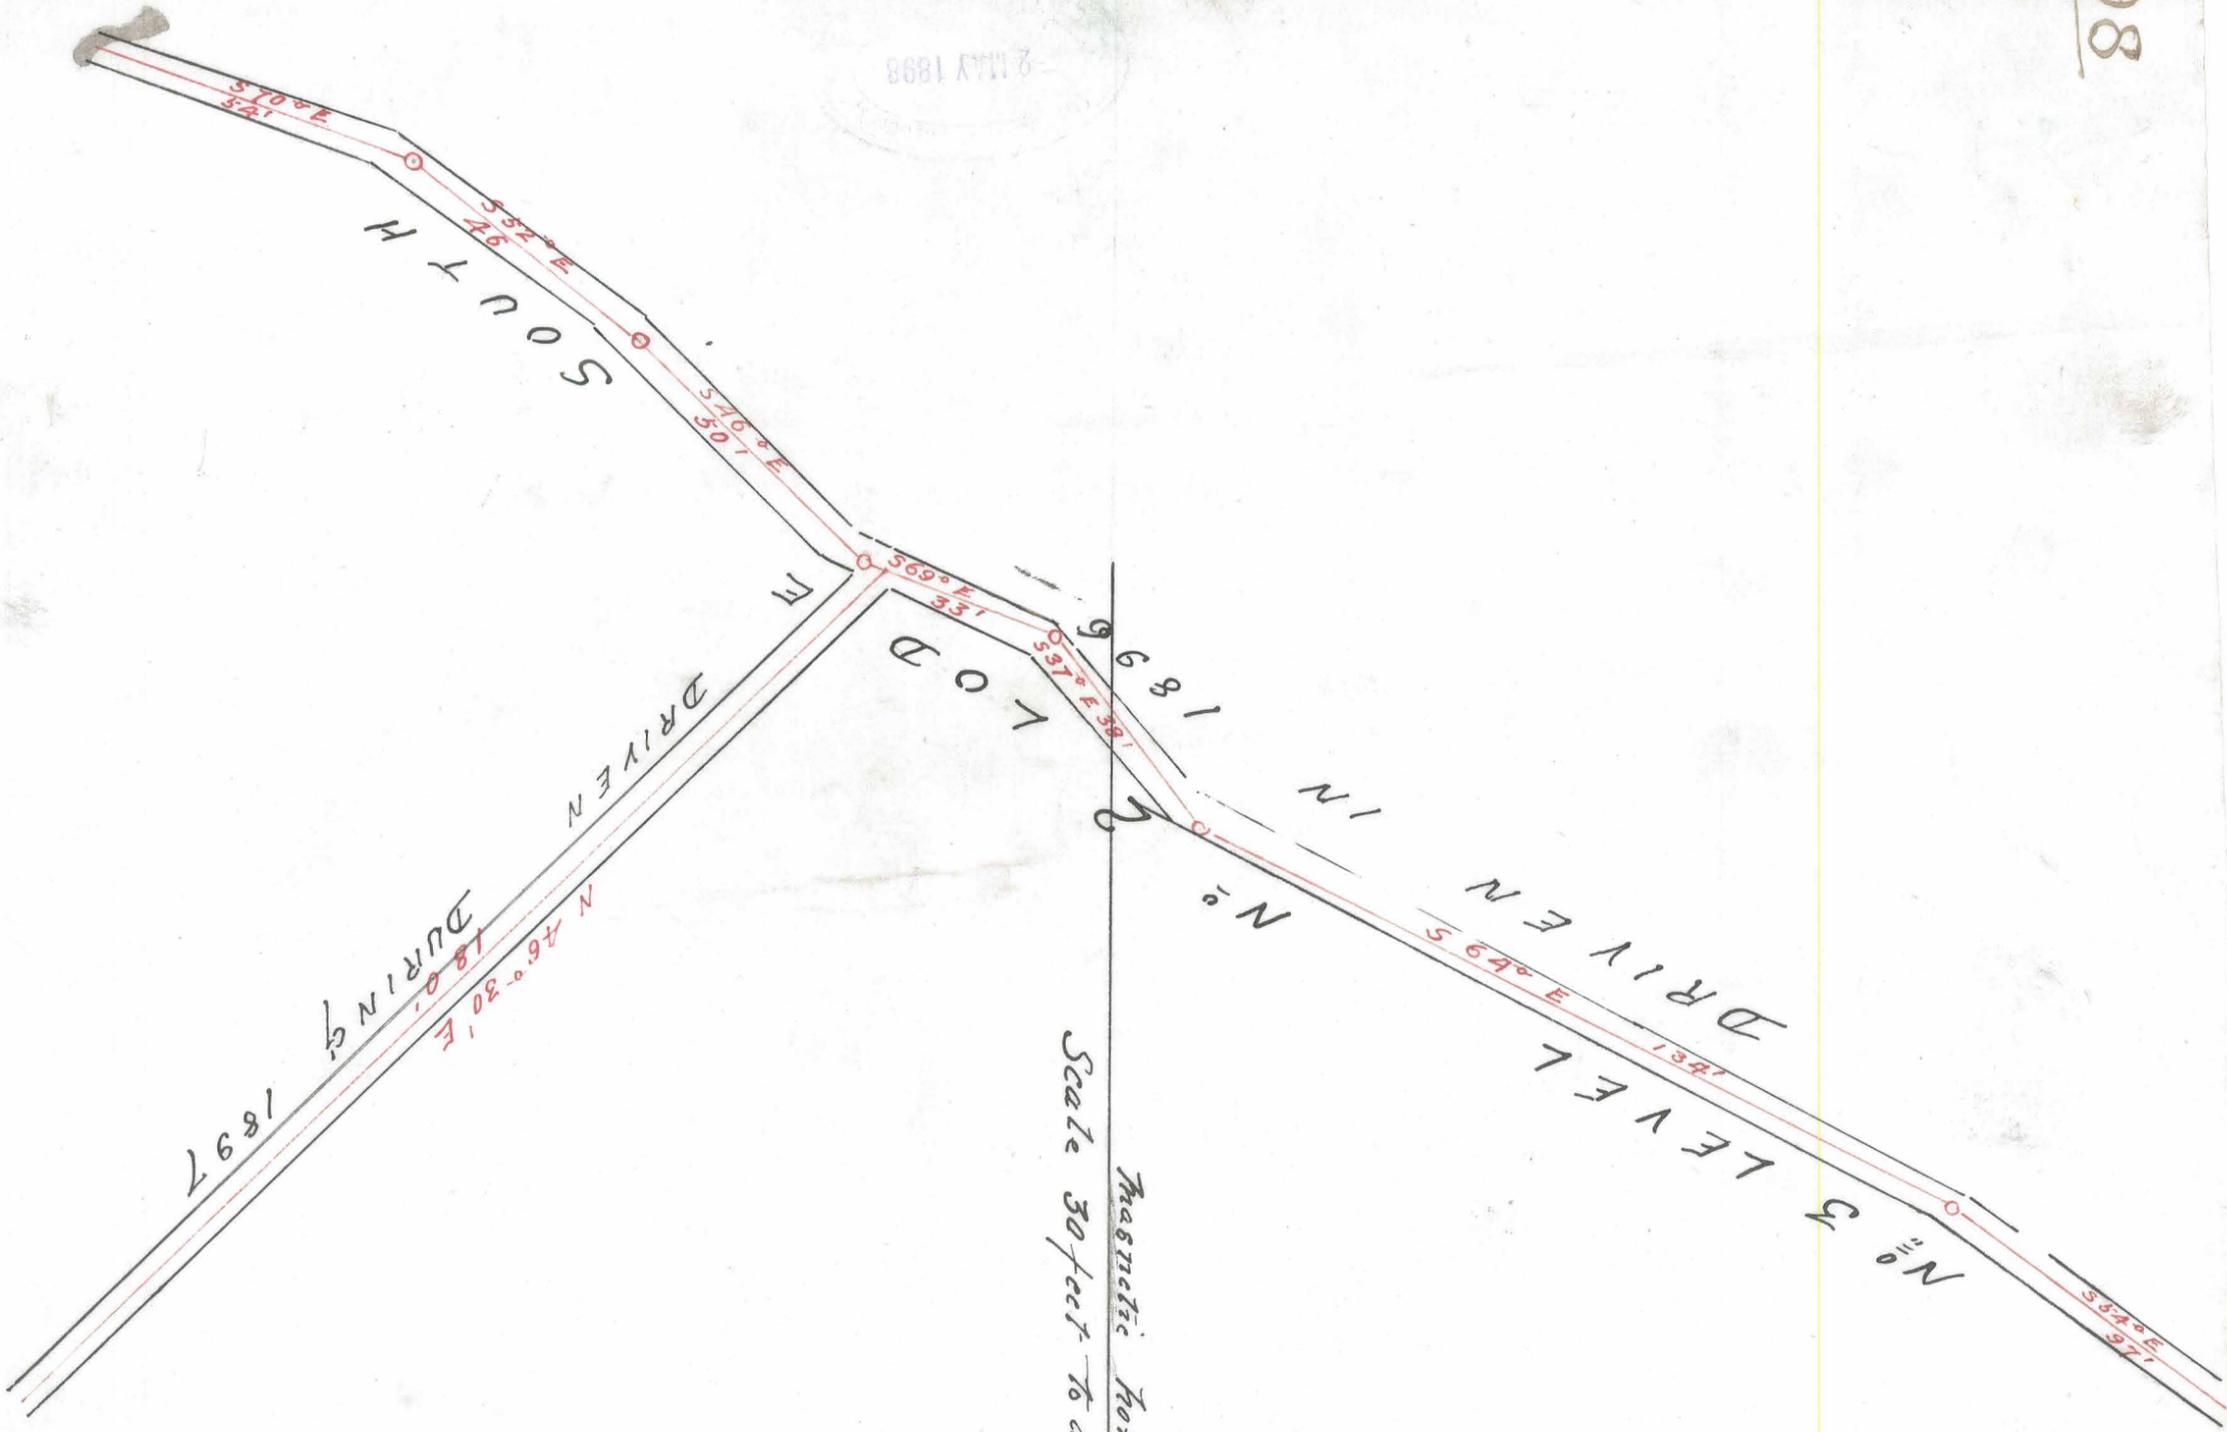

31