
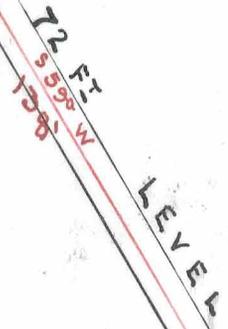
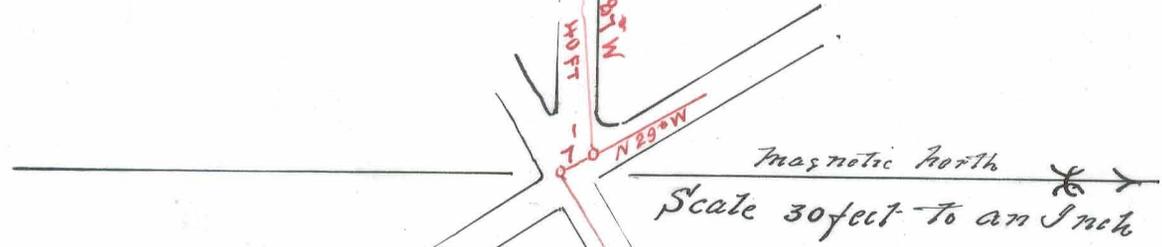
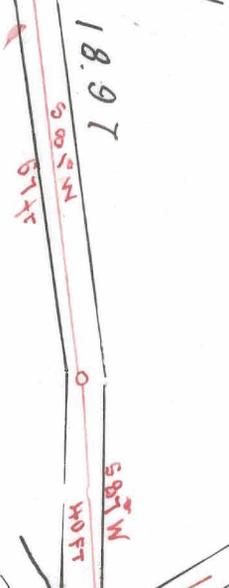


5 cm

42

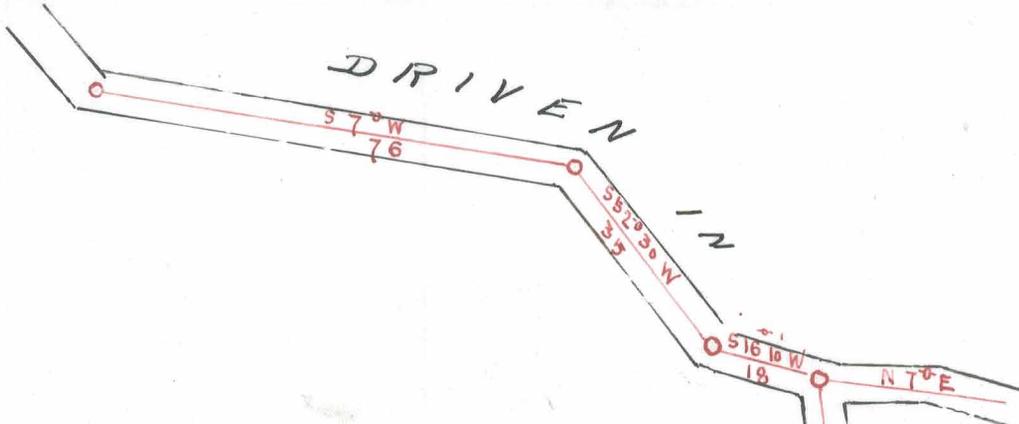

SIMSON'S SHAFT

2 MAY 1804