


5 cm

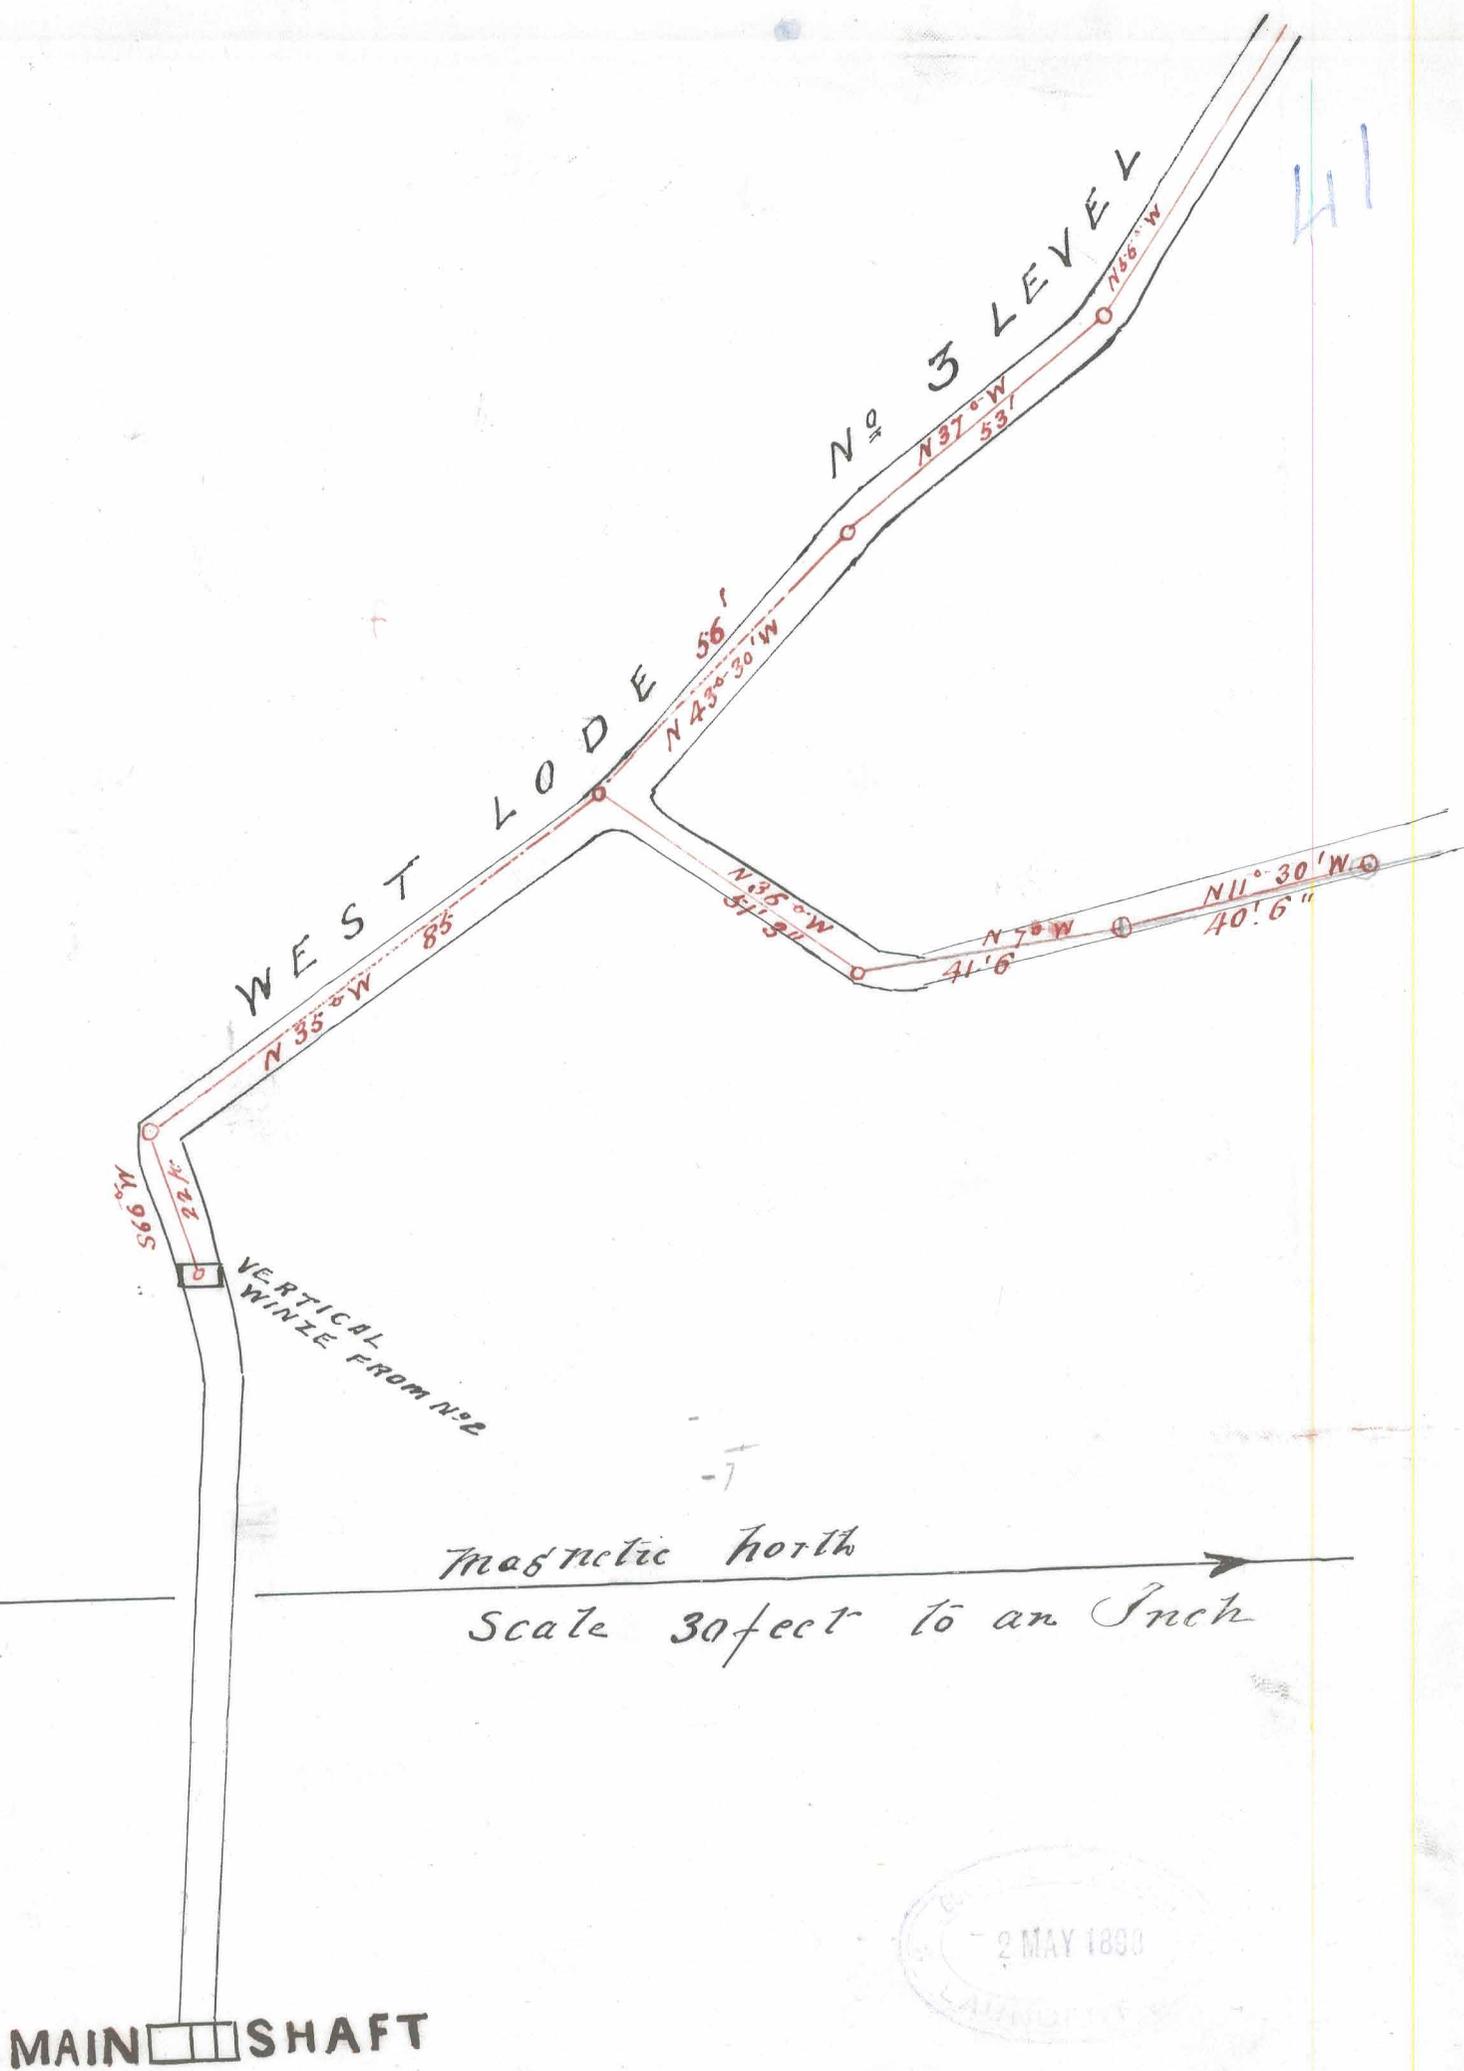

2 MAY 1893