


5 cm

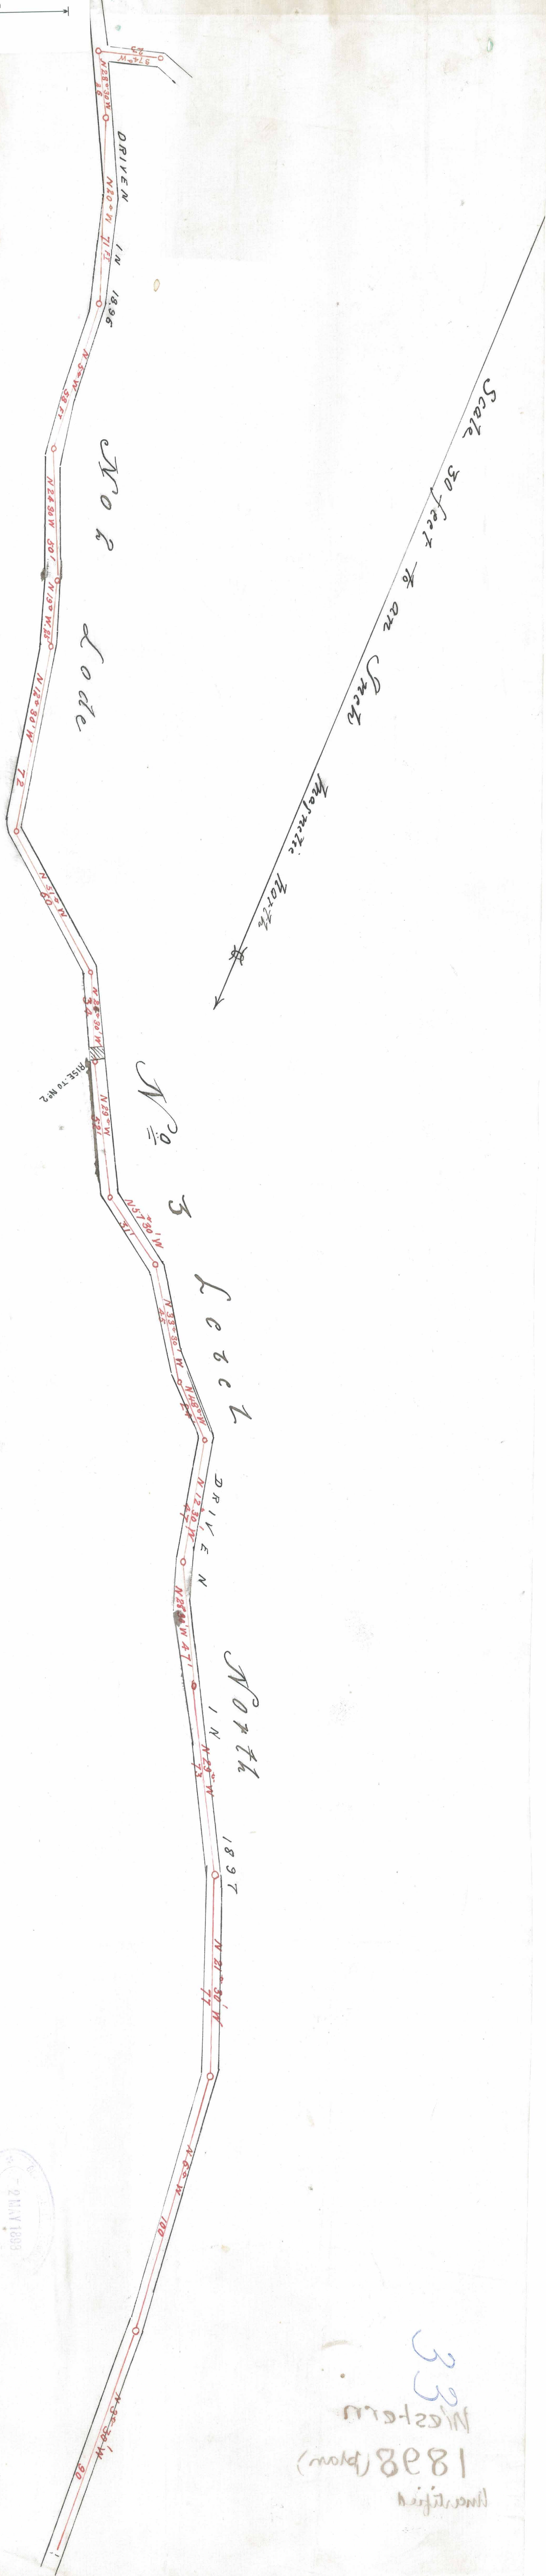

2 MAY 1893
L.A. CO. CALIF.

33
1898 (approx)
Mistaken