

# WESTERN MINE

2/2/94  
27th Jan 1896

26


## PLAN



SCALE 30 FEET TO ONE INCH

Blundrons.  
Jan. 1894  
Jan 30<sup>th</sup> 1895  
Jan 1896

755  
87m 40 ac.  
756  
87m 40 ac.

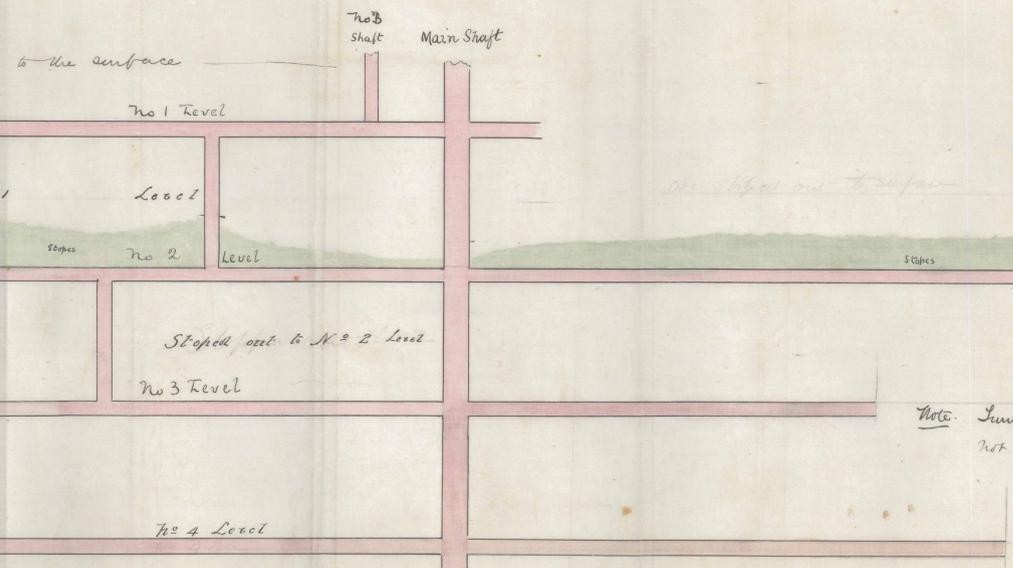

Note. Tunnel workings are not shown in section pp

