


37

5 cm

MAIN SHAFT

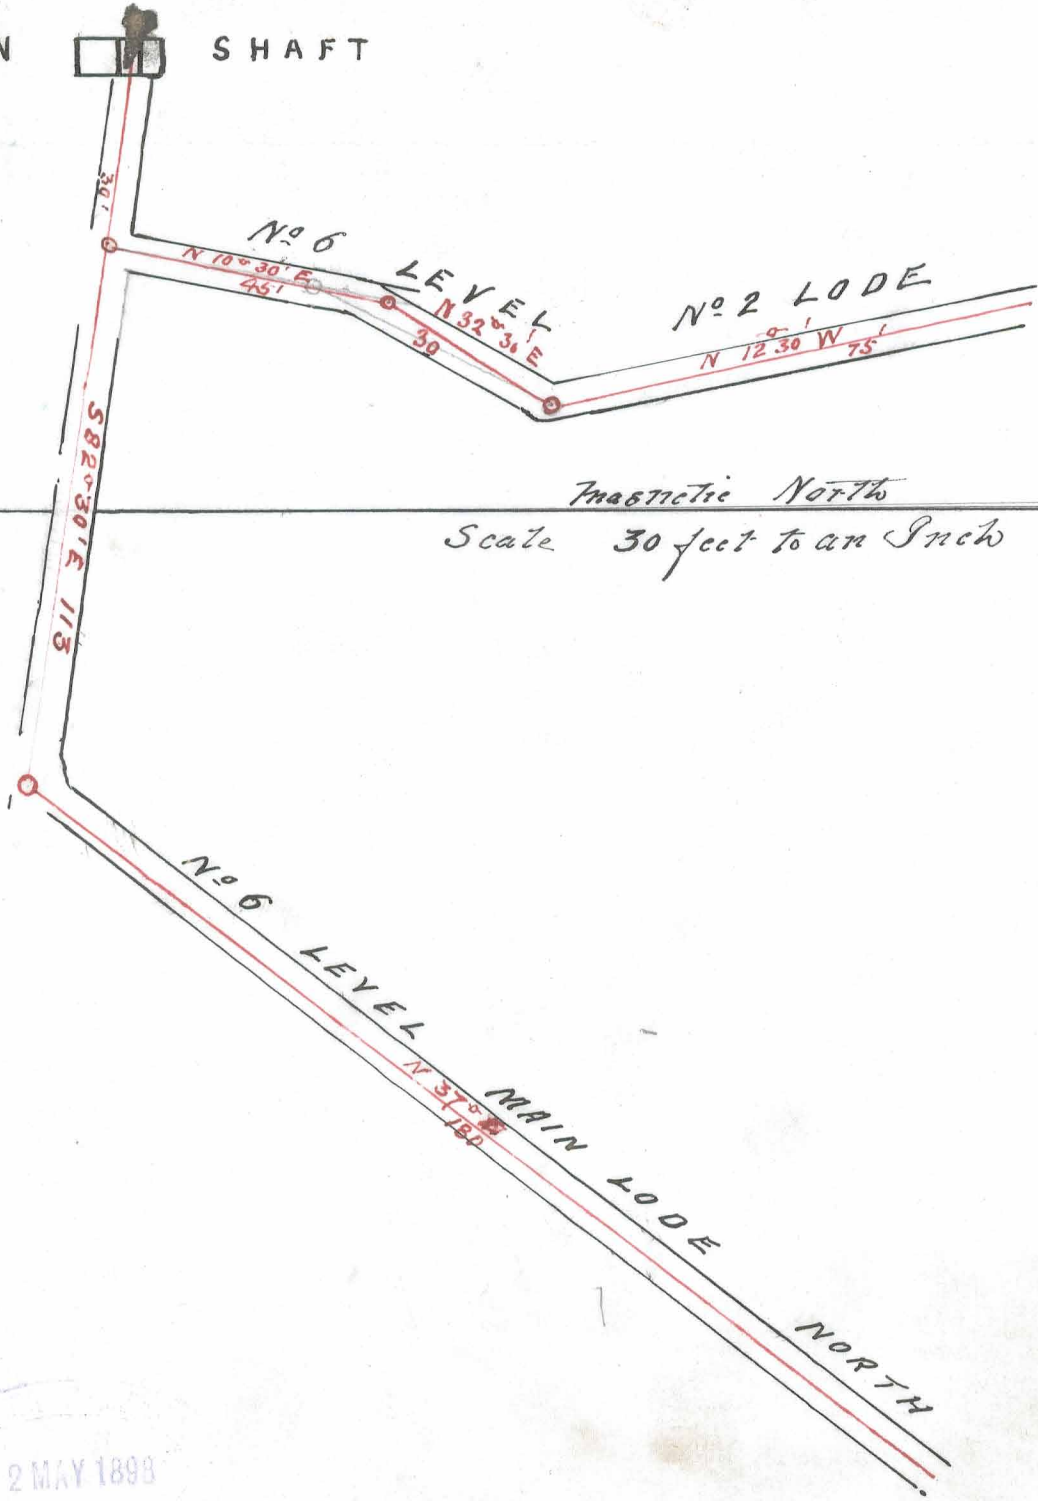

2 MAY 1898