


40

5 cm

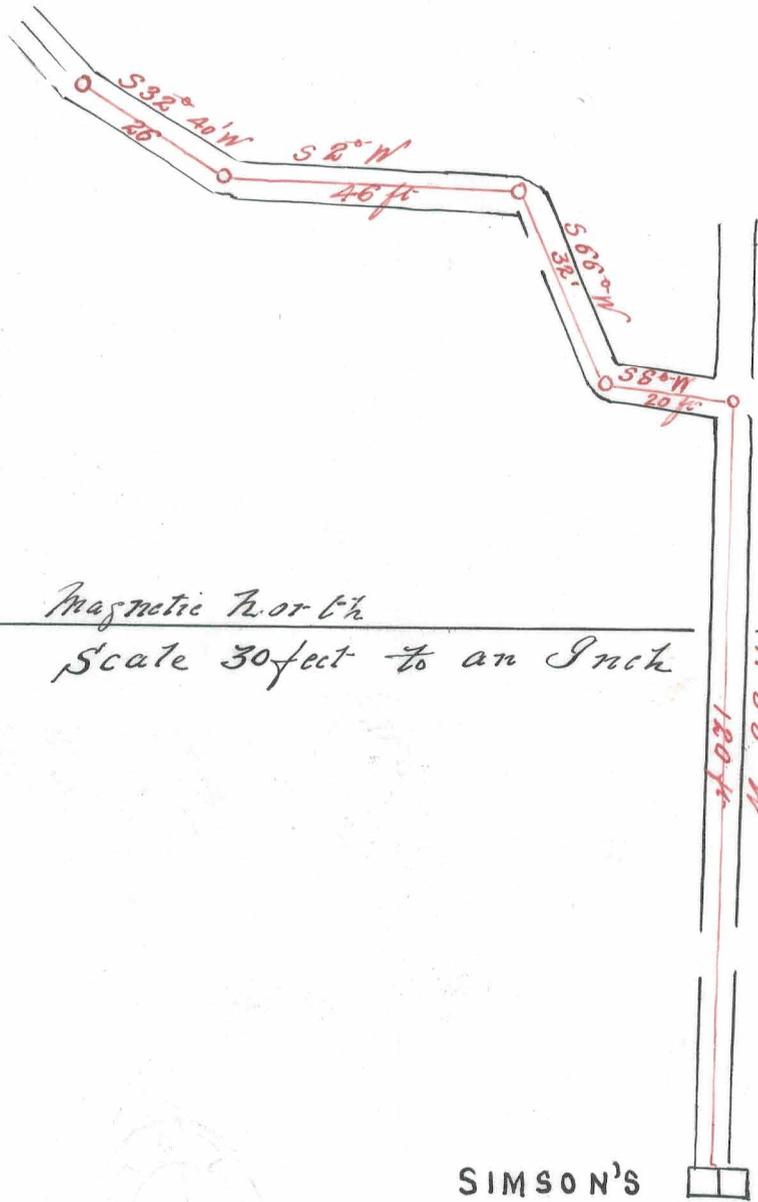

Magnetic North
Scale 30 feet to an Inch

SIMSON'S SHAFT

2 MAY 1893