


1899

12

5 cm

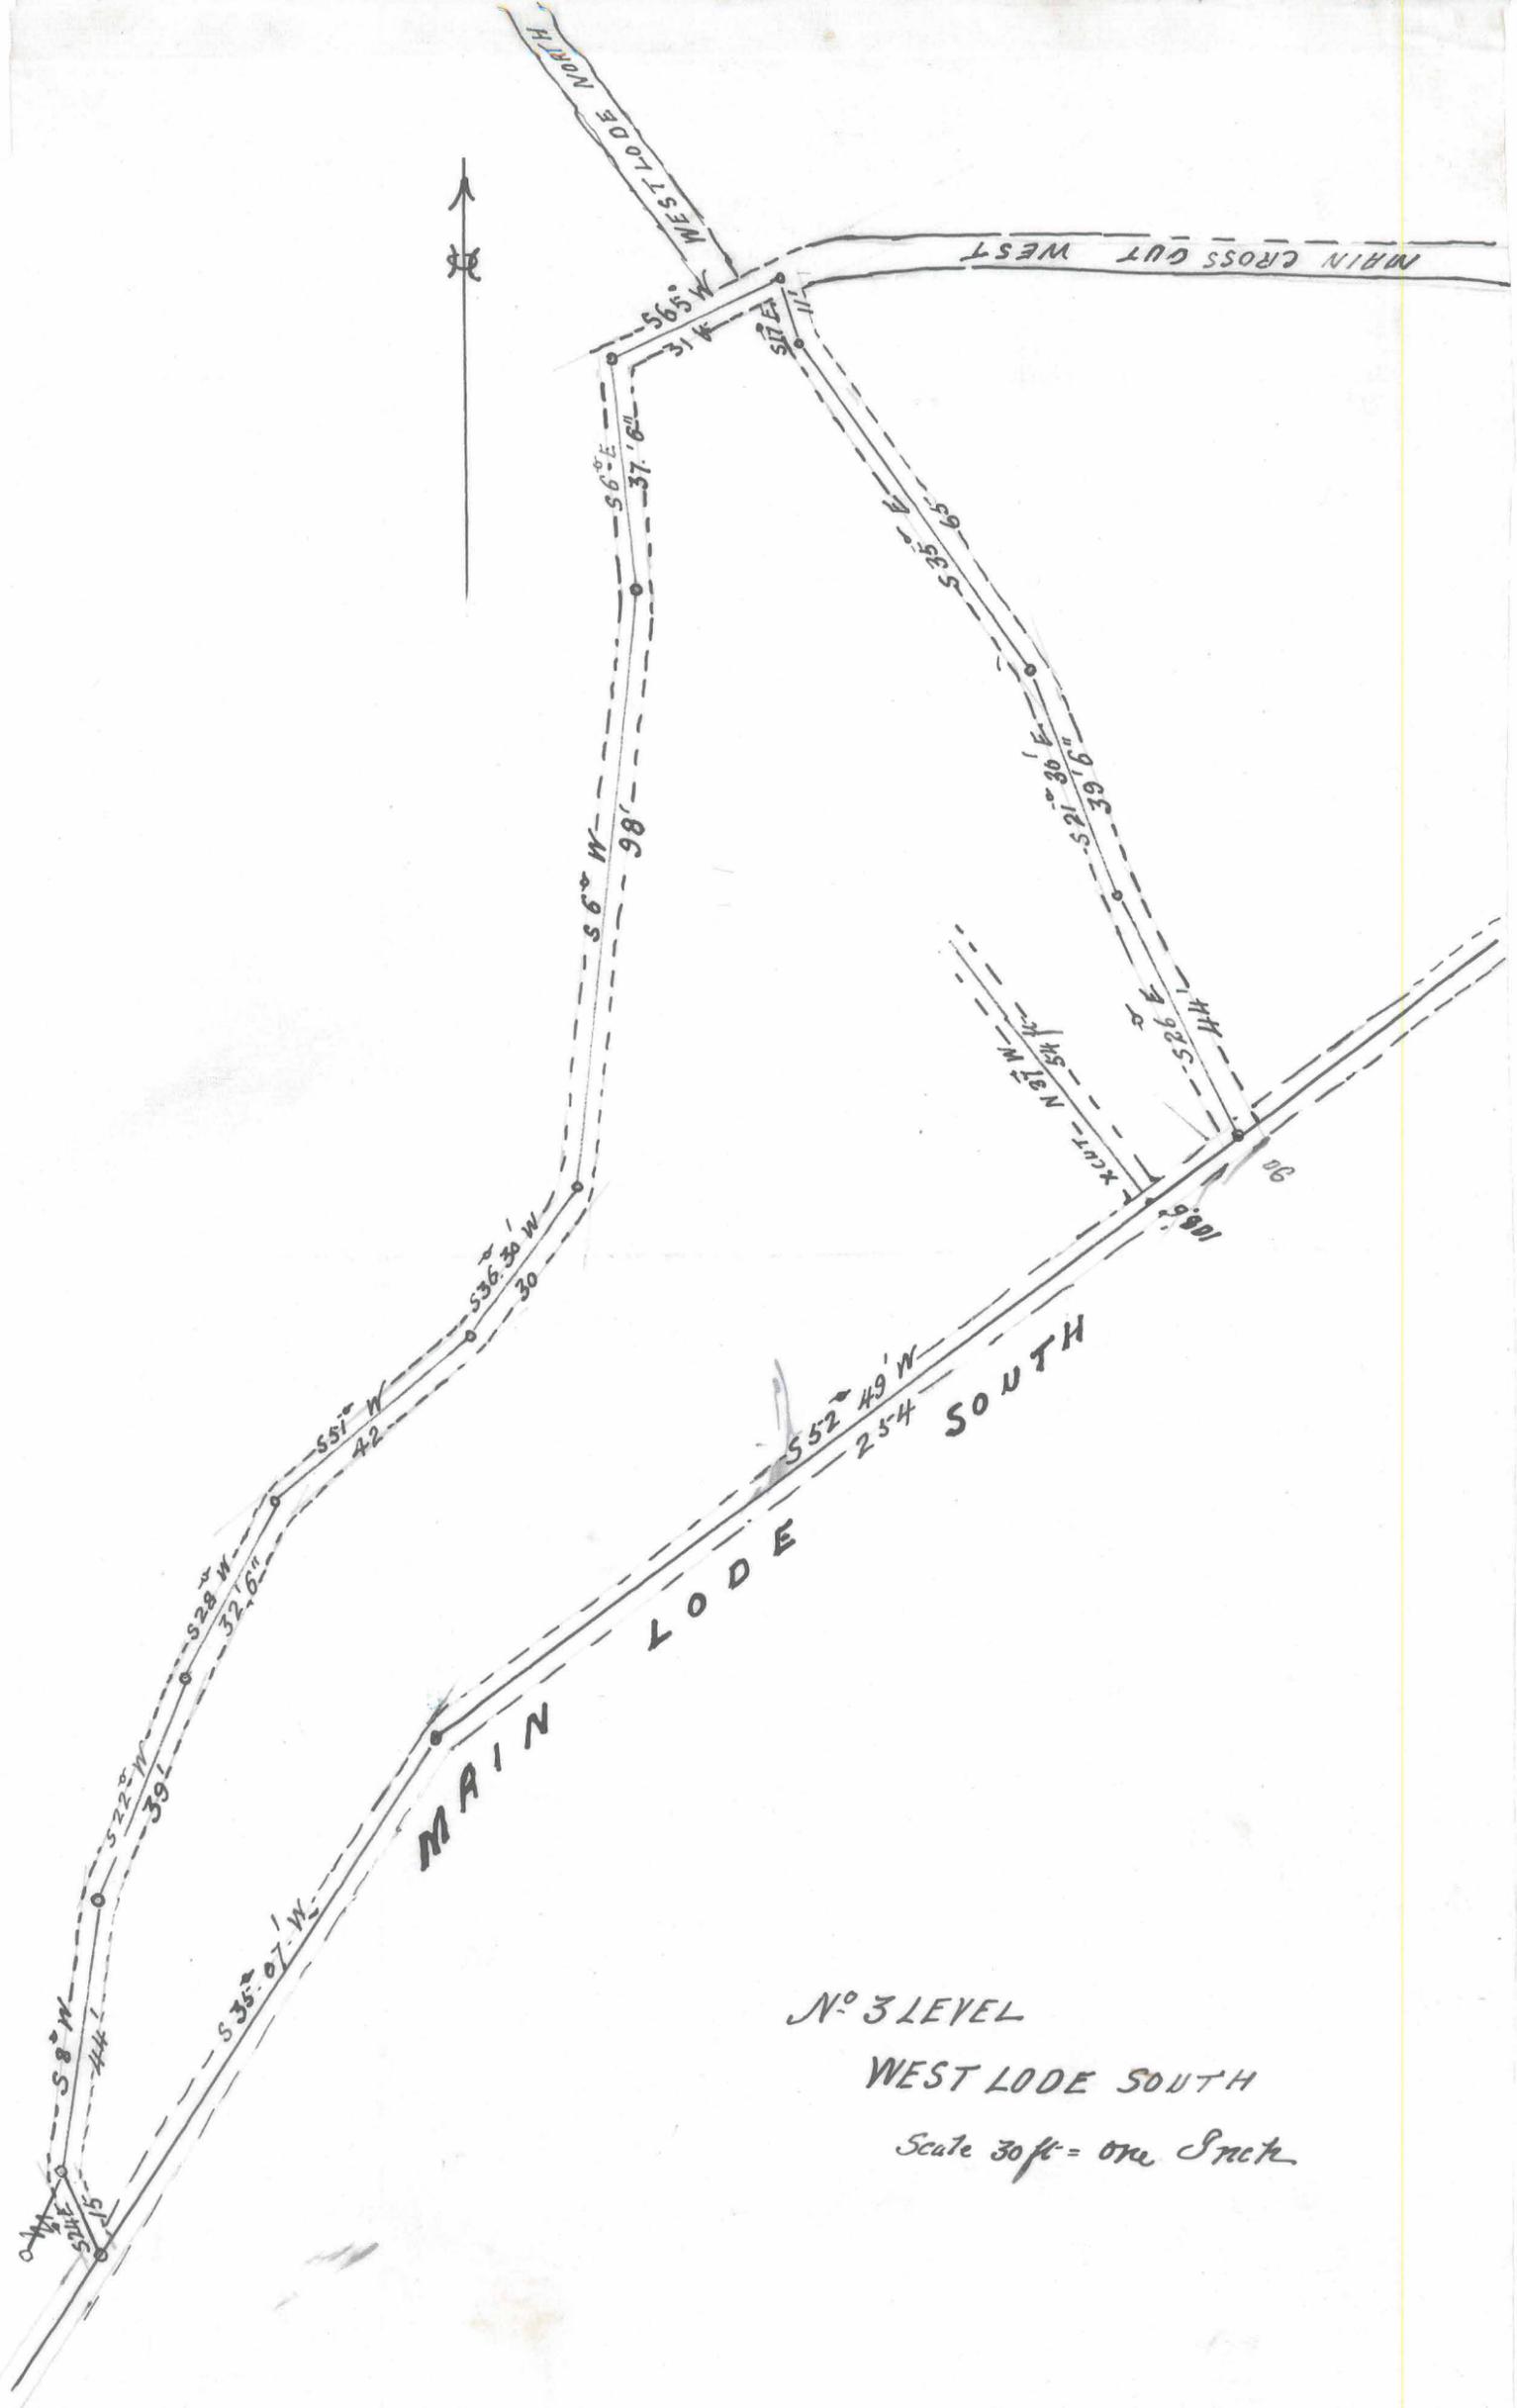

N^o 3 LEVEL
 WEST LODE SOUTH
 Scale 30ft = one Inch