


2

Scale 30' ft to an Inch

N^o 2 LODE NORTH

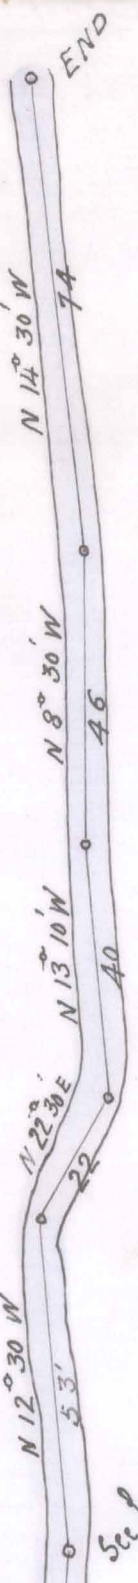

See last page plan



LEVEL

N^o 3



END

NORTH

N^o 2 LODE

N^o 4 LEVEL

END

RISE TO N^o 2

WIND TO N^o 4

N^o 3 LEVEL

N^o 2

N^o 3 LEVEL

N^o 2

