


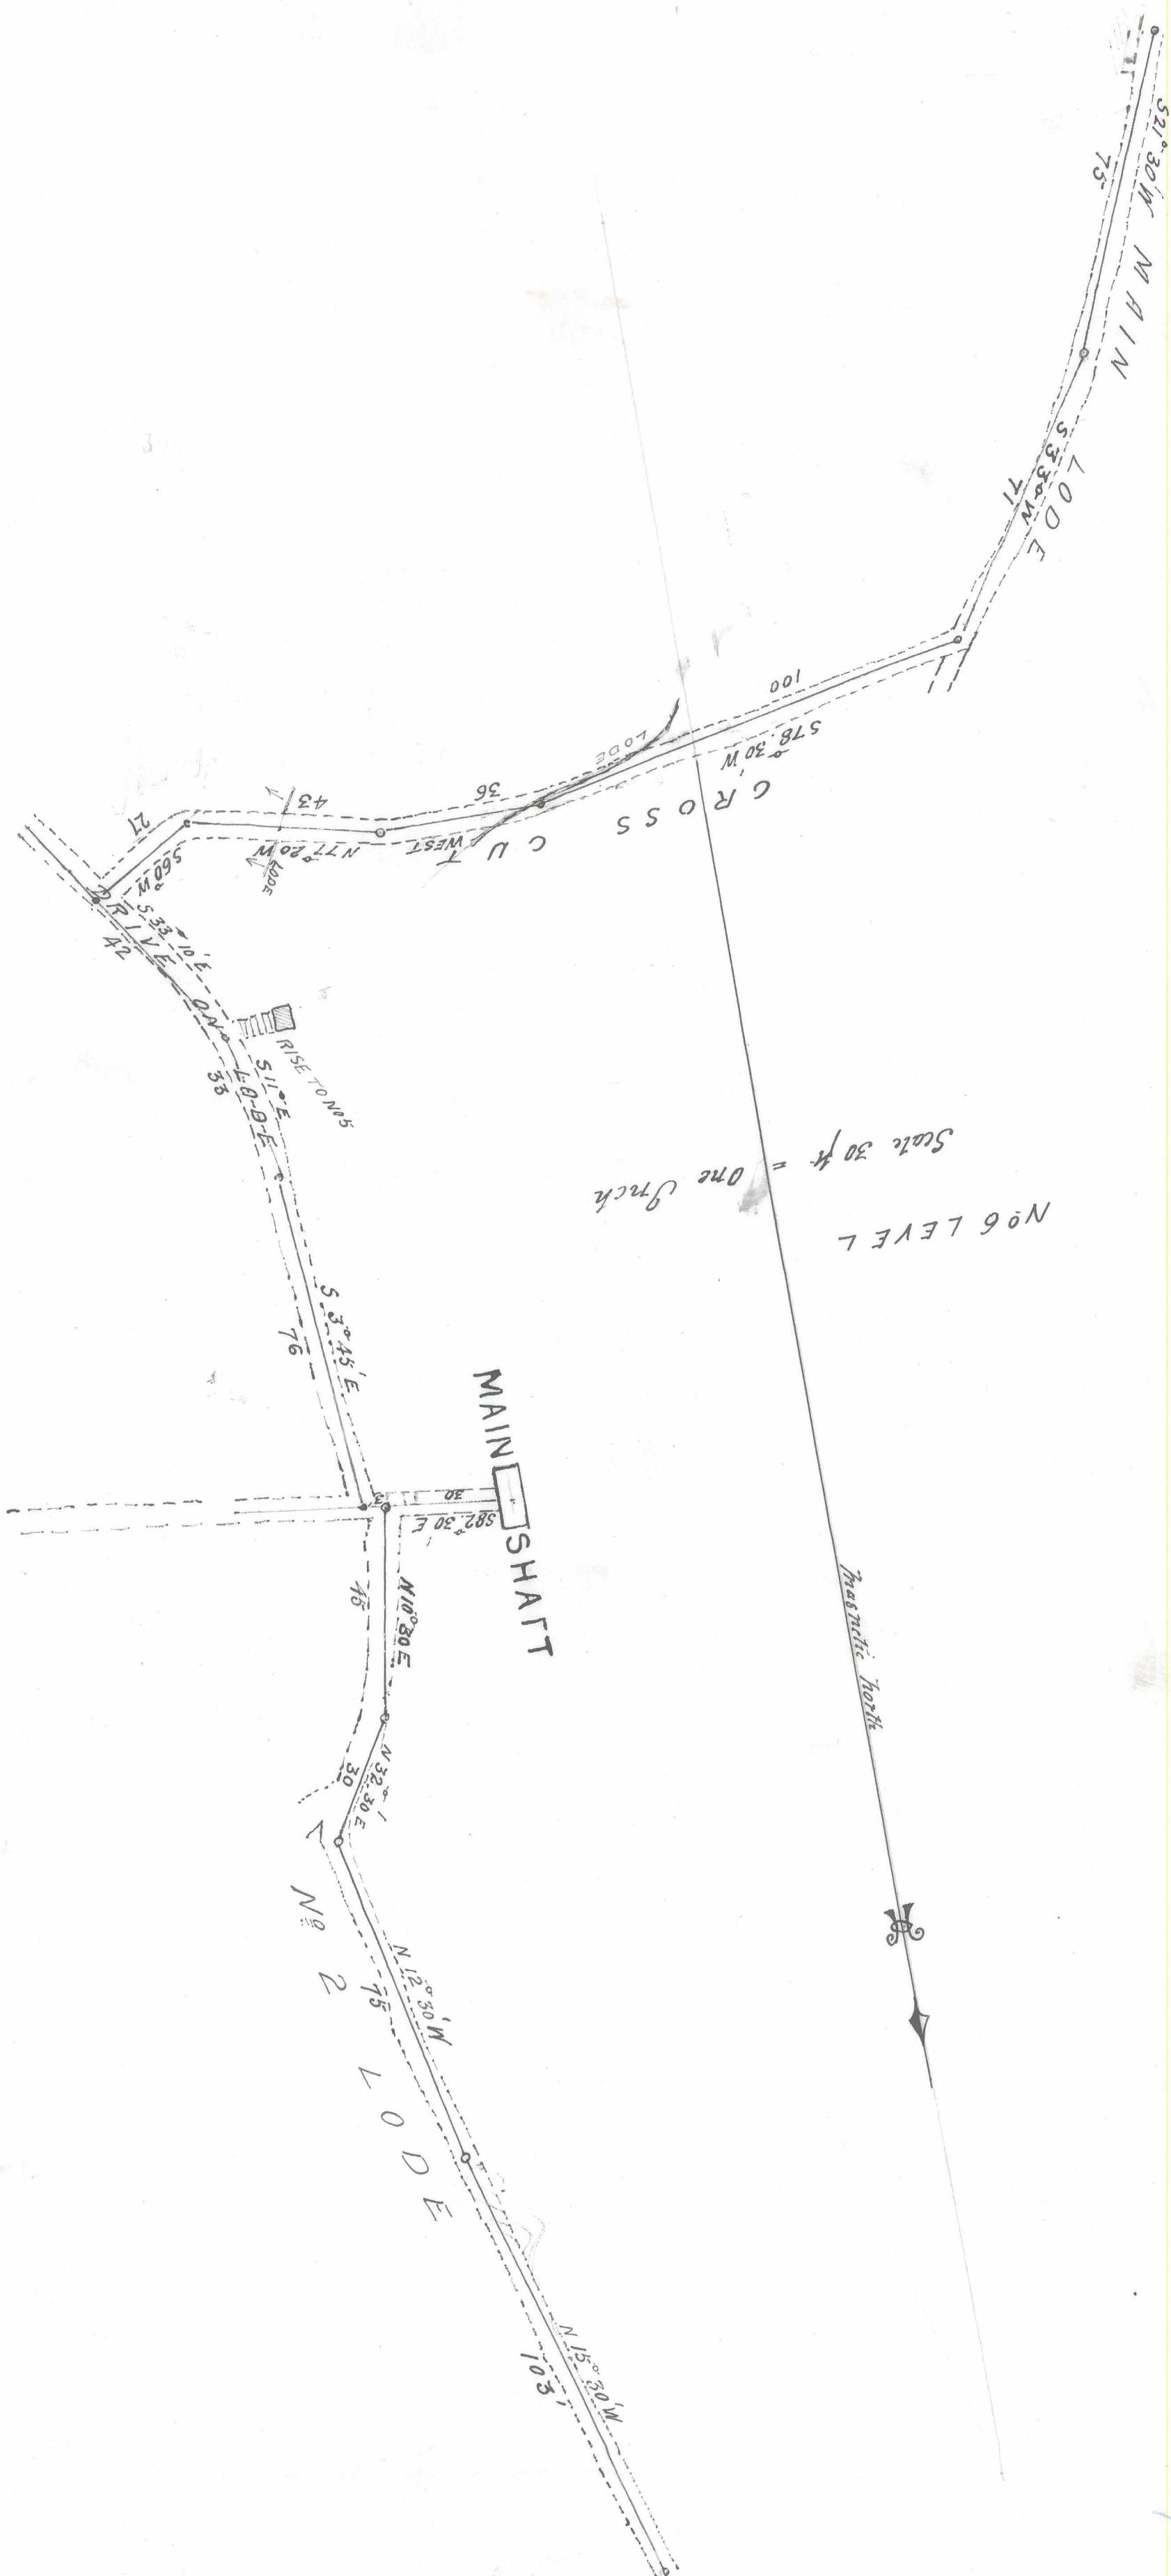

Nº 6 LEVEL

One Inch

Magnetic North

