


Magnetic North

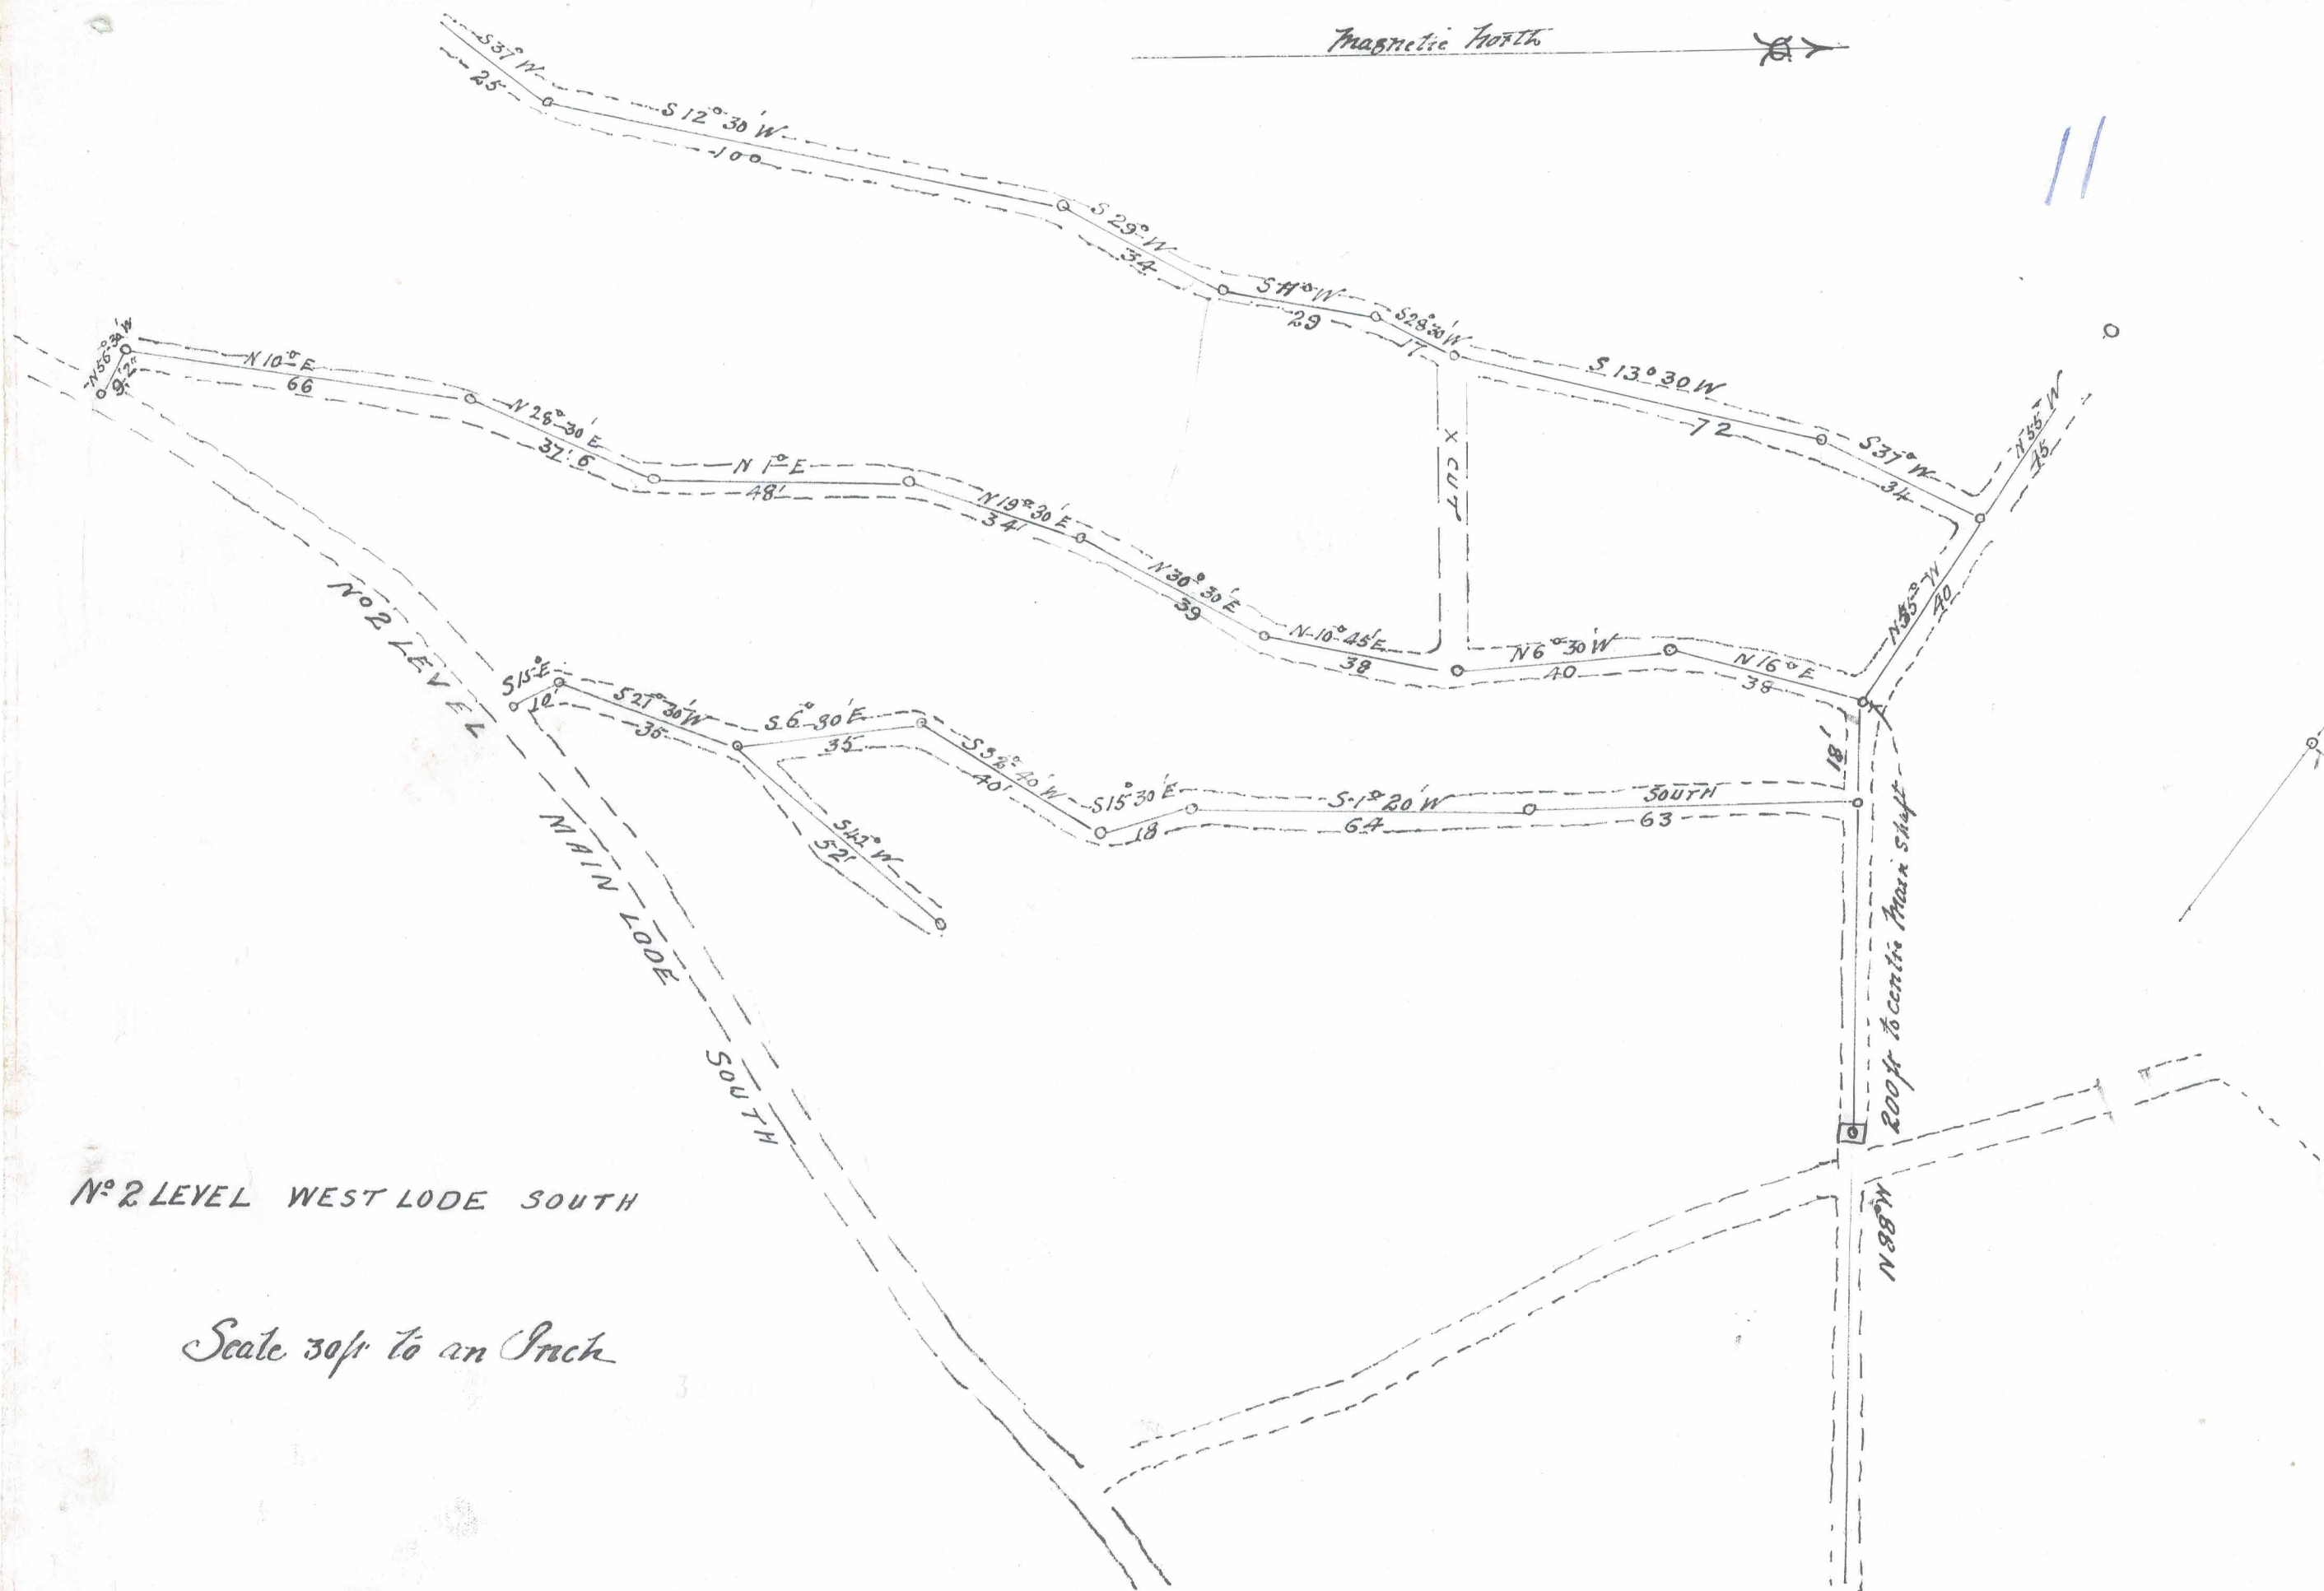

Nº 2 LEVEL WEST LODGE SOUTH

Scale 30 ft to an Inch