

REFERENCE

Nº1 LEVEL 45 FEET DEEP

- 2 110
- 3 170
- 4 230
- 5 290
- 6 360
- 7 430
- 8 500
- 9 600
- 10

MAIN SHAFT

724 FT ABOVE SEA LEVEL

Nº1 TUNNEL 32 Feet Surface at Main Shaft


- 2 72 " " " "
- 3 20 above surface at Main Shaft

Nº1 LEVEL 70

- 2 170

SIMMONS SHAFT

692 FT ABOVE SEA LEVEL

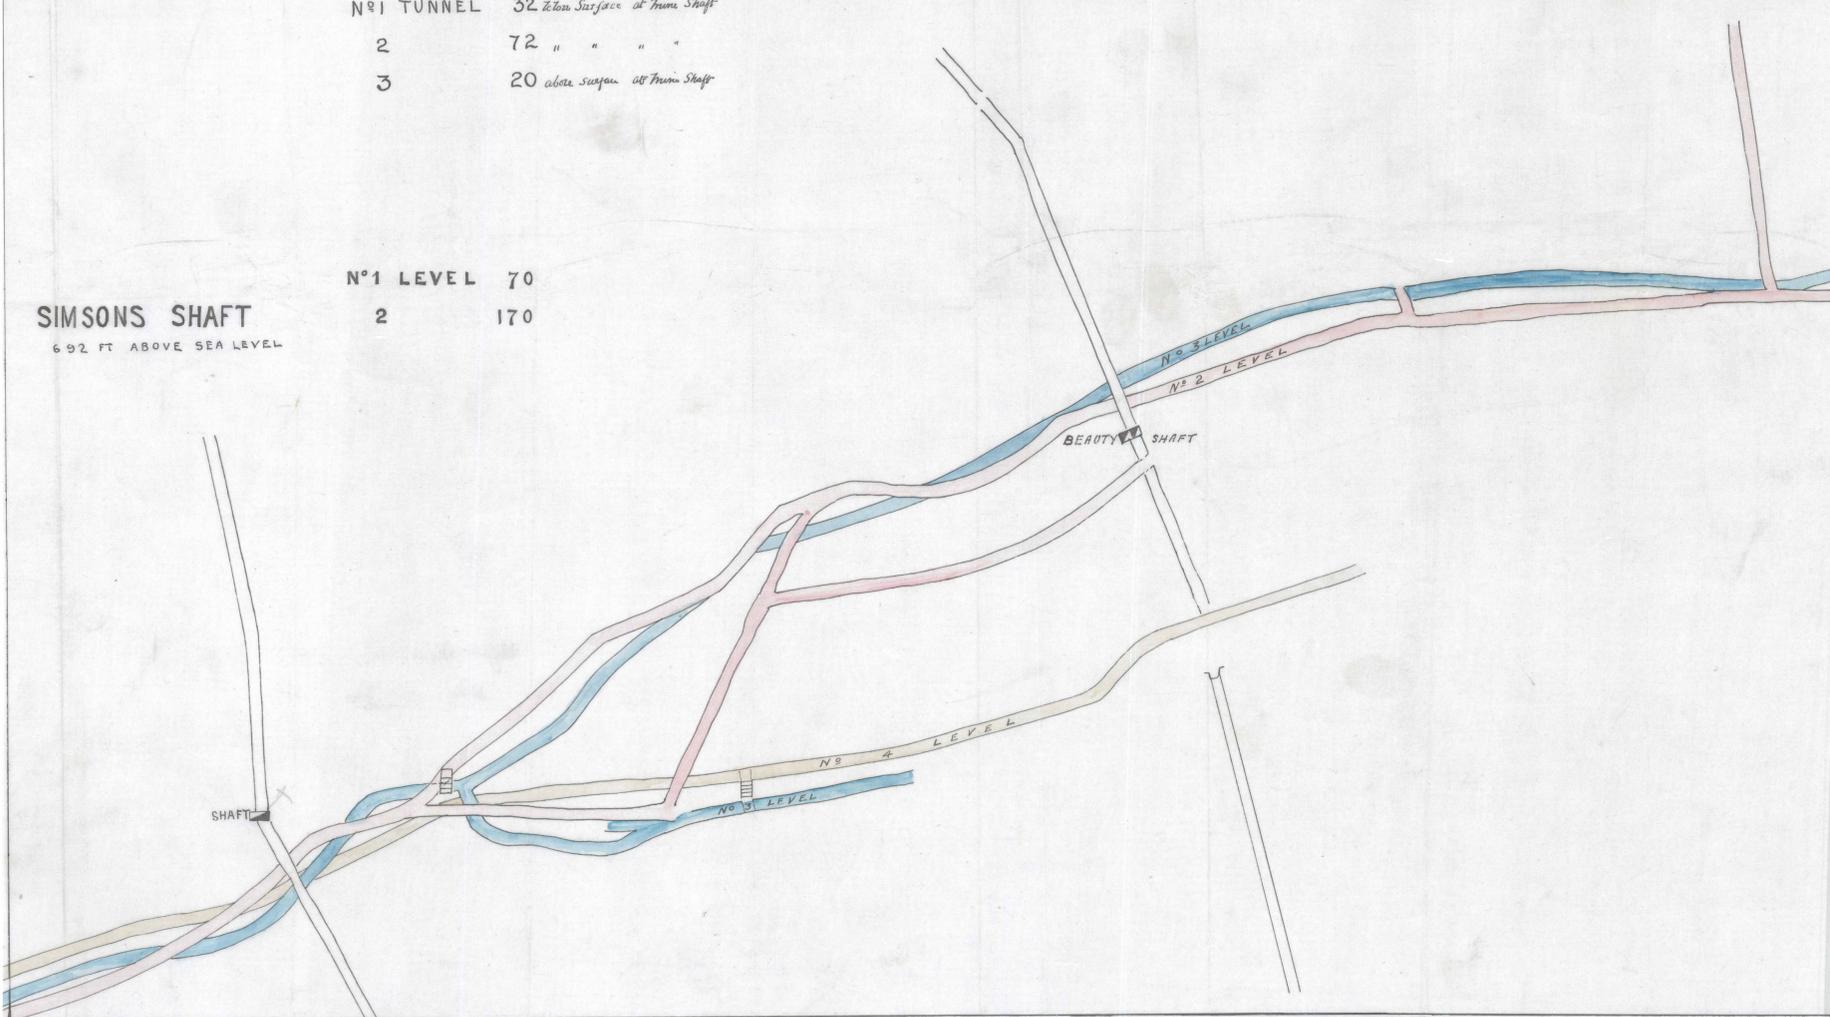

ML

MLNº 756  
87 M

II

