


5 cm

43

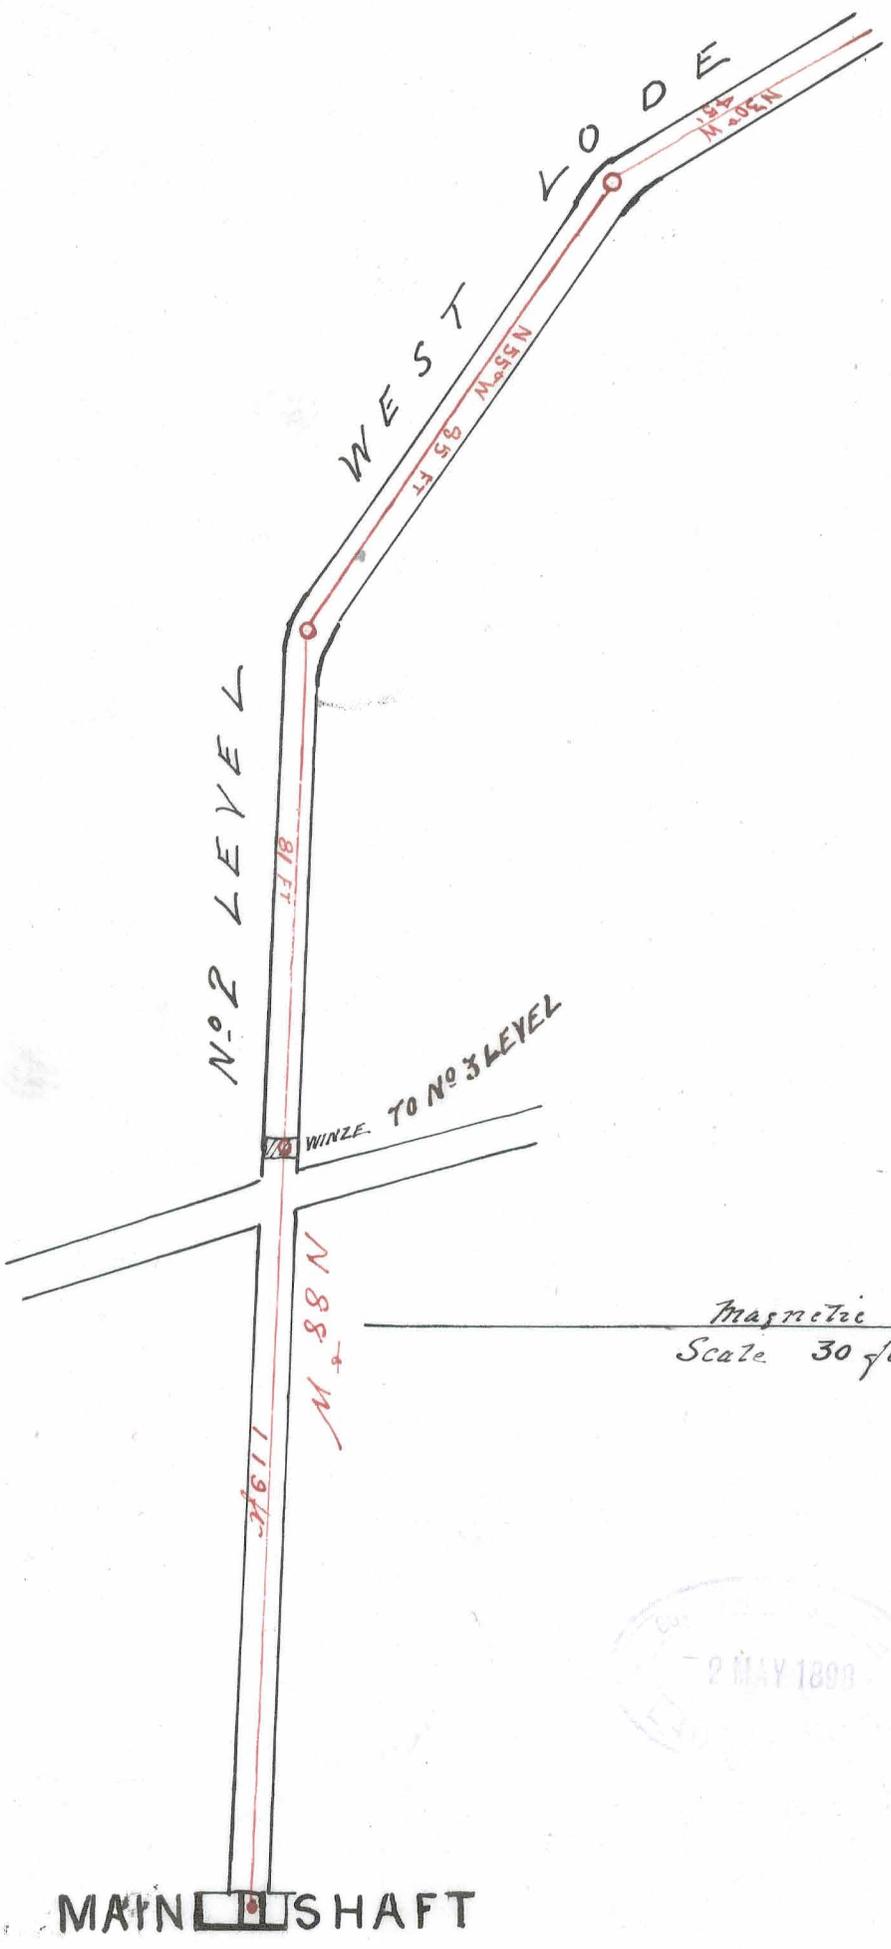

1890

25

2 MAY 1890