


WESTERN

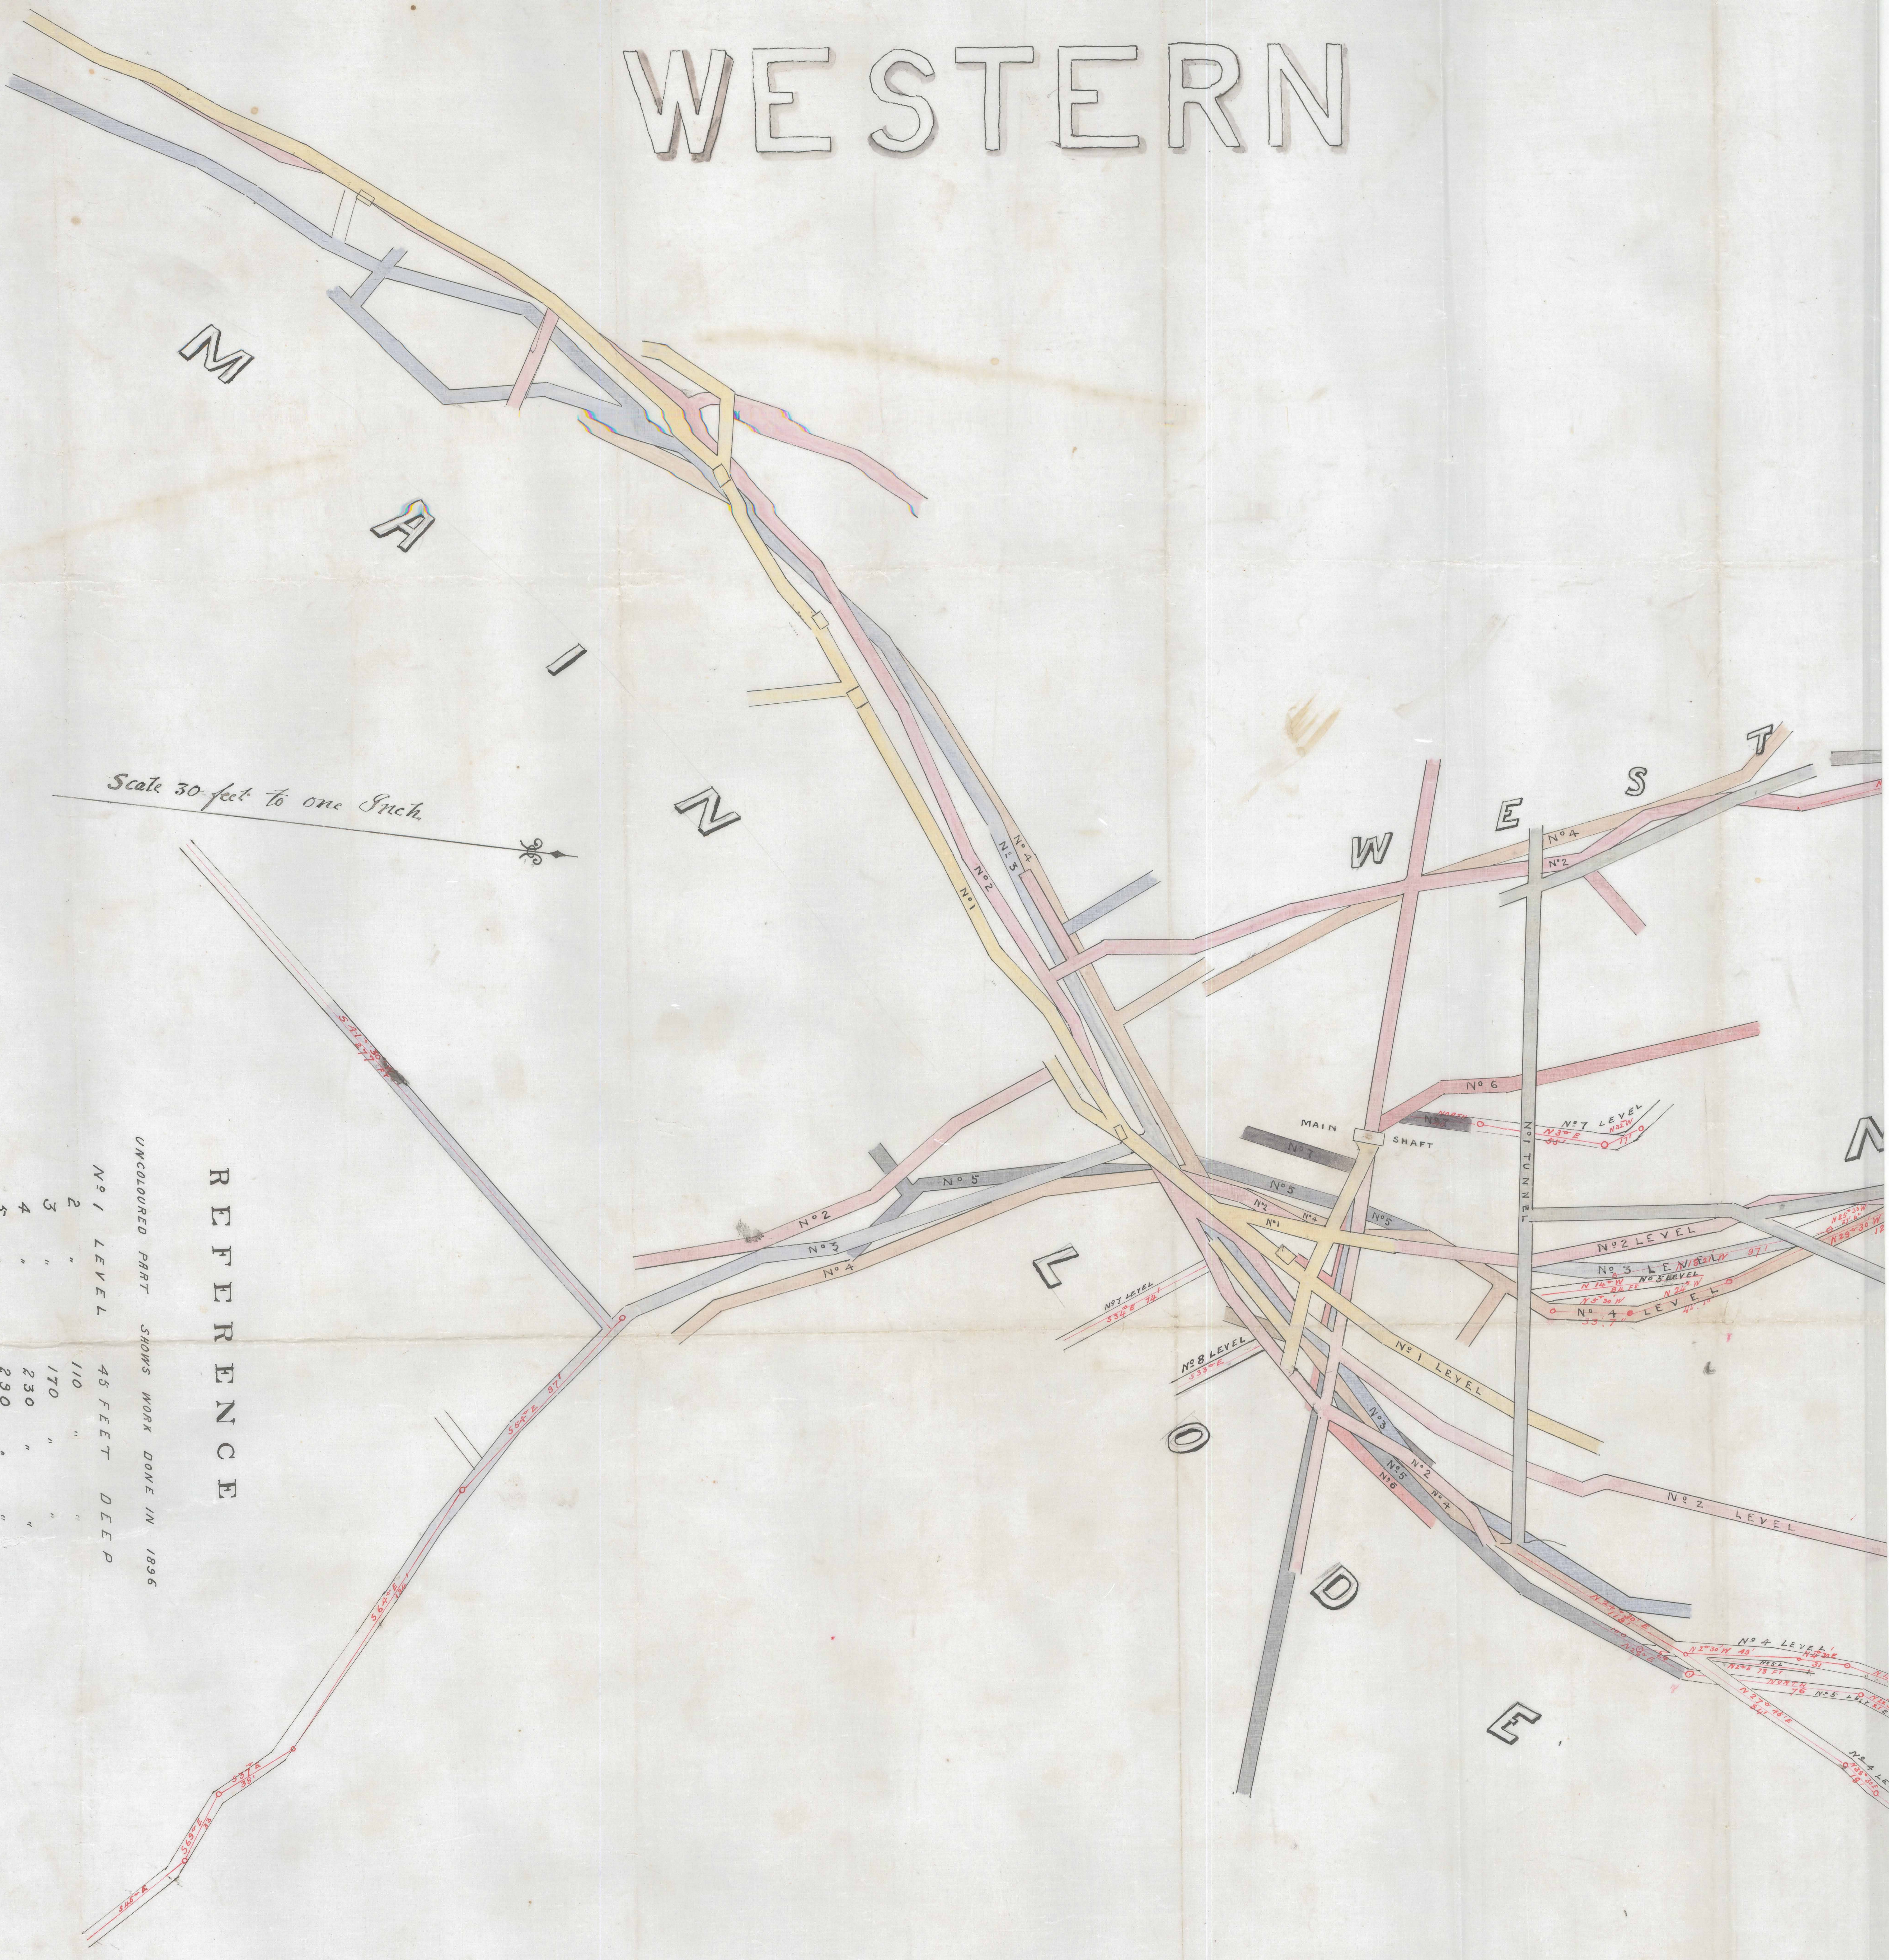

Scale 30 feet to one inch.

REFERENCE

UNCOLOURED PART SHOWS WORK DONE IN 1896

No. 1 LEVEL	45 FEET DEEP
2	110
3	170
4	230
5	290
6	360
7	430
8	500

East boundary of T55 87M