



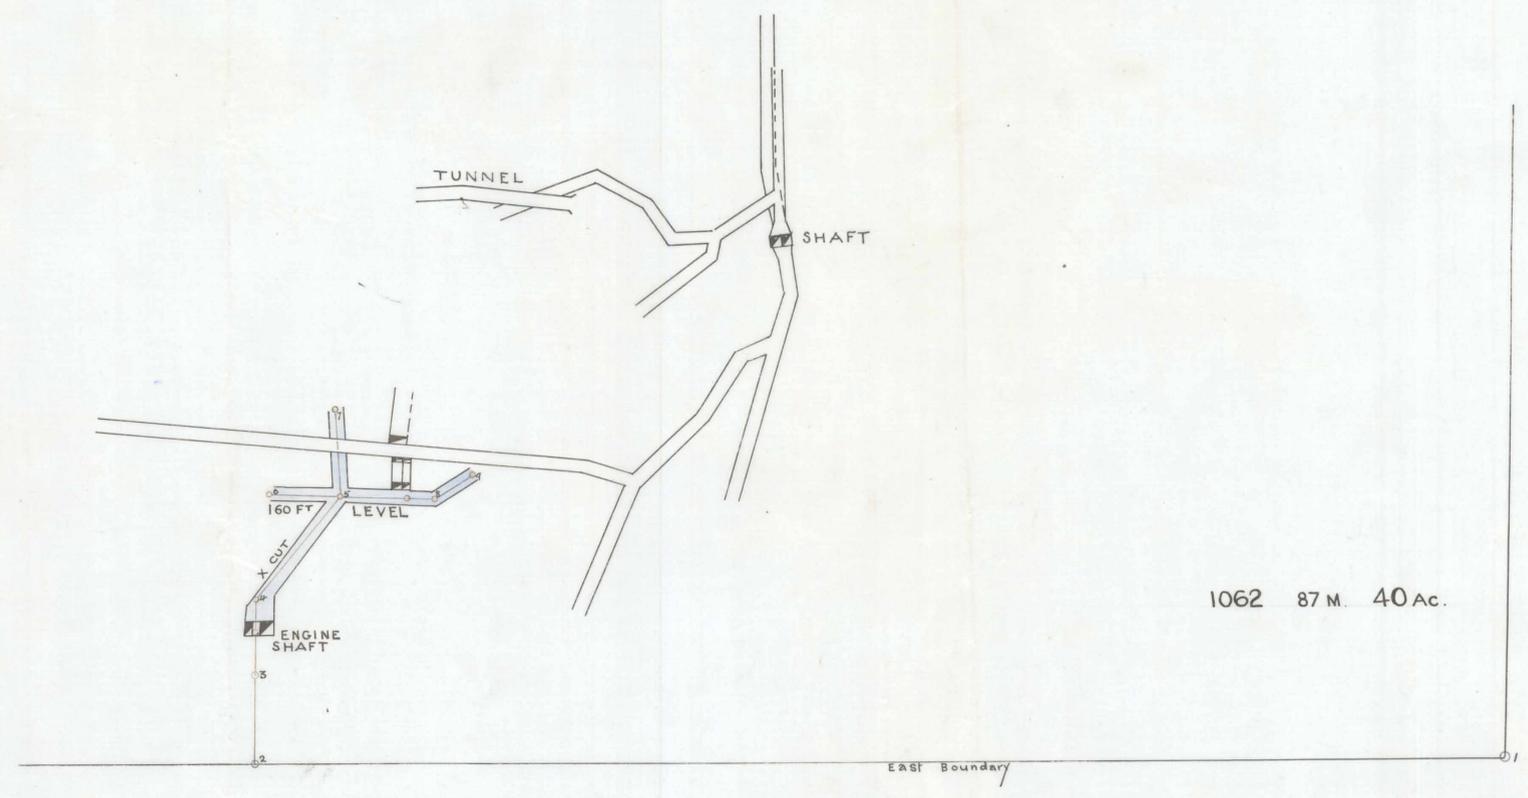


Section on Course of Lode

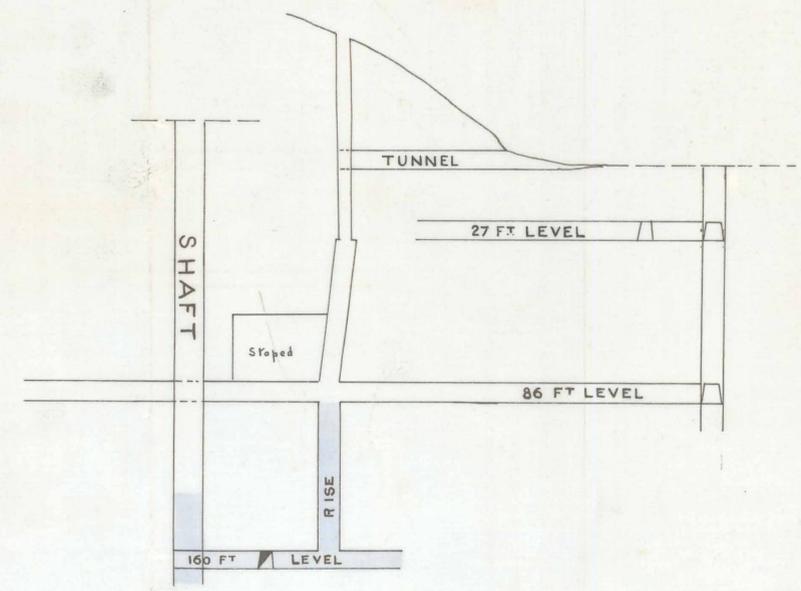

1062 87 M. 40 Ac.

— WESTERN EX<sup>TD</sup> S M COY —

— Scale 30 ft to 1 inch —

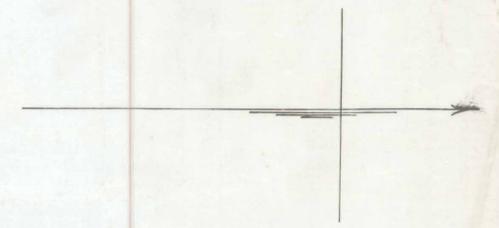

Western Extension