



- ZEEHAN-WESTERN LTD -

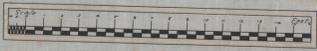

Scale 30 feet

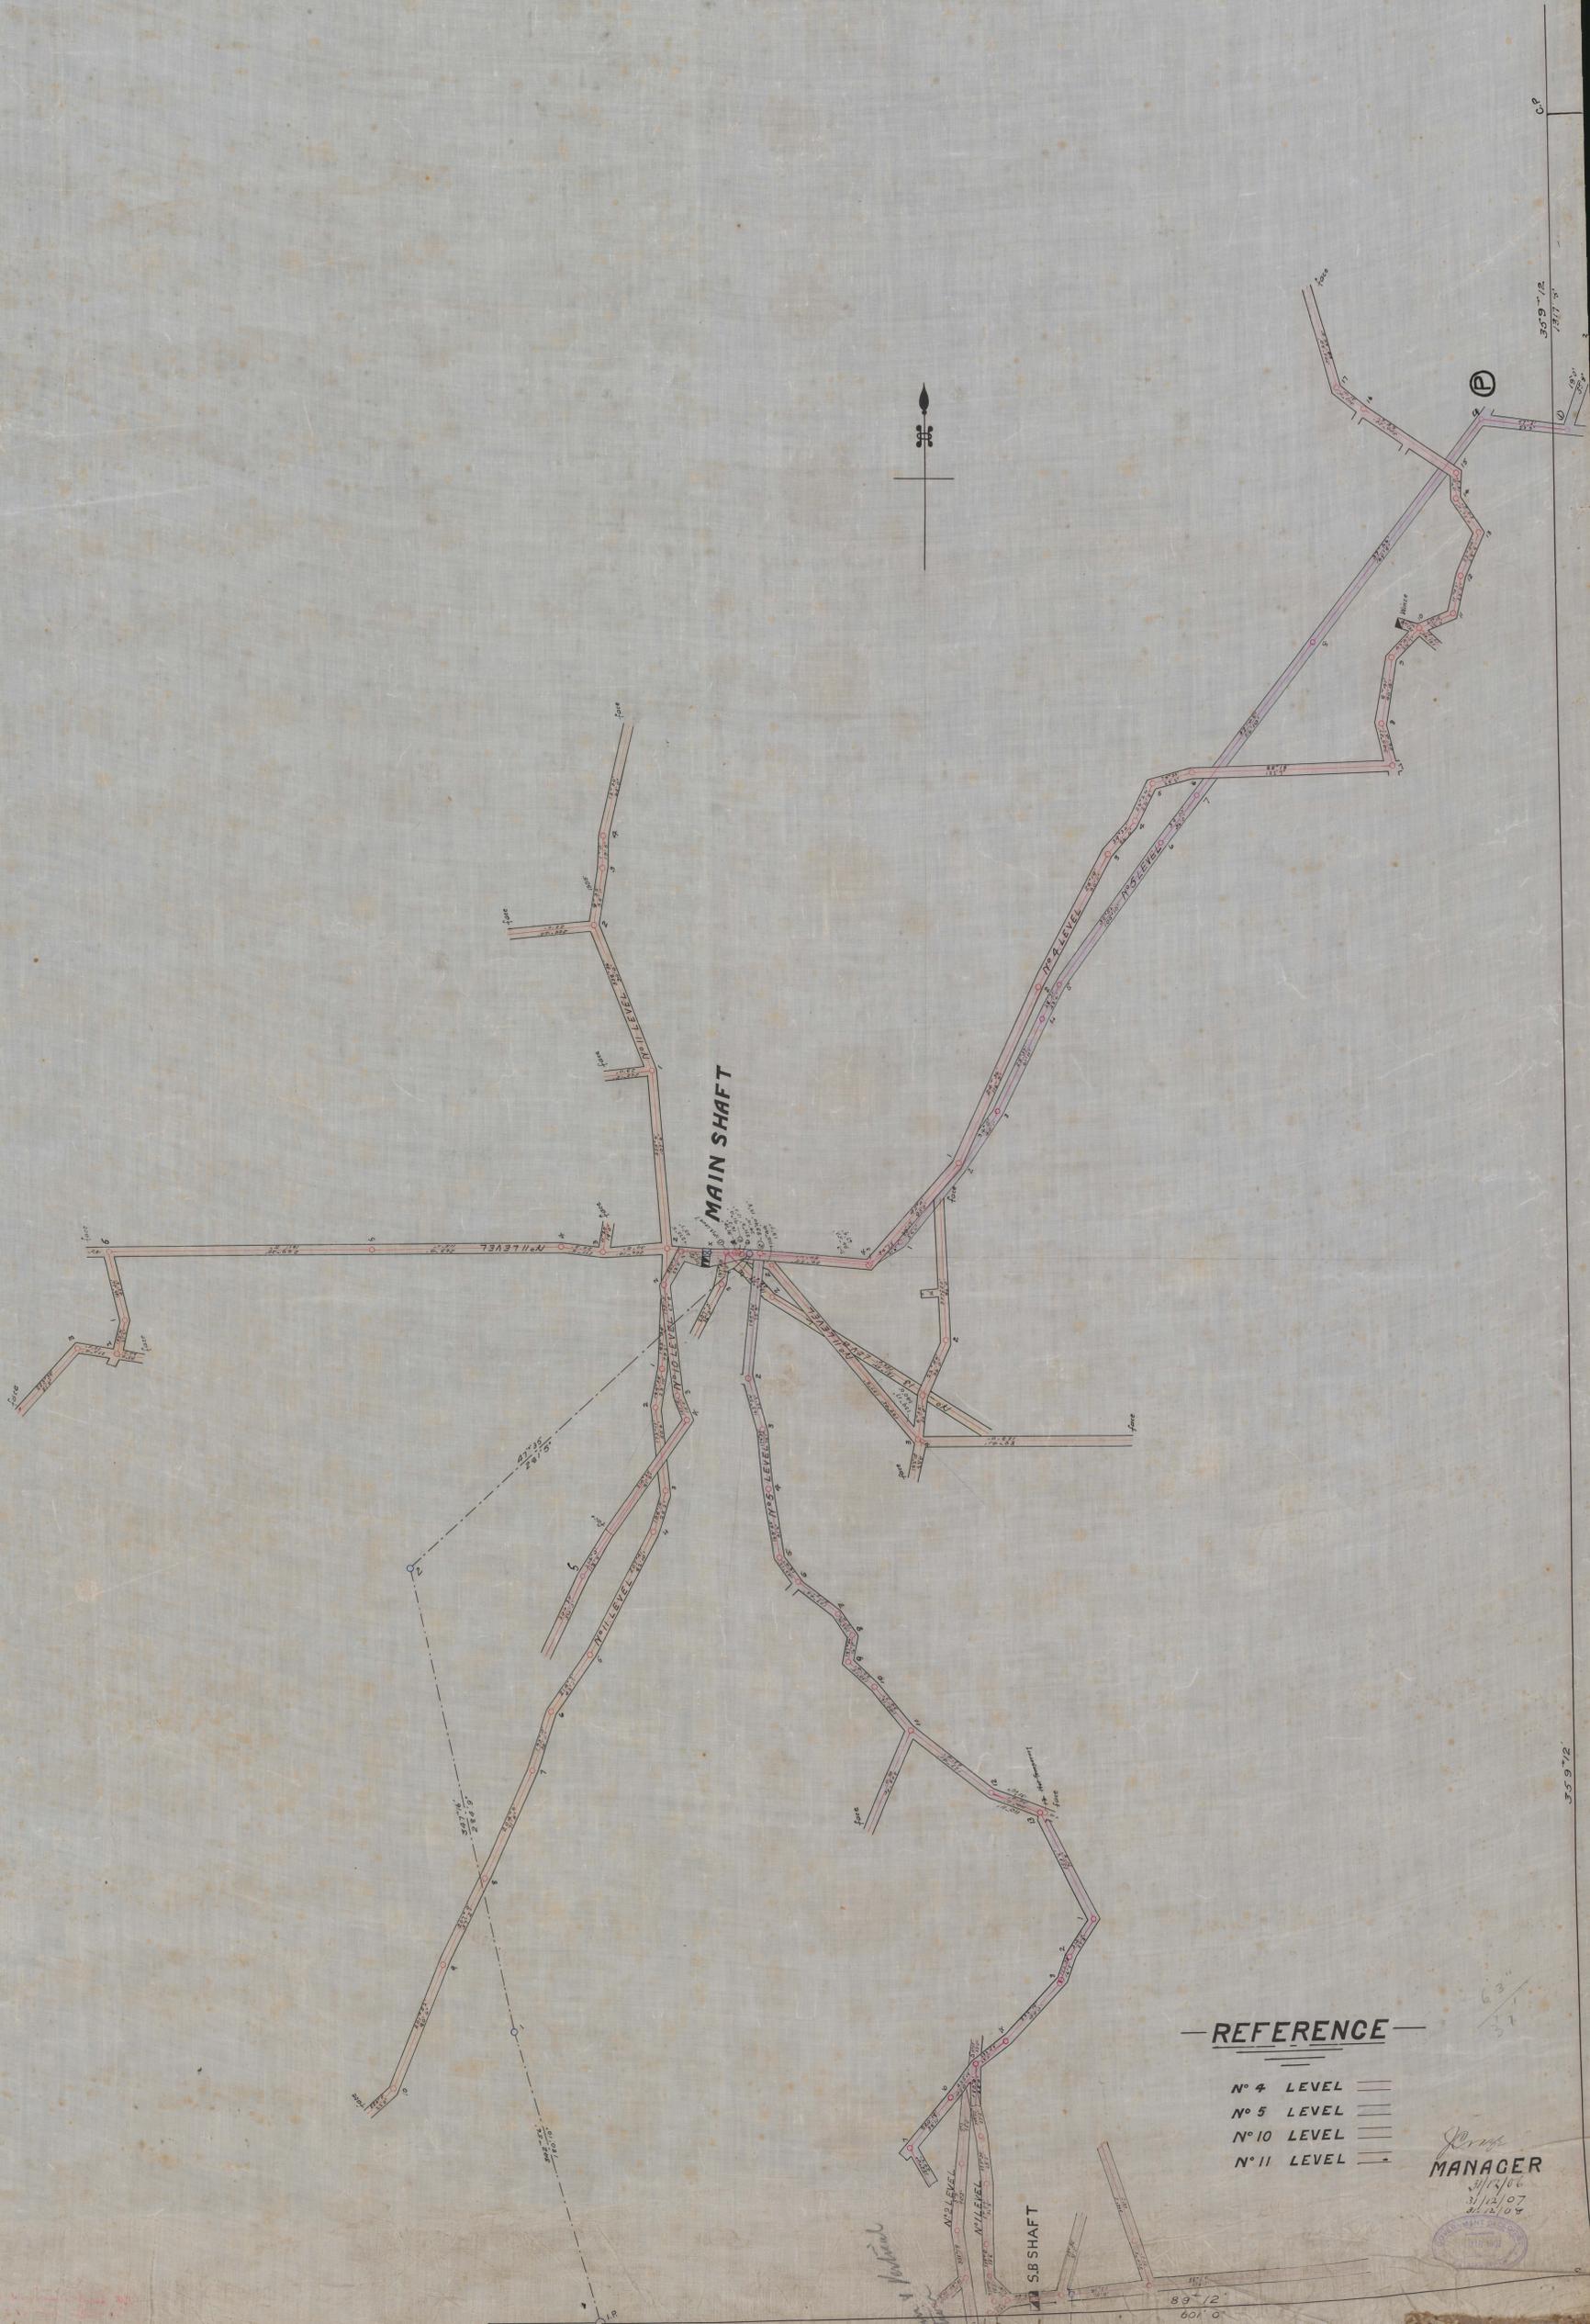

REFERENCE

- N° 4 LEVEL
- N° 5 LEVEL
- N° 10 LEVEL
- N° 11 LEVEL

Dr. J. P. ...
MANAGER
3/12/06
3/12/07
3/12/08



335-001