


335-02

CHANDLER-WESTERN LIMITED

146
41

SECTION ON E & W LINE THROUGH SHAFT
SCALE 

1" = 30 feet

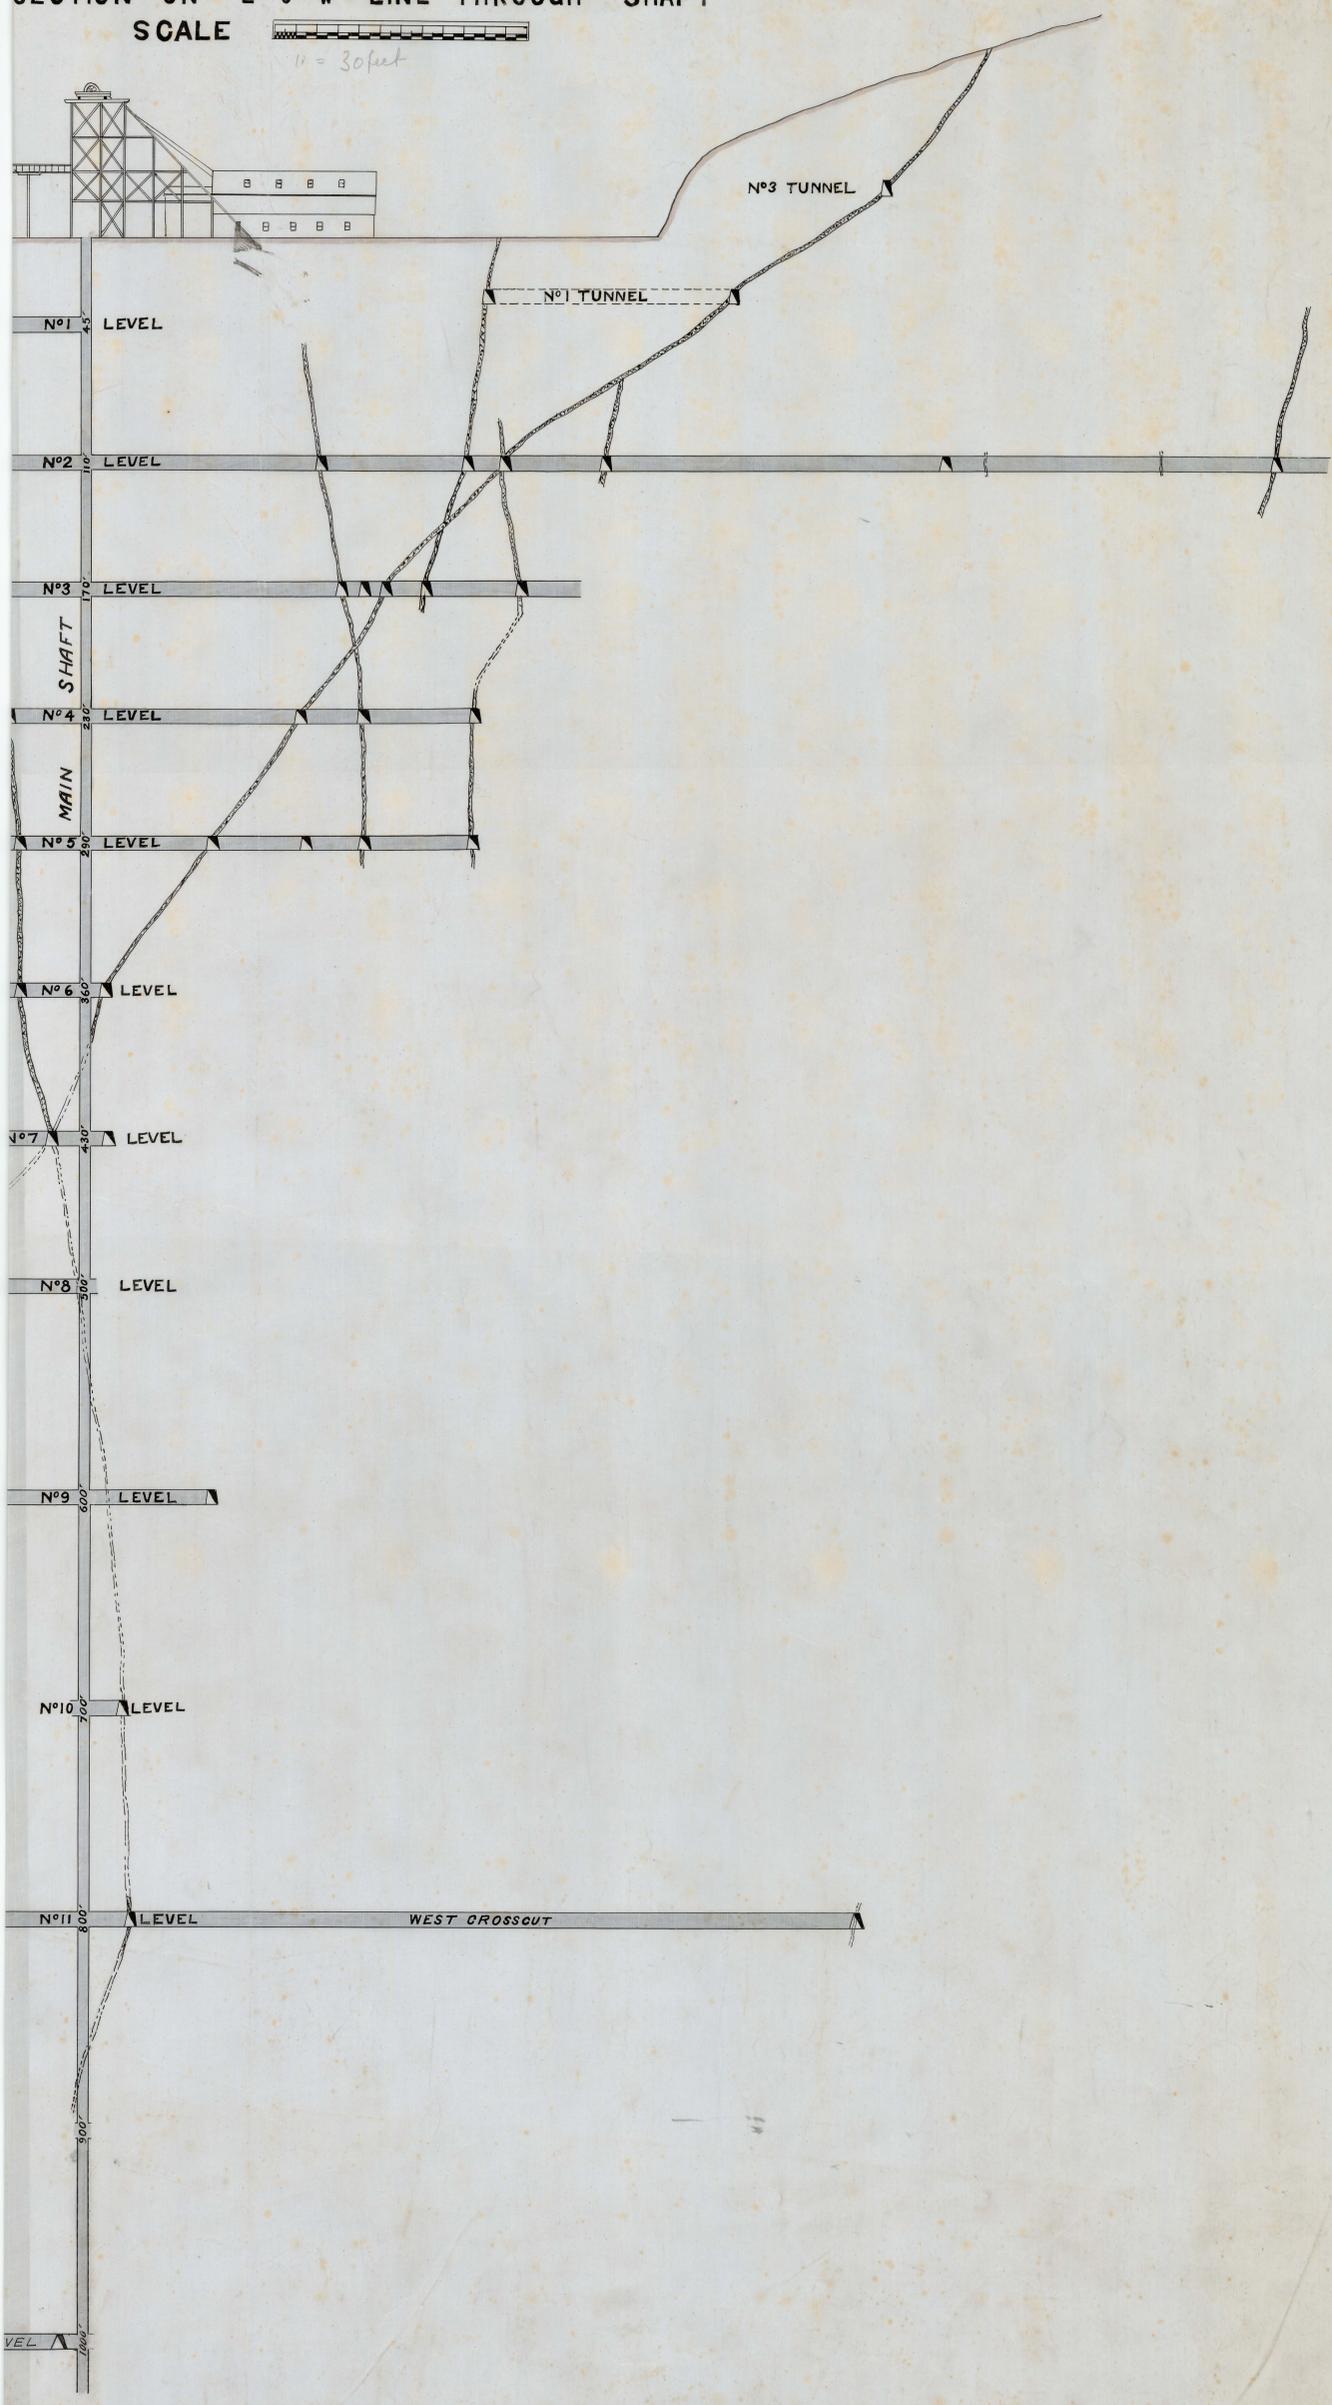

W

00NAH.S.L.C. N° L 118
819 M
87

CHANDLER-WESTERN

J. P. ...
MANAGER

Dec 31 1907
Dec 31 1908