
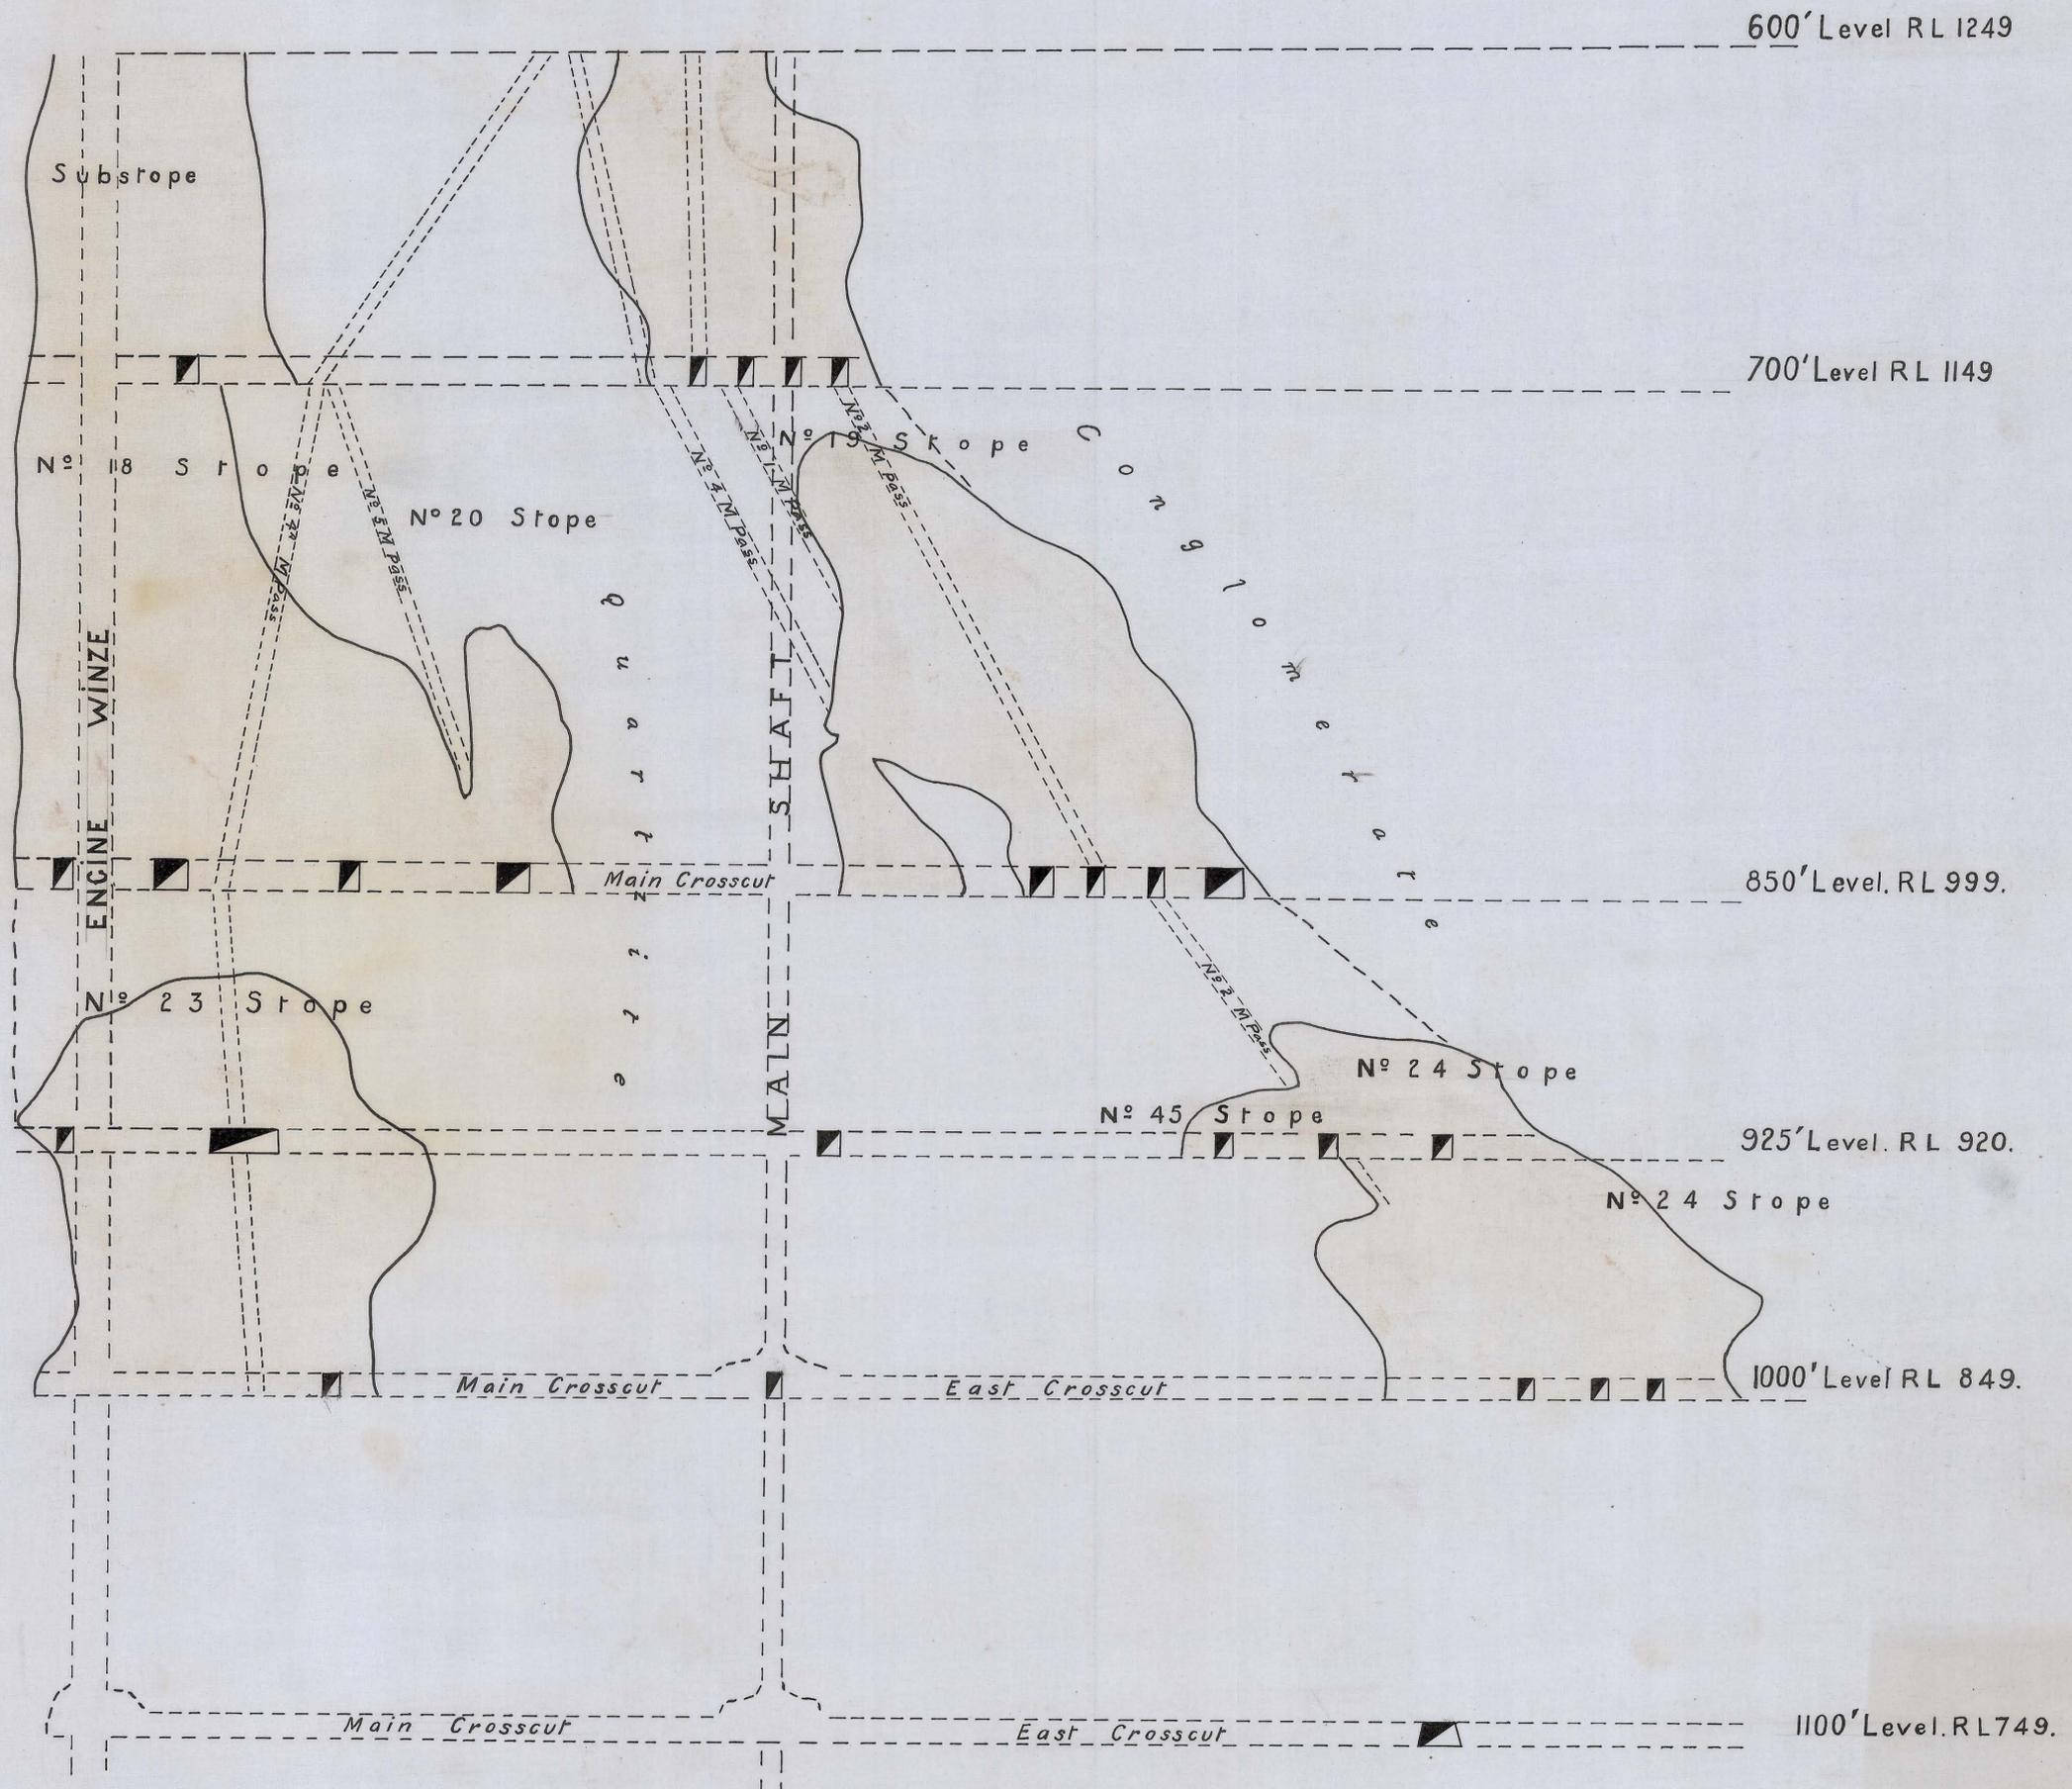


336
03

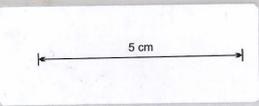

The Mount Lyell Mining & Railway Co Ltd.

Mine Department.

NORTH LYELL MINE.
Section on Line BB looking North.

Brought up to Dec 31st 1920
Scale 1" = 30'

Robt. Light General Manager
R. Williams Engineer-in-Charge.