
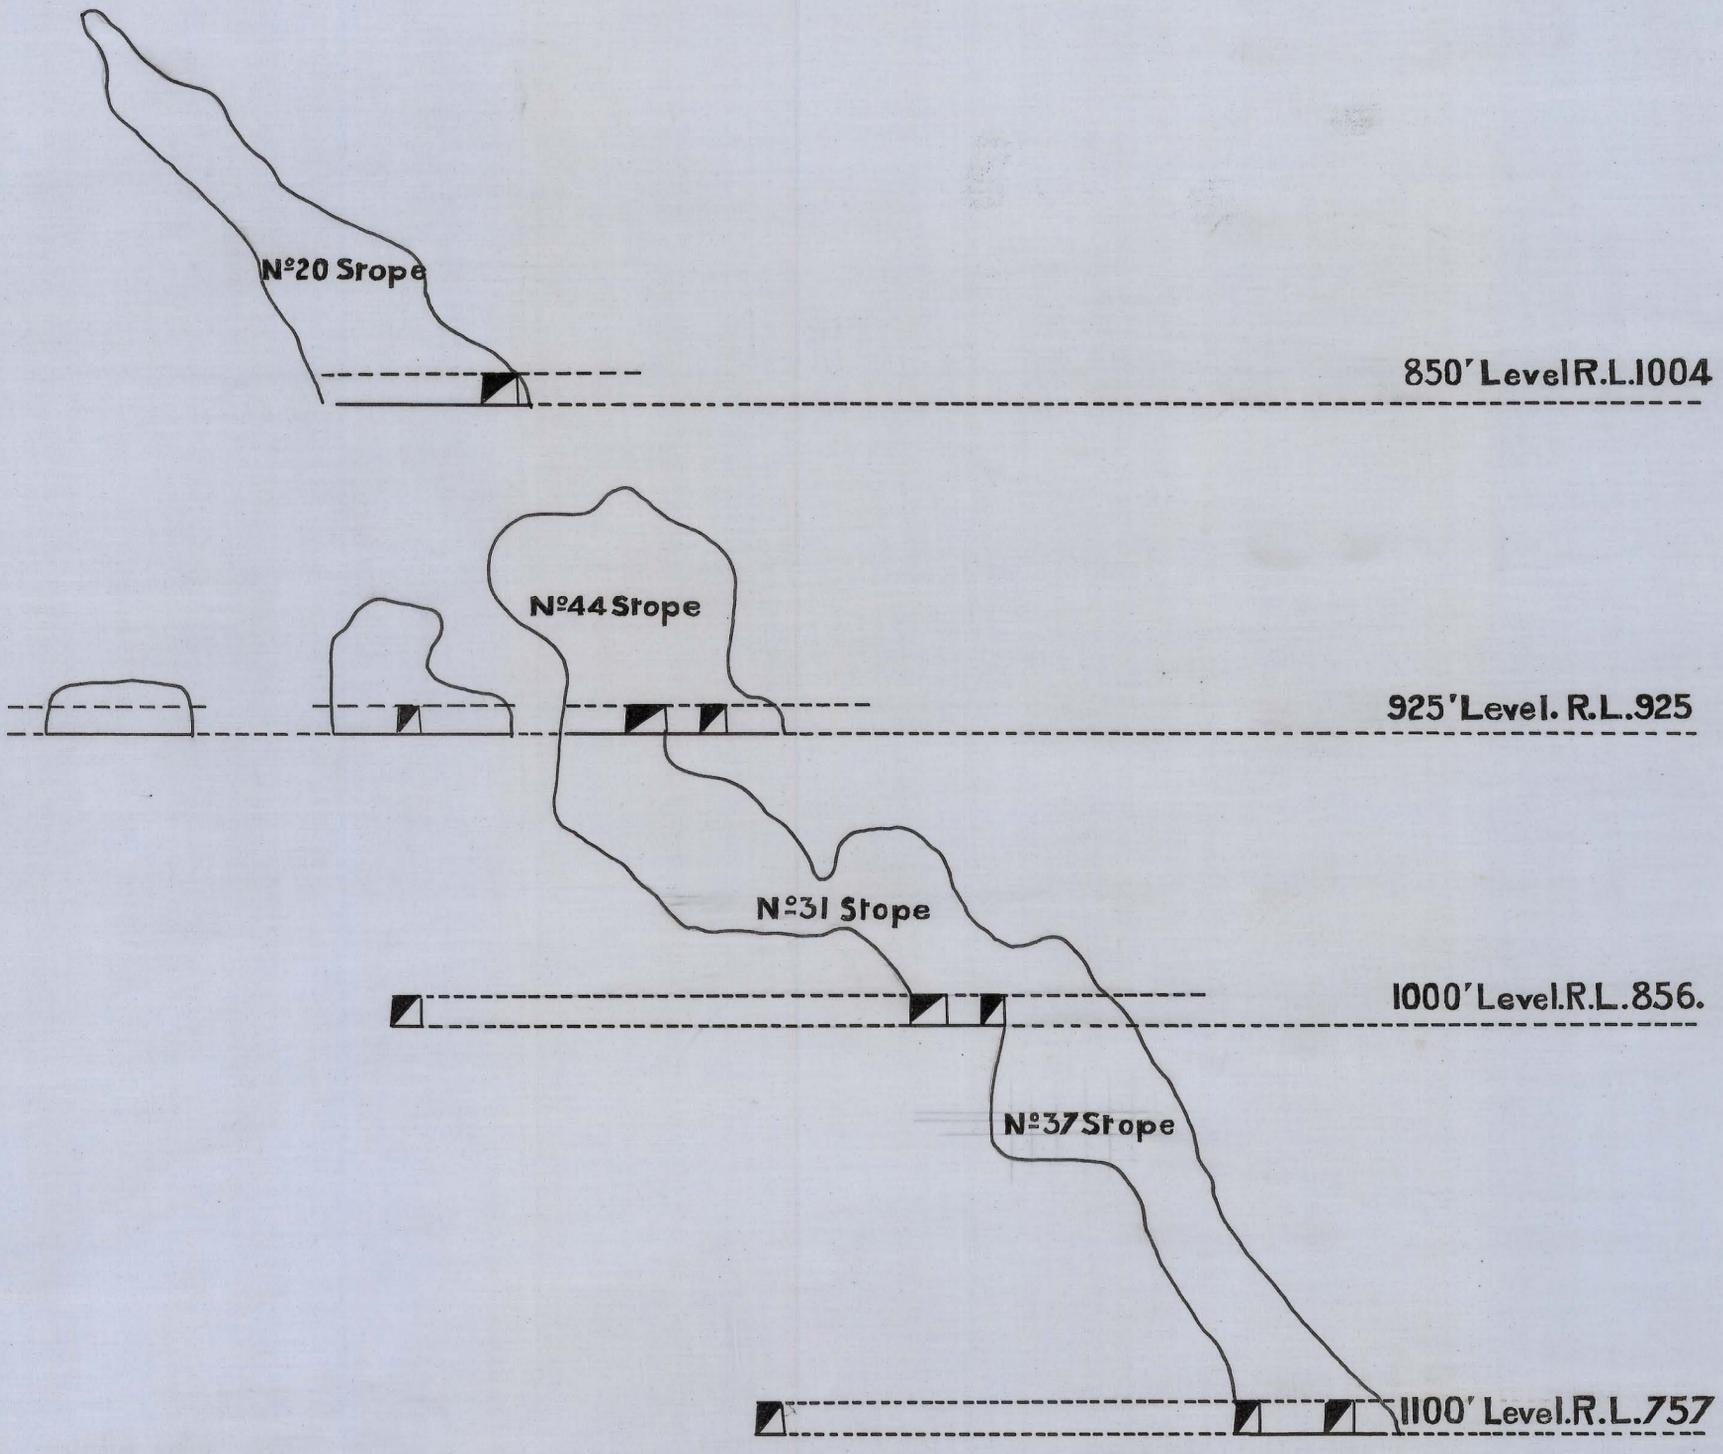


336
"

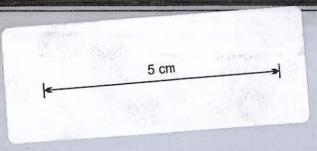

The Mount Lyell Mining & Railway Co., Ltd.

Mine Department

NORTH LYELL MINE
Section on Line CC looking North

Brought up to Dec. 31st 1927
Scale 1" = 30'

R. H. ... General Manager
L. Fred. ... Mine Superintendent

10/1/25