


336
12

5 cm

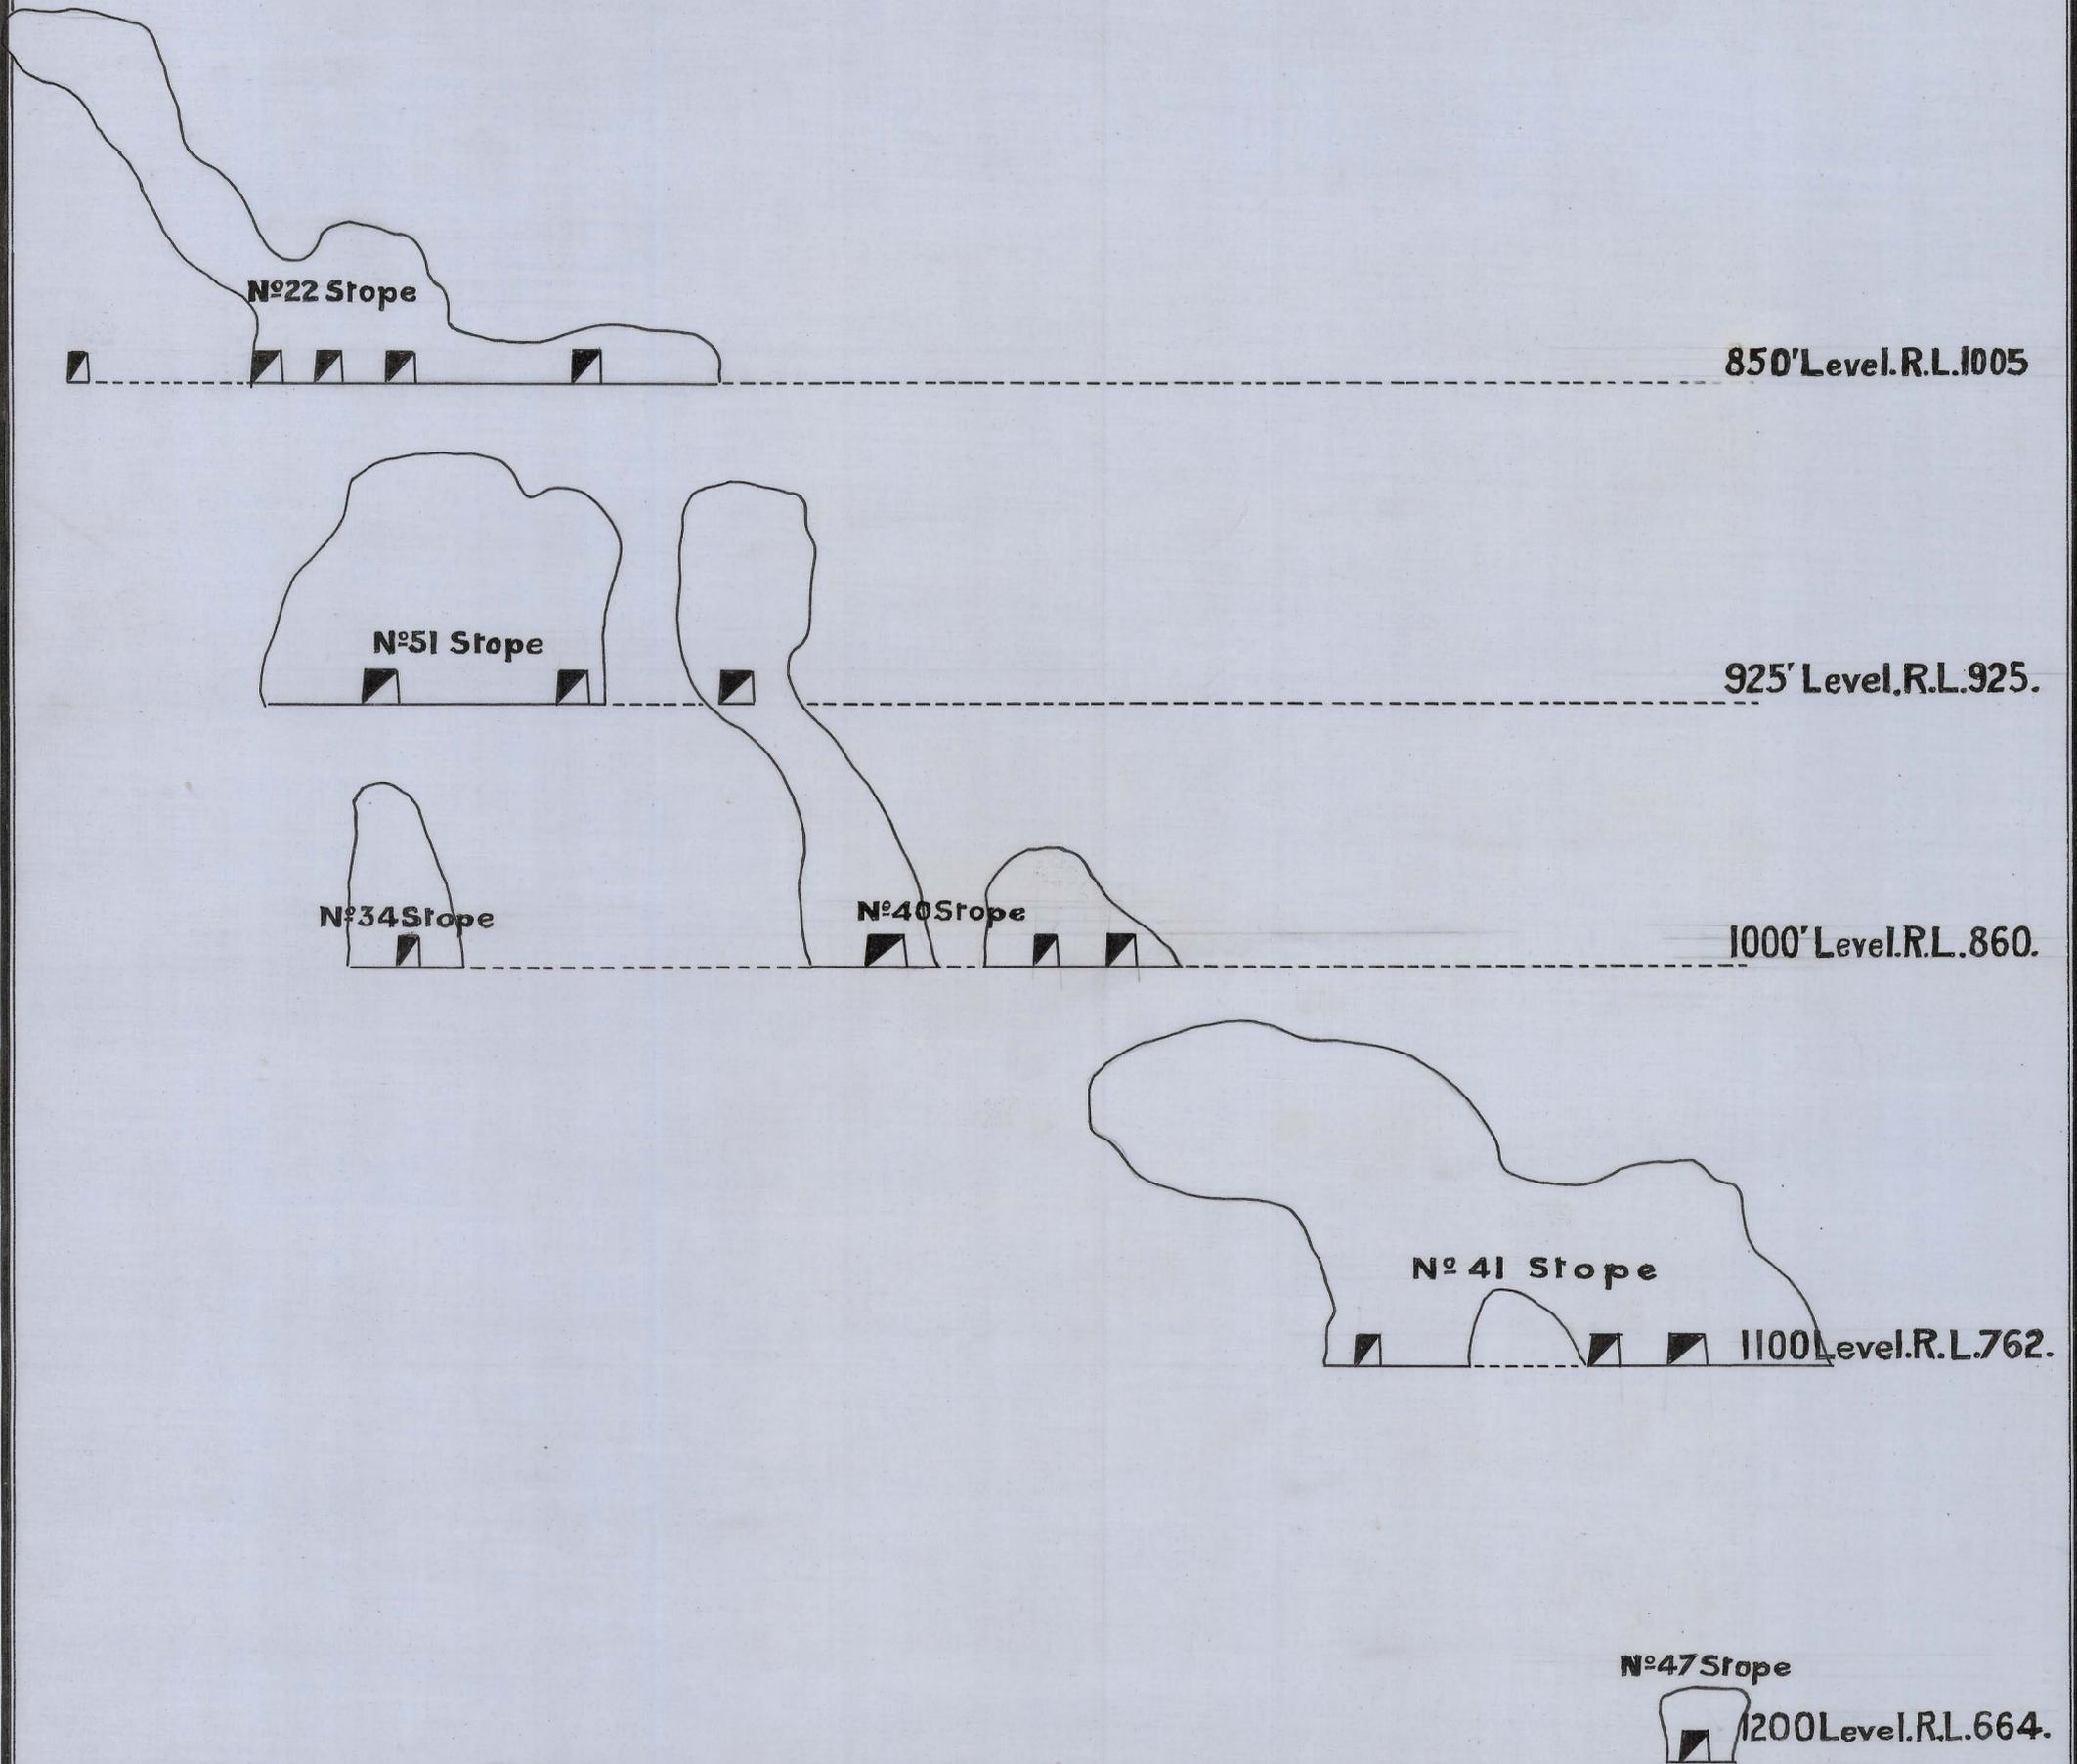

The Mount Lyell Mining & Railway Co., Ltd.

Mine Department

NORTH LYELL MINE

Section on Line DD looking North

Brought up to Dec. 31st 1927

Scale = 1" = 30'

R. H. Murray General Manager
J. G. J. King Mine Superintendent

10/13/28