



336
17

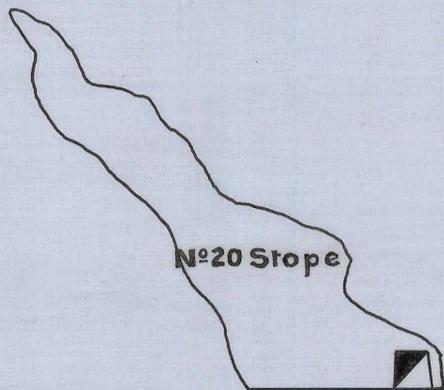


No. 20 Stope

850' Level R.L. 1004

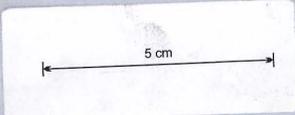

No. 44 Stope

925' Level R.L. 925

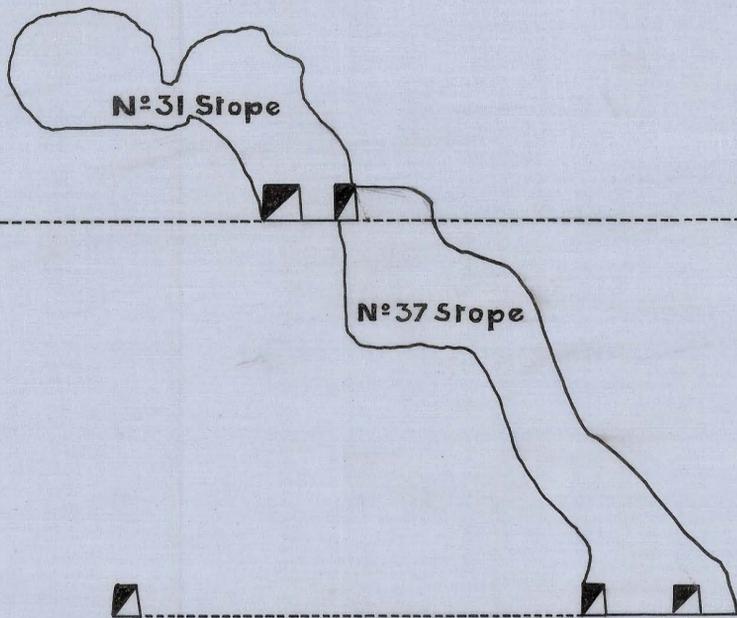

No. 31 Stope

No. 37 Stope

1000' Level R.L. 856

1100' Level R.L. 757

The Mount Lyell Mining & Railway Co., Ltd.

Mine Department

NORTH LYELL MINE

Section on Line CC looking North

Brought up to Dec. 31st 1925

Scale 1" = 30'

W. H. Robert General Manager
J. H. J. J. J. Mine Superintendent