


5 cm

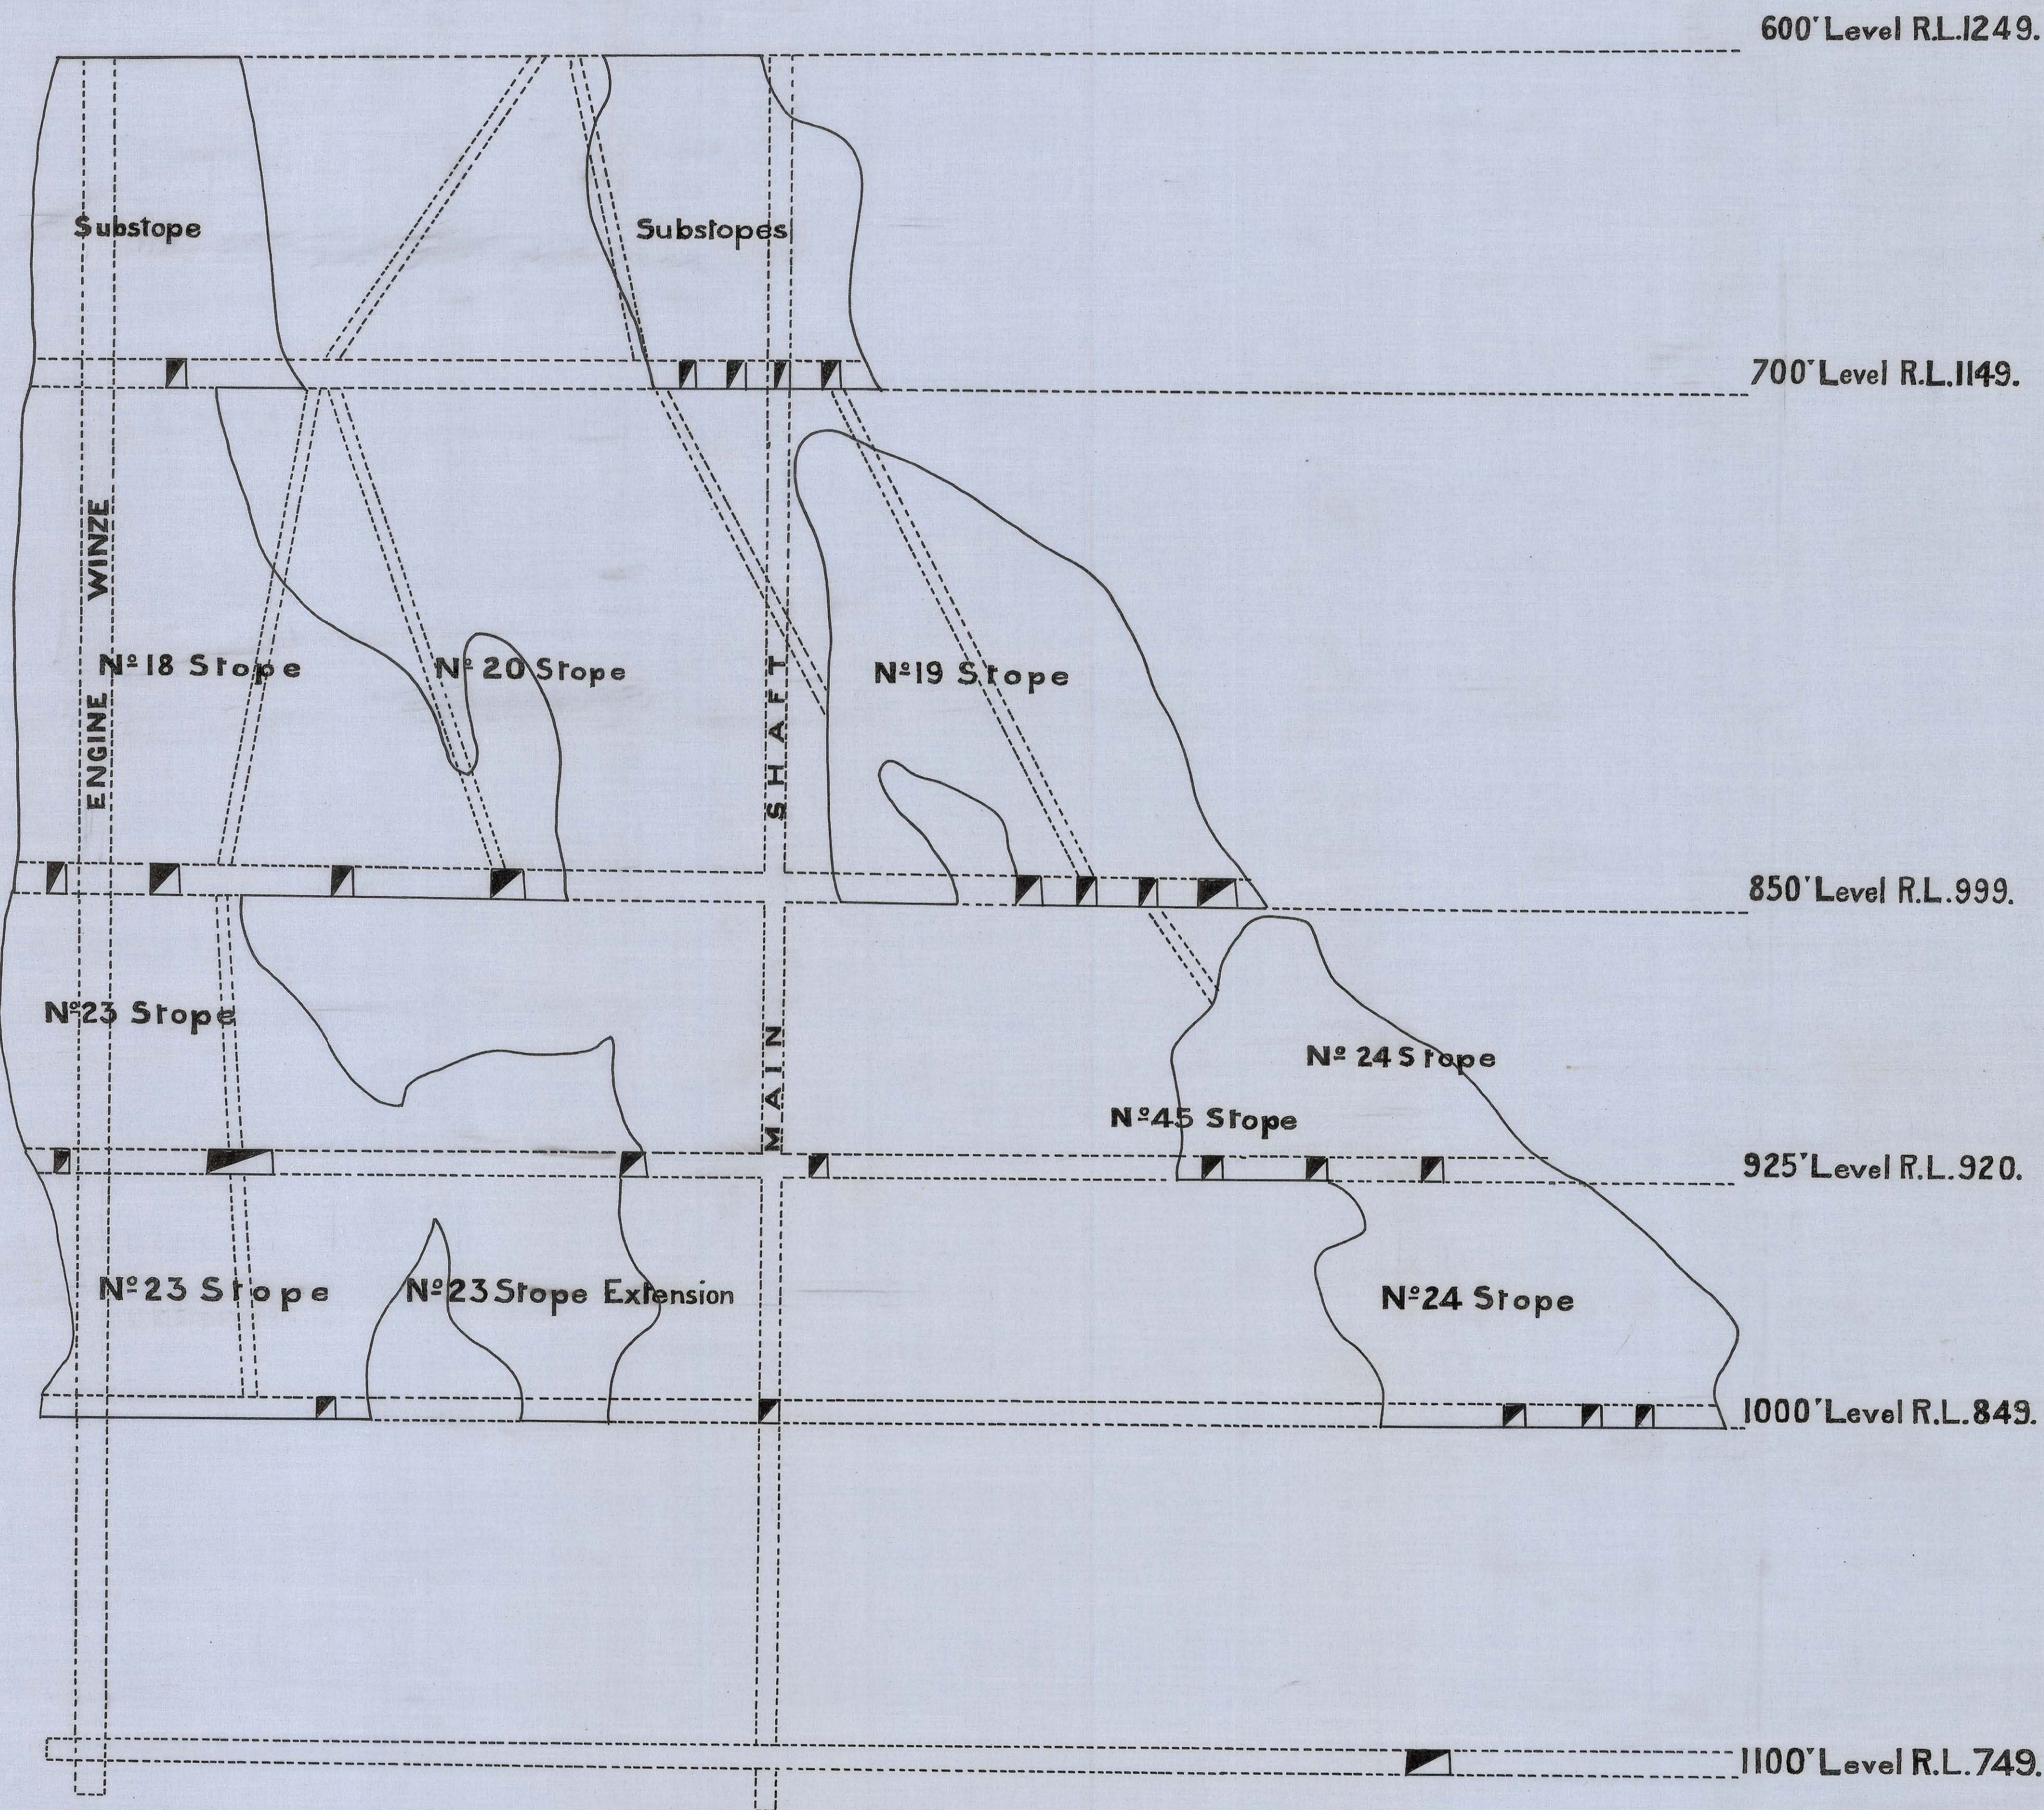

The Mount Lyell Mining & Railway Co. Ltd.

Mine Department

NORTH LYELL MINE

Section on Line BB looking North

Brought up to Dec. 31st 1925

Scale $\div 1'' = 30'$

G. H. Roberts General Manager
L. Red. J. J. J. Mine Superintendent