


336

22

5 cm

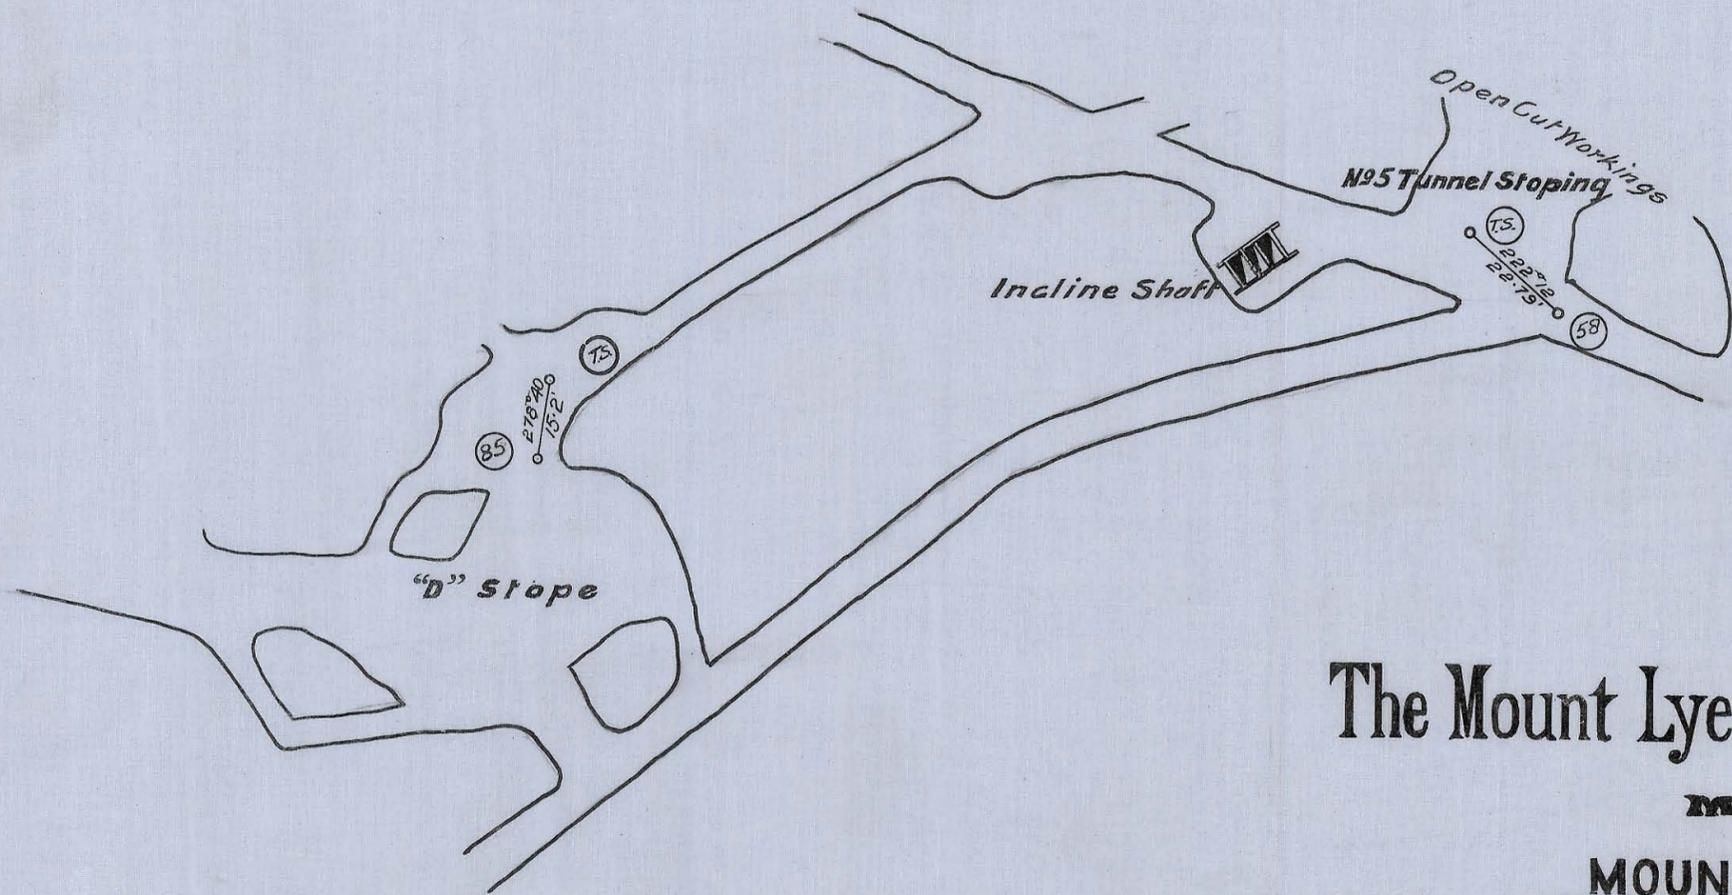

The Mount Lyell Mining & Railway Co., Ltd.

Mine Department.

MOUNT LYELL MINE

UNDERGROUND WORKINGS 1925

Scale 1" = 30'

Robert Oliphant General Manager

G. Fred Jackson Mine Superintendent