



336
23


5 cm

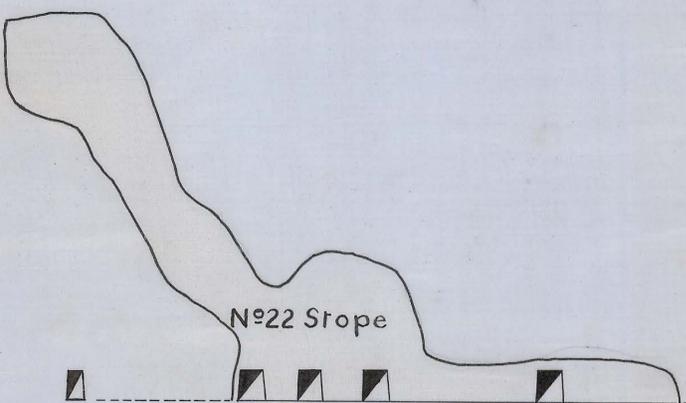


850' Level. R.L. 1005

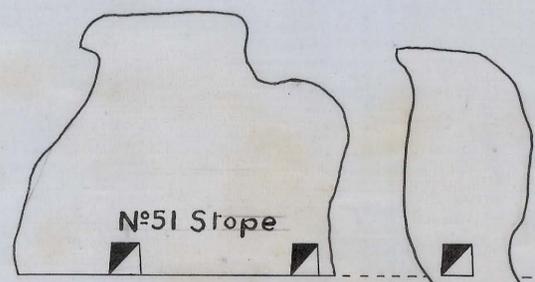


925' Level. R.L. 925

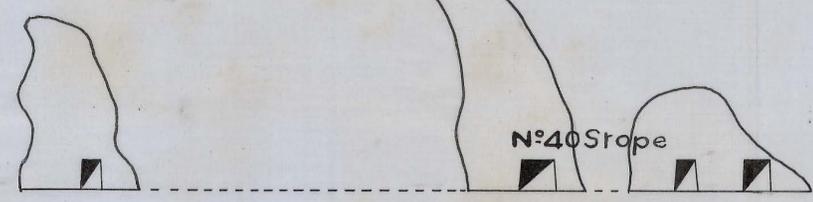

1000' Level. R.L. 860.

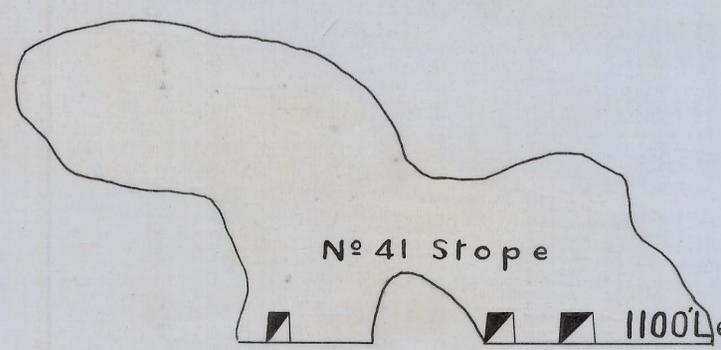

1100' Level. R.L. 762.

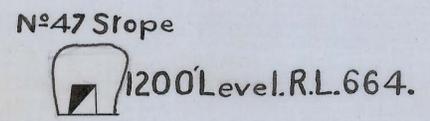

1200' Level. R.L. 664.

The Mount Lyell Mining & Railway Co., Ltd.

Mine Department

NORTH LYELL MINE

Section on Line DD looking North

Brought up to Dec. 31st 1928

Scale: 1" = 30'

Robt. Murray General Manager
L. S. ... Mine Superintendent