

5 cm

The Mount Lyell Mining & Railway Co. Ltd.


Mine Department.

FIELD NOTES OF UNDERGROUND WORKINGS UP TO 31-12-28

SHEET No 1

R. H. Morrison General Manager.
J. H. Johnson Mine Superintendent.

INSTRUMENT USED 5" THEODOLITE

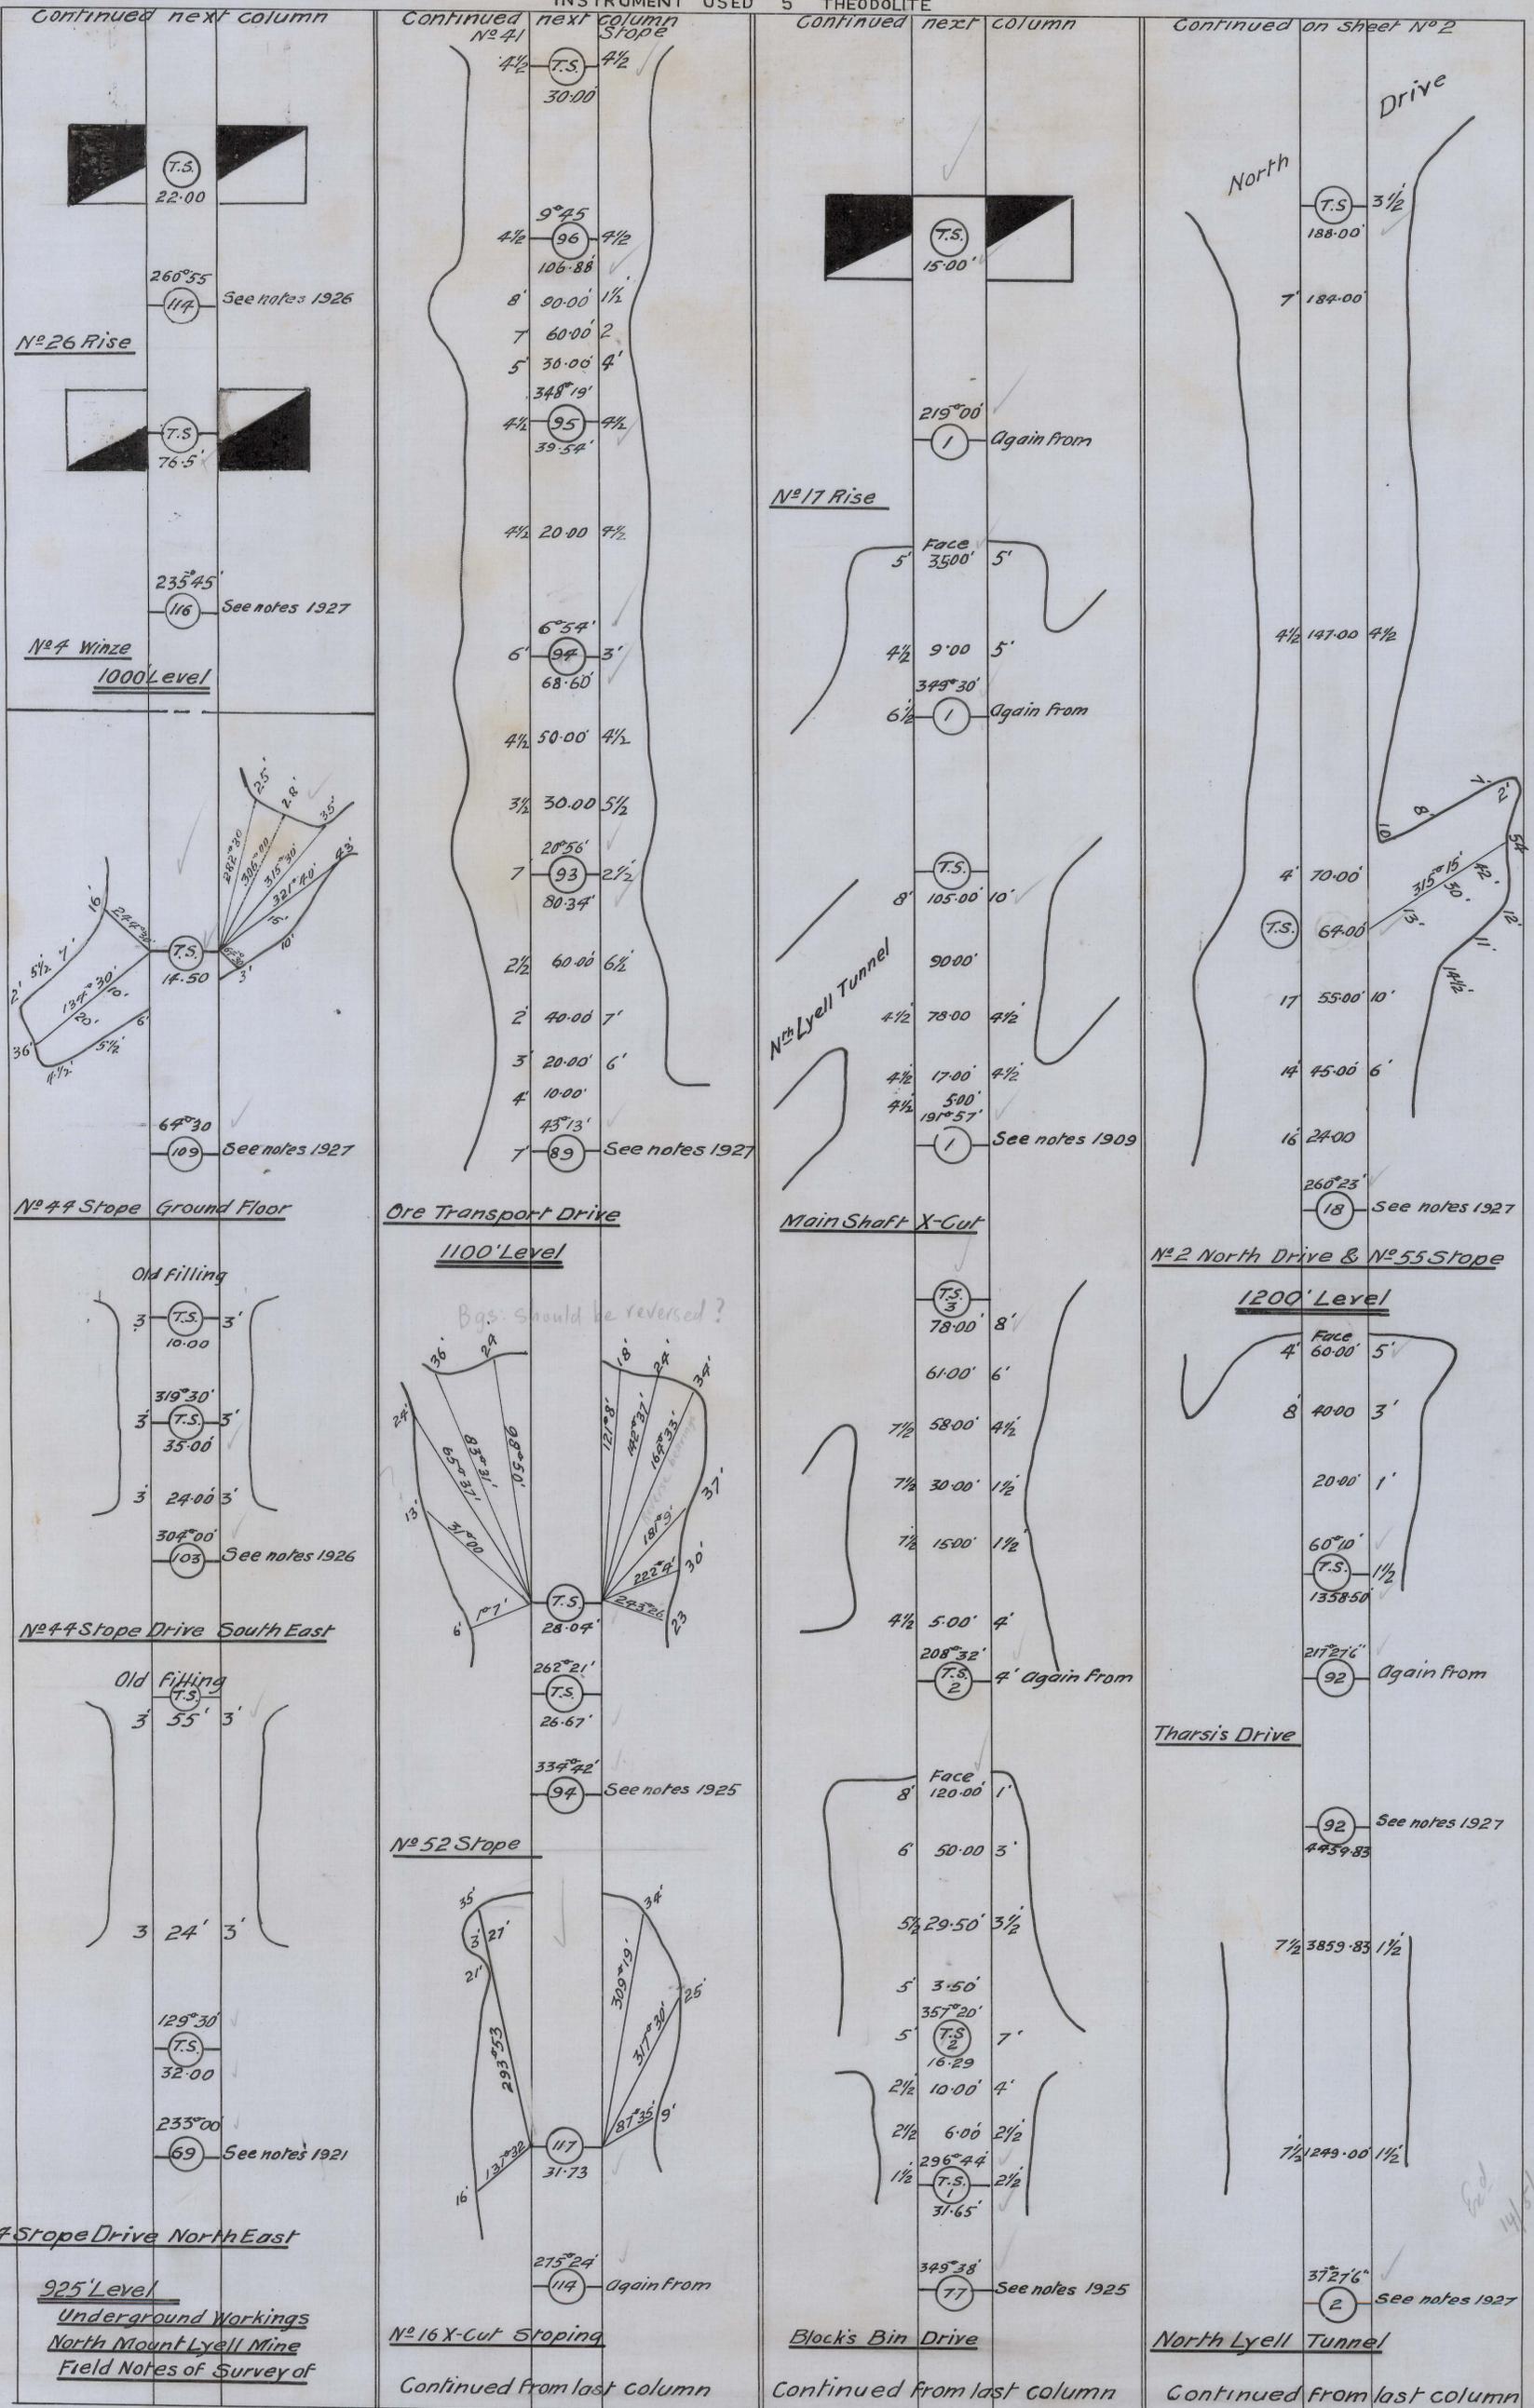

End 14/5/29