


336  
26

5 cm

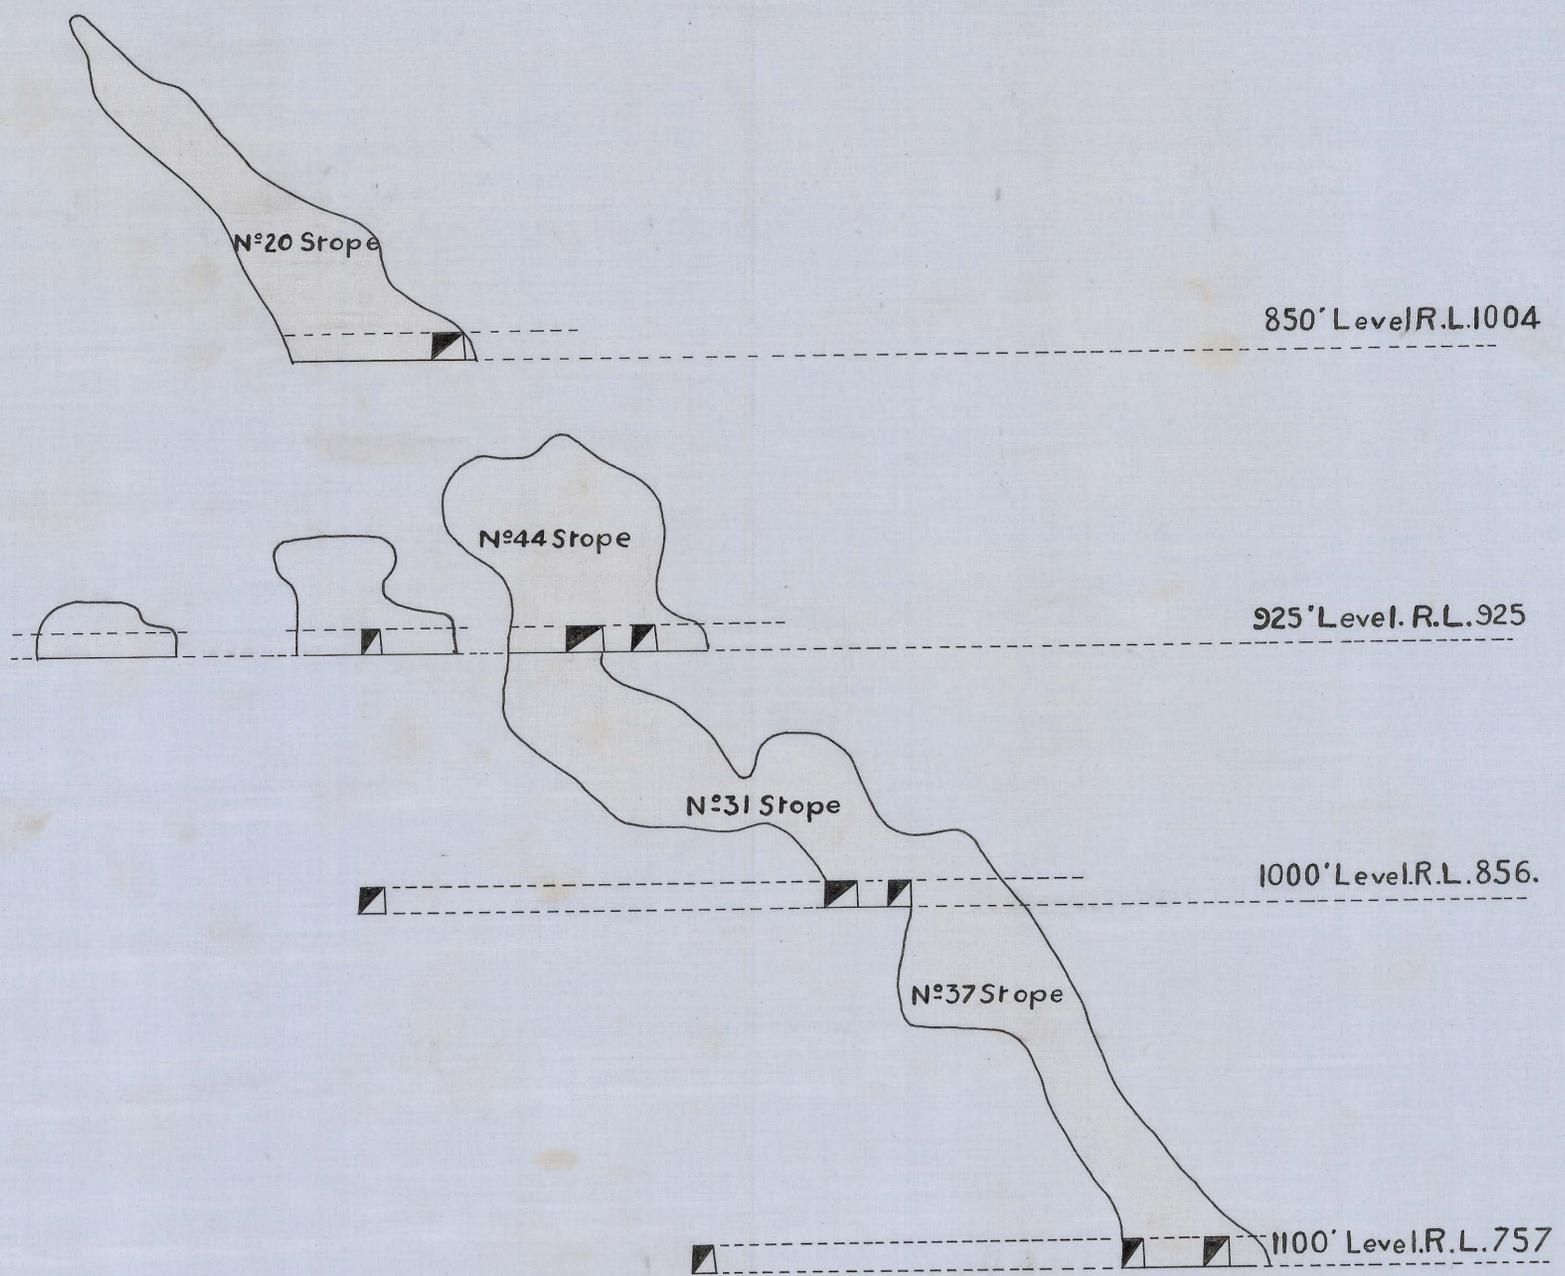

# The Mount Lyell Mining & Railway Co., Ltd.

Mine Department

## NORTH LYELL MINE

Section on Line CC looking North

Brought up to Dec. 31<sup>st</sup> 1928

Scale: 1" = 30'

*R. W. Morrison* General Manager  
*S. H. ...* Mine Superintendent