



N°5 Tunnel

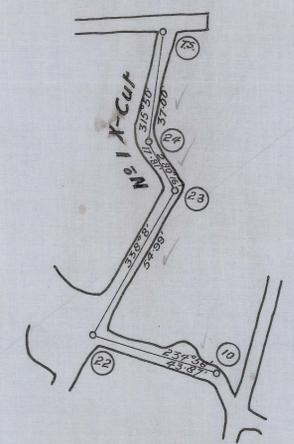

N°2 Level

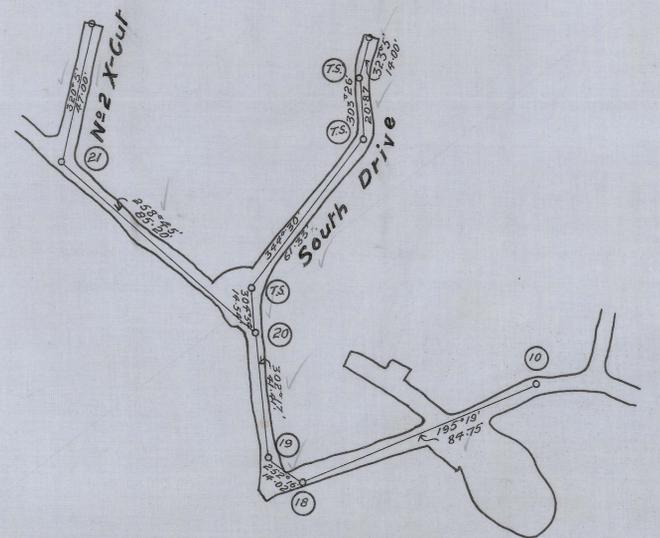

N°3 Level

The Mount Lyell Mining & Railway Co. Ltd.


Mine Department
LYELL COMSTOCK MINE

UNDERGROUND WORKINGS 1928

SCALE : 1 INCH = 30 FEET

Plotted 11/28

R. H. Murray - General Manager
S. H. Sabine - Mine Superintendent

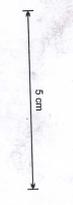

336
27