
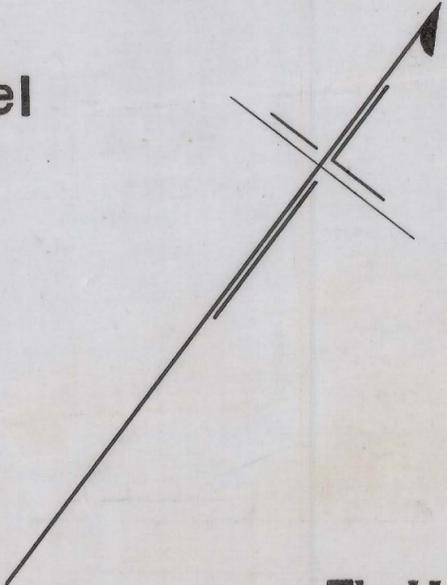
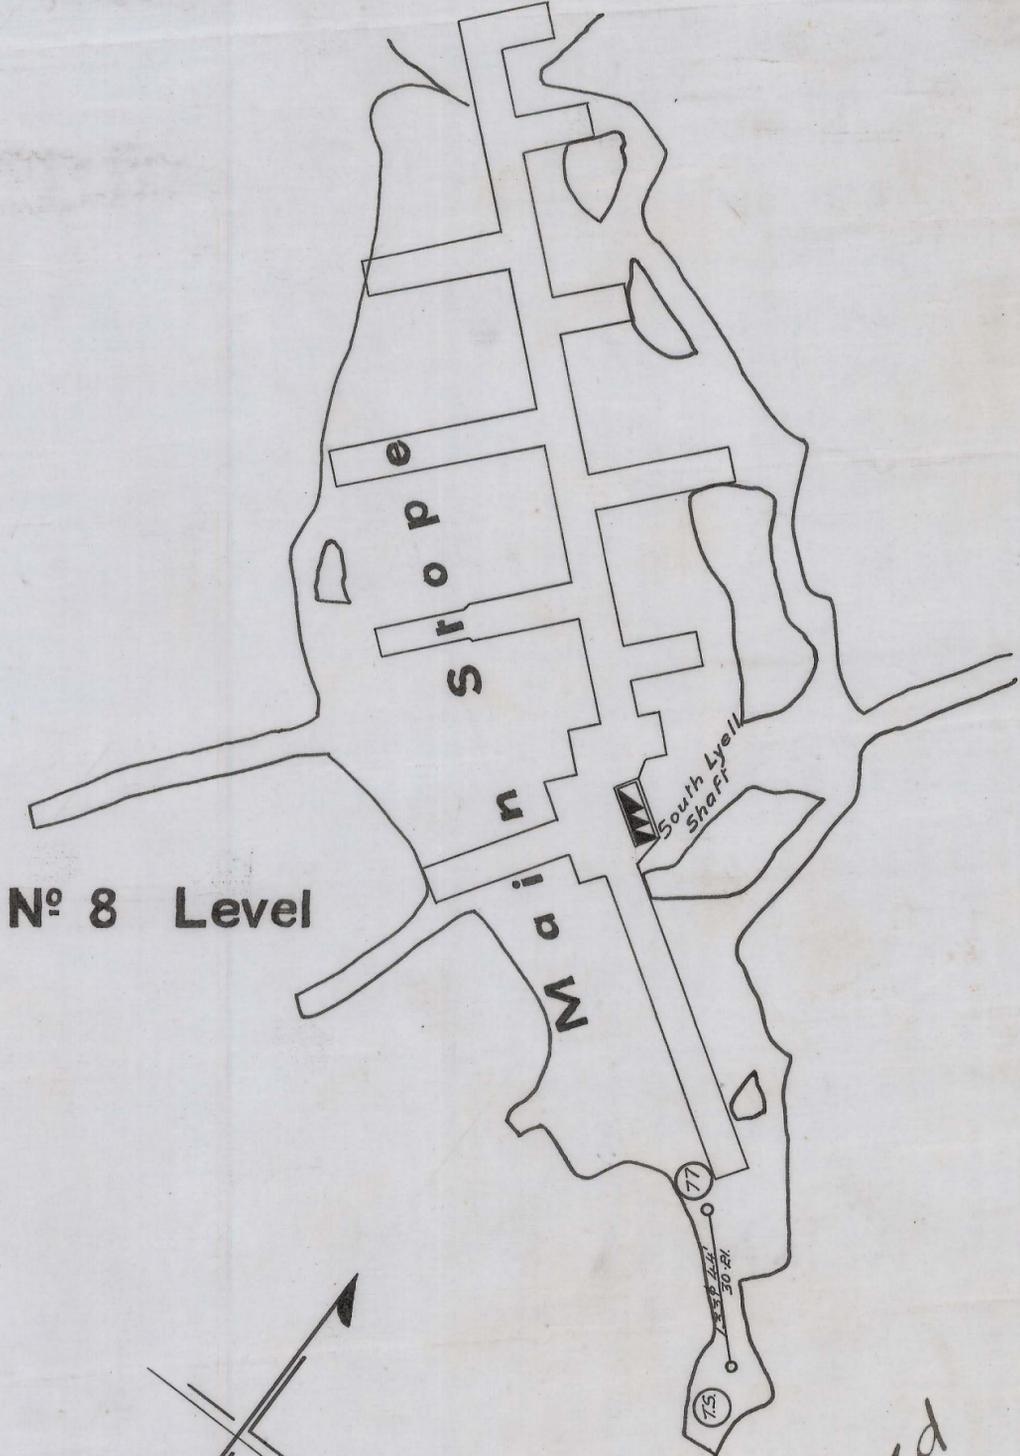


336
29

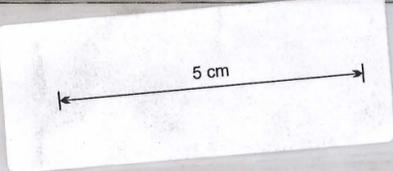

F.D.
17-8-22

The Mount Lyell Mining & Railway Co., Ltd.

Mine Department.

MOUNT LYELL MINE.

UNDERGROUND WORKINGS 1922.

SCALE : 1 INCH = 30 FEET.

R. H. Murray General Manager.
G. H. Jackson Mine Superintendent.