


The Mount Lyell Mining & Railway Co., Ltd.

Mine Department.


Field Notes of Underground Workings up to 31.3.22

Instrument used 5" Theodolite

R. H. Murray ^{Genl} General Manager
C. E. J. Jones Mine Superintendent

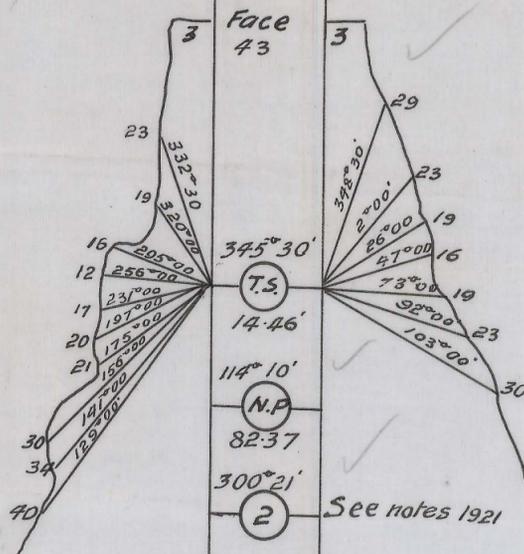


North Stope

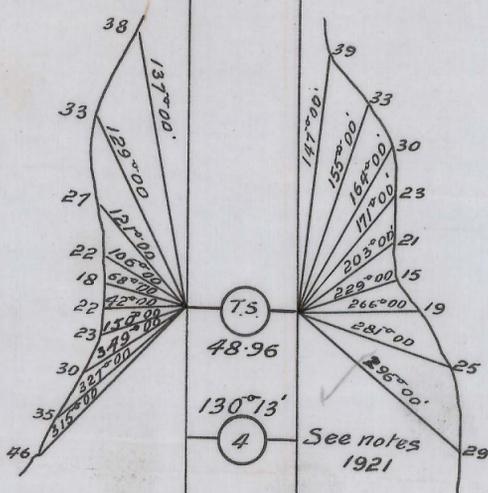

Main Stope

N^o 10 Level

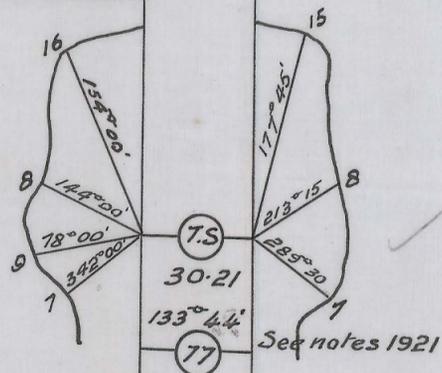

Main Stope Drive

N^o 8 Level

Underground Workings
of Mount Lyell Mine
Field notes of Survey