
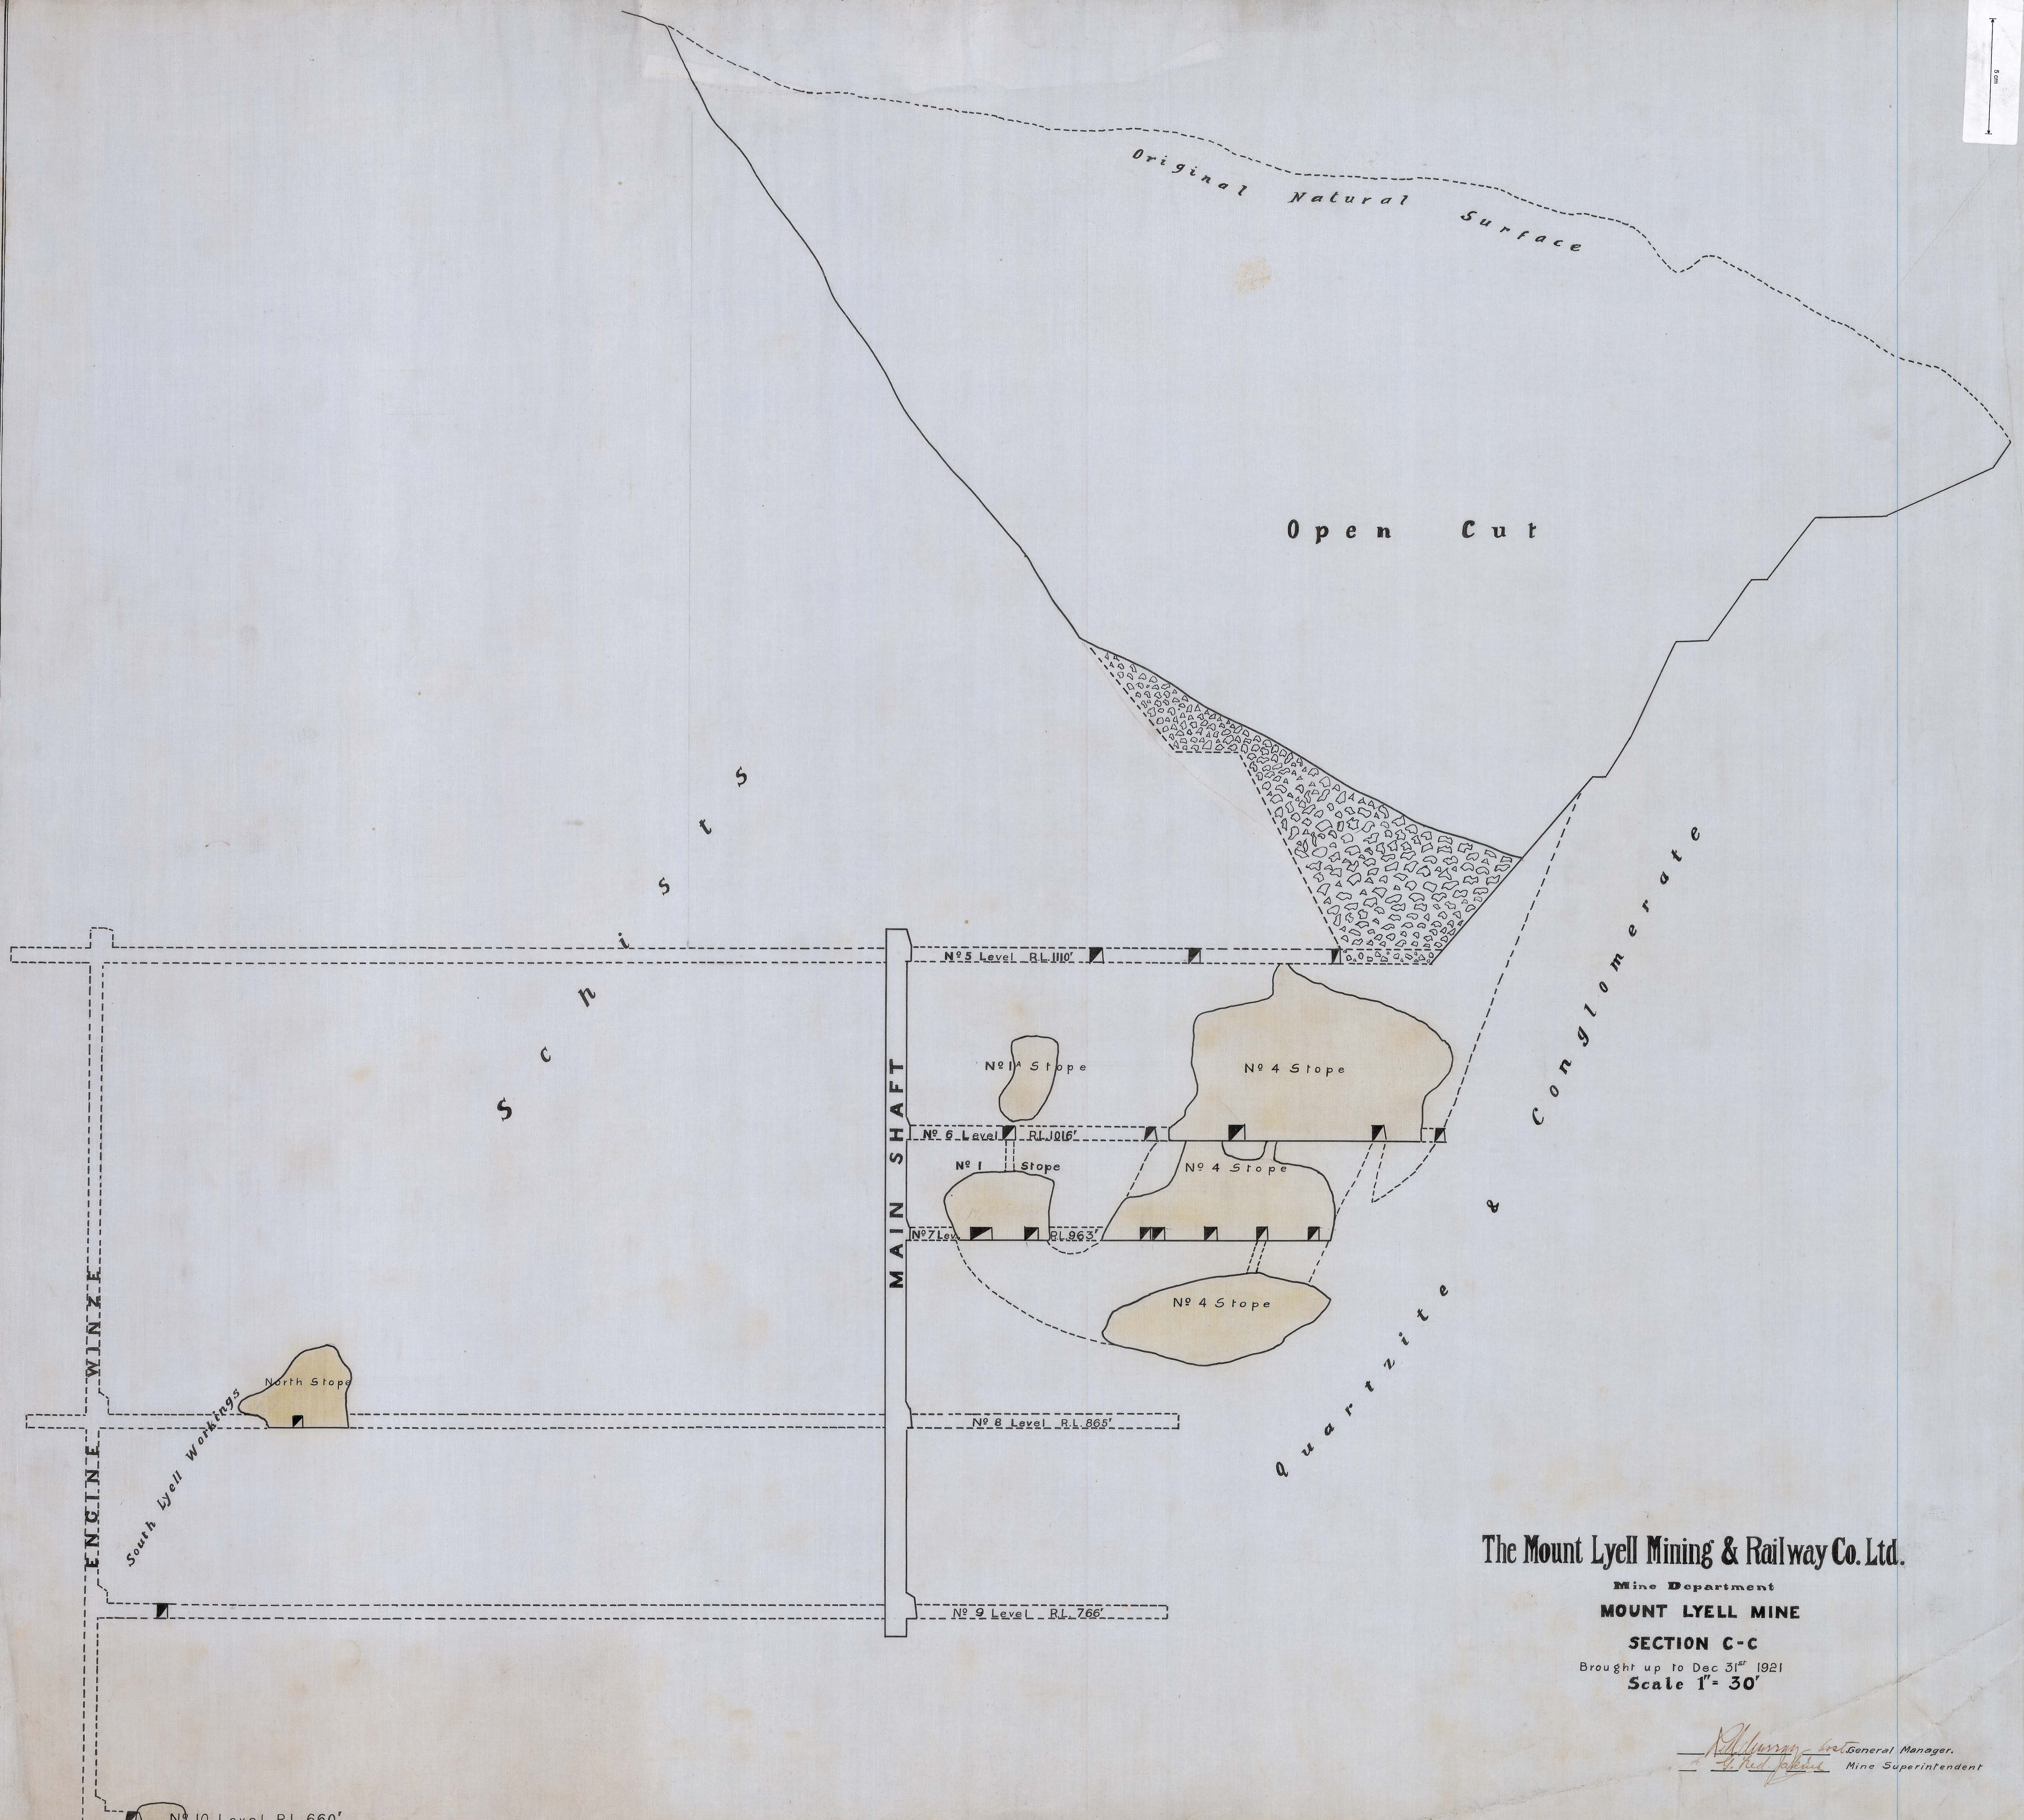


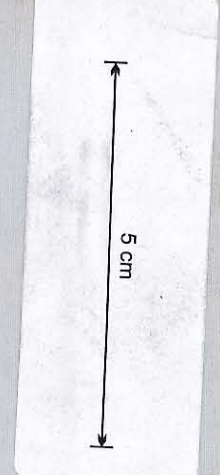

The Mount Lyell Mining & Railway Co. Ltd.

Mine Department
MOUNT LYELL MINE

SECTION C-C

Brought up to Dec 31st 1921
Scale 1" = 30'

W. H. Murray Gen. Manager.
W. H. Murray Mine Superintendent