




700' Level.

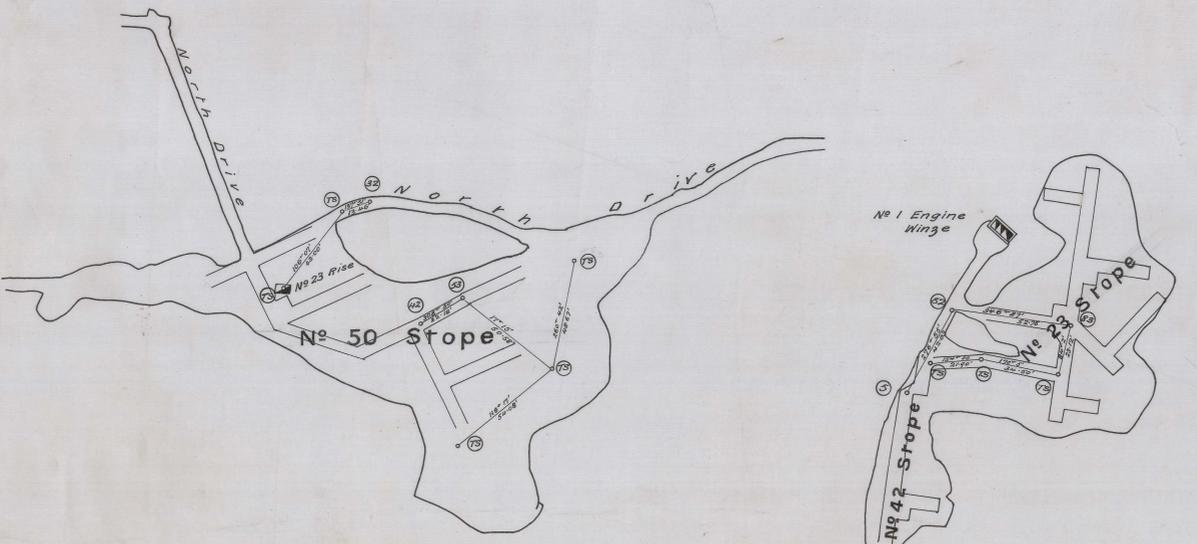

850' Level

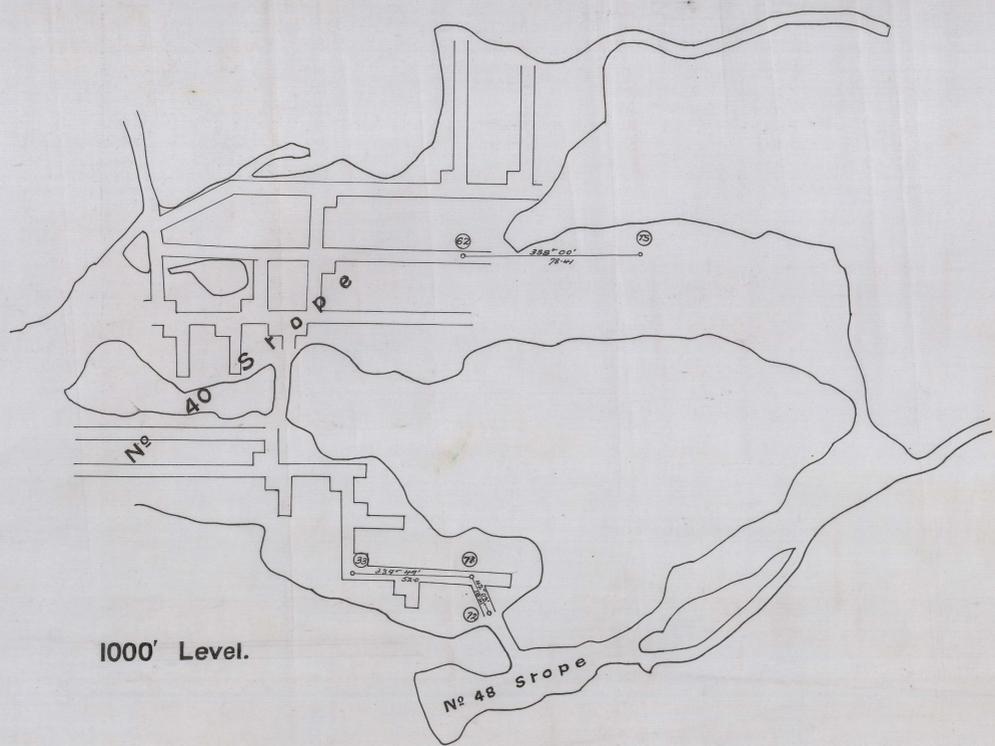

1000' Level.

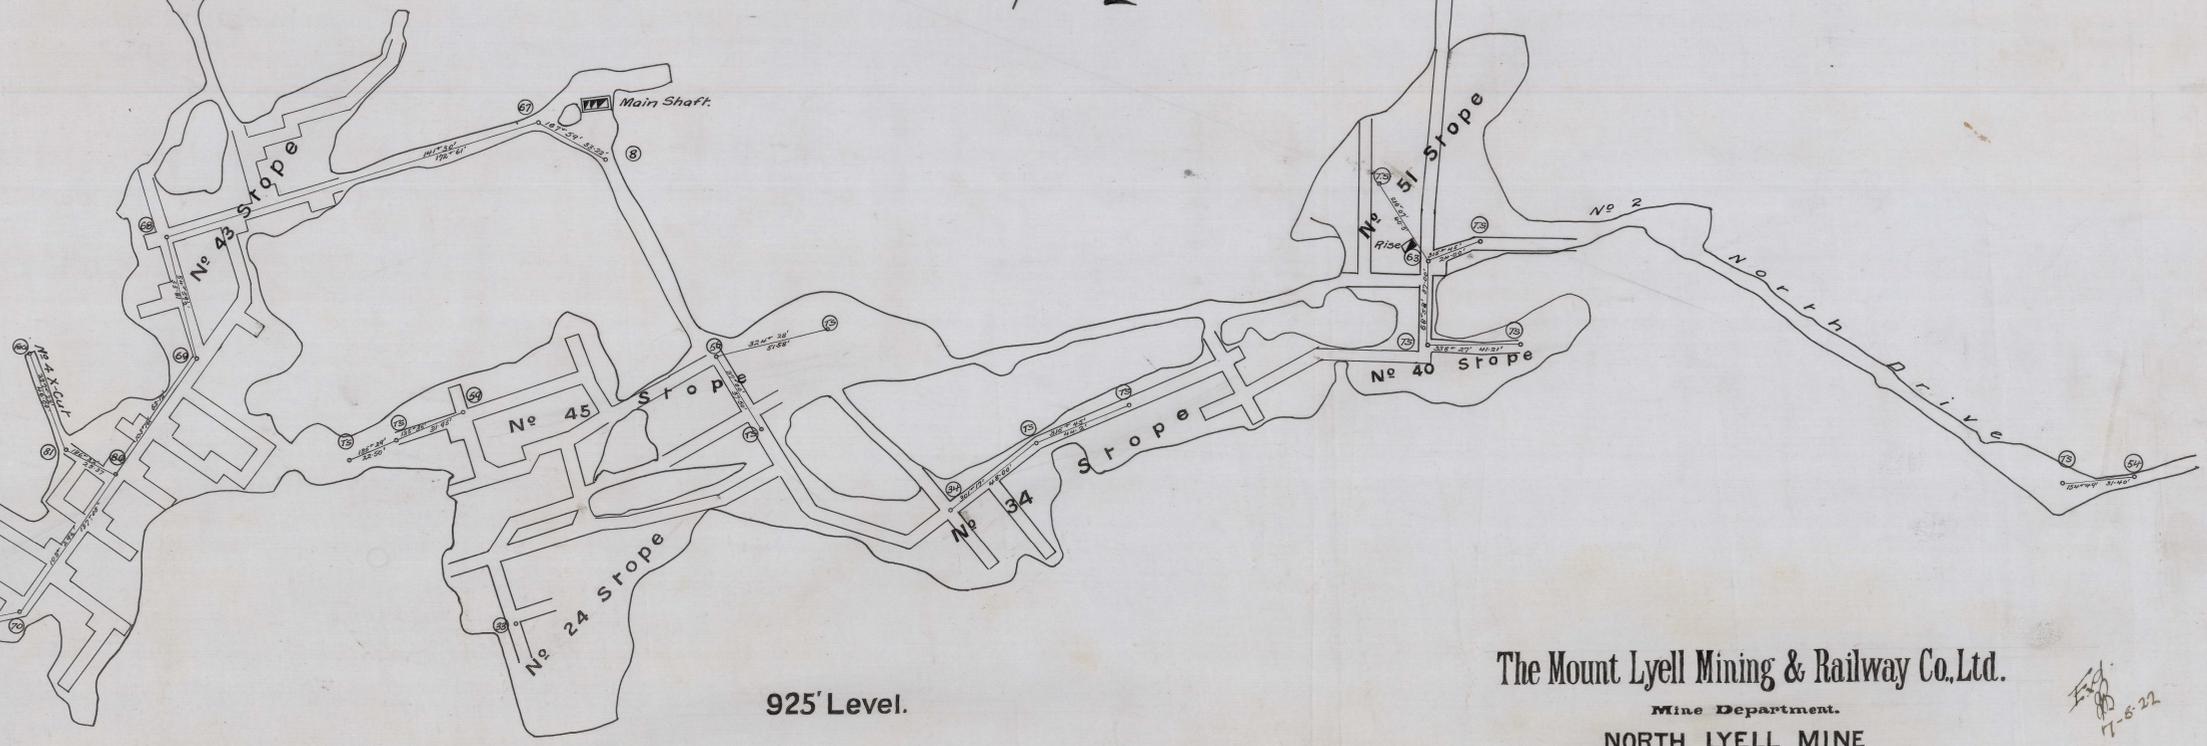

925' Level.

The Mount Lyell Mining & Railway Co., Ltd.

Mine Department.  
NORTH LYELL MINE  
UNDERGROUND WORKINGS. 1921  
SCALE: 1 INCH = 30 FEET

*R. Williams* Genl. Manager  
*L. J. Johnson* Mine Superintendent

28  
29