

# The Mount Lyell Mining & Railway Co., Ltd.


Mine Department.

Field Notes of Underground Workings up to 31.12.21.

Instrument used 5" Theodolite.


SHEET N° 2

*R. H. Murray* General Manager.  
*J. H. J. J. J.* Mine Superintendent

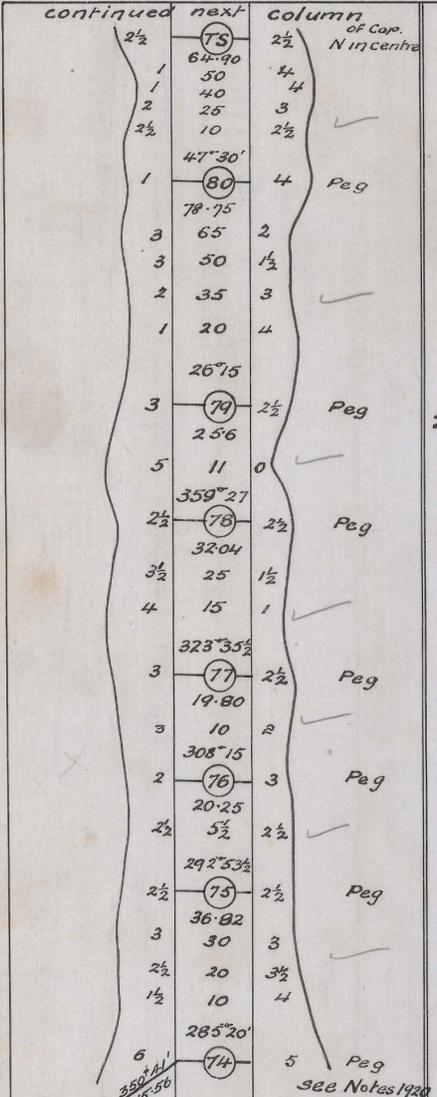


### Deviation Drive


### N° 6 Level

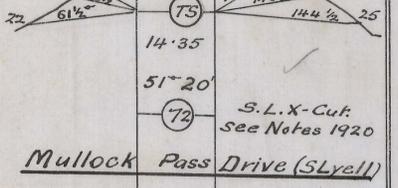

### Mullock Pass Drive (S. Lyell)

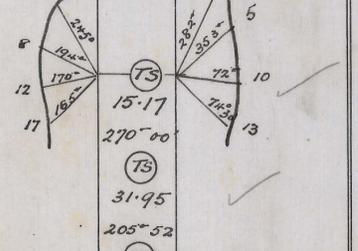

### Engine Chamber Main Shaft

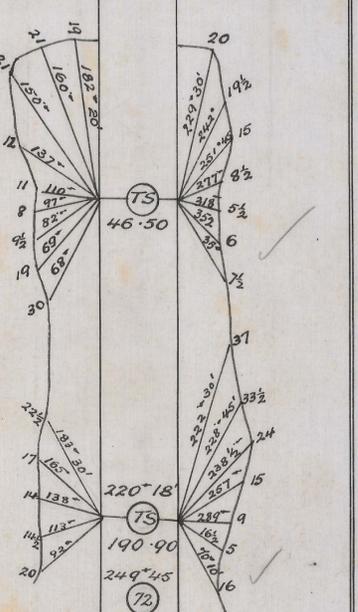


### Engine Winze Chamber

### N° 5 Level


### Underground Workings of Mount Lyell Mine

### Field Notes of Survey

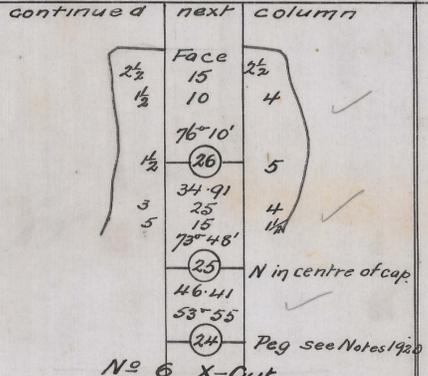

### N° 6 X-Cut

### N° 9 Level

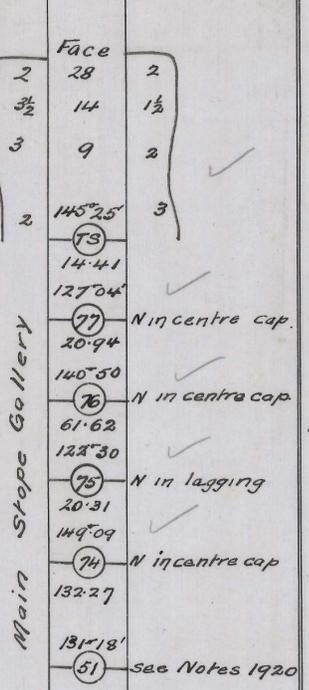


### Main Stope Drive

### N° 8 Level


### N° 8 Rise N° 1 Stope

### Gallery connecting Nos 2 & 6 Stopes

### N° 7 Level

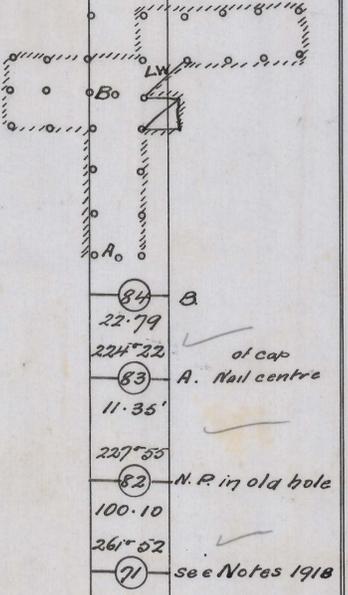

### Line of Sets N° 3 Stope

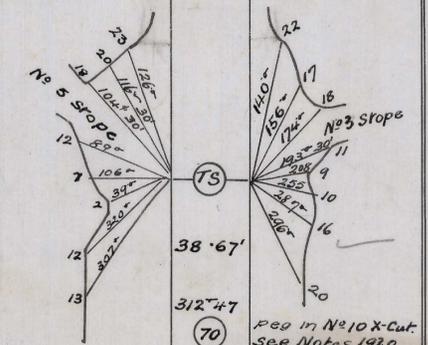


### N° 3-5 Pillar Stope

continued from last column




### Main Stope

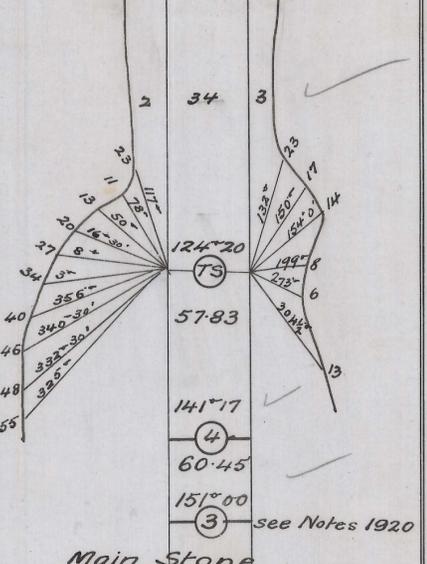


### North Stope


### N° 10 Level

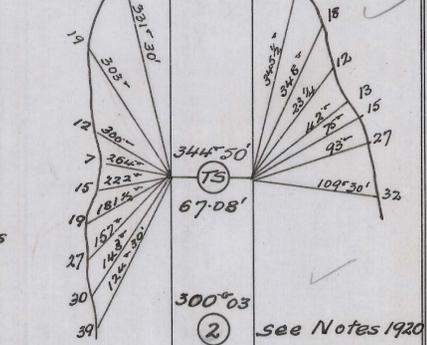

### Main Stope S End

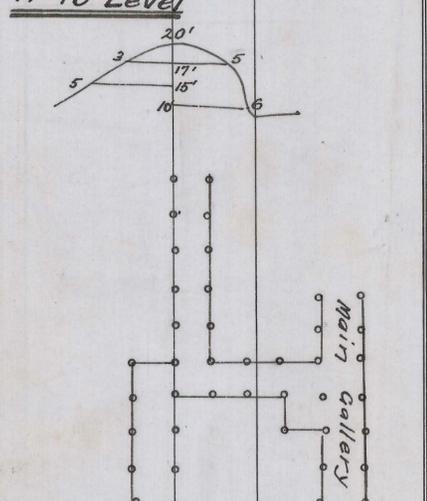

### Addition to Engine Winze Plat

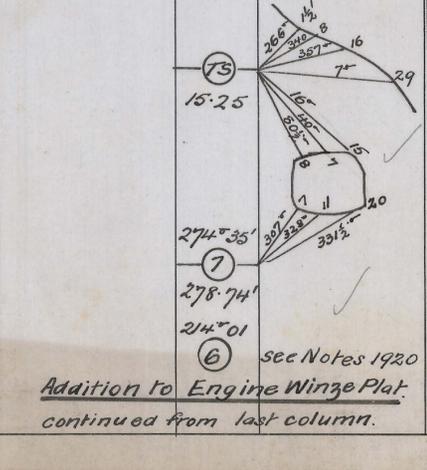

continued from last column.