


336
35

5 cm

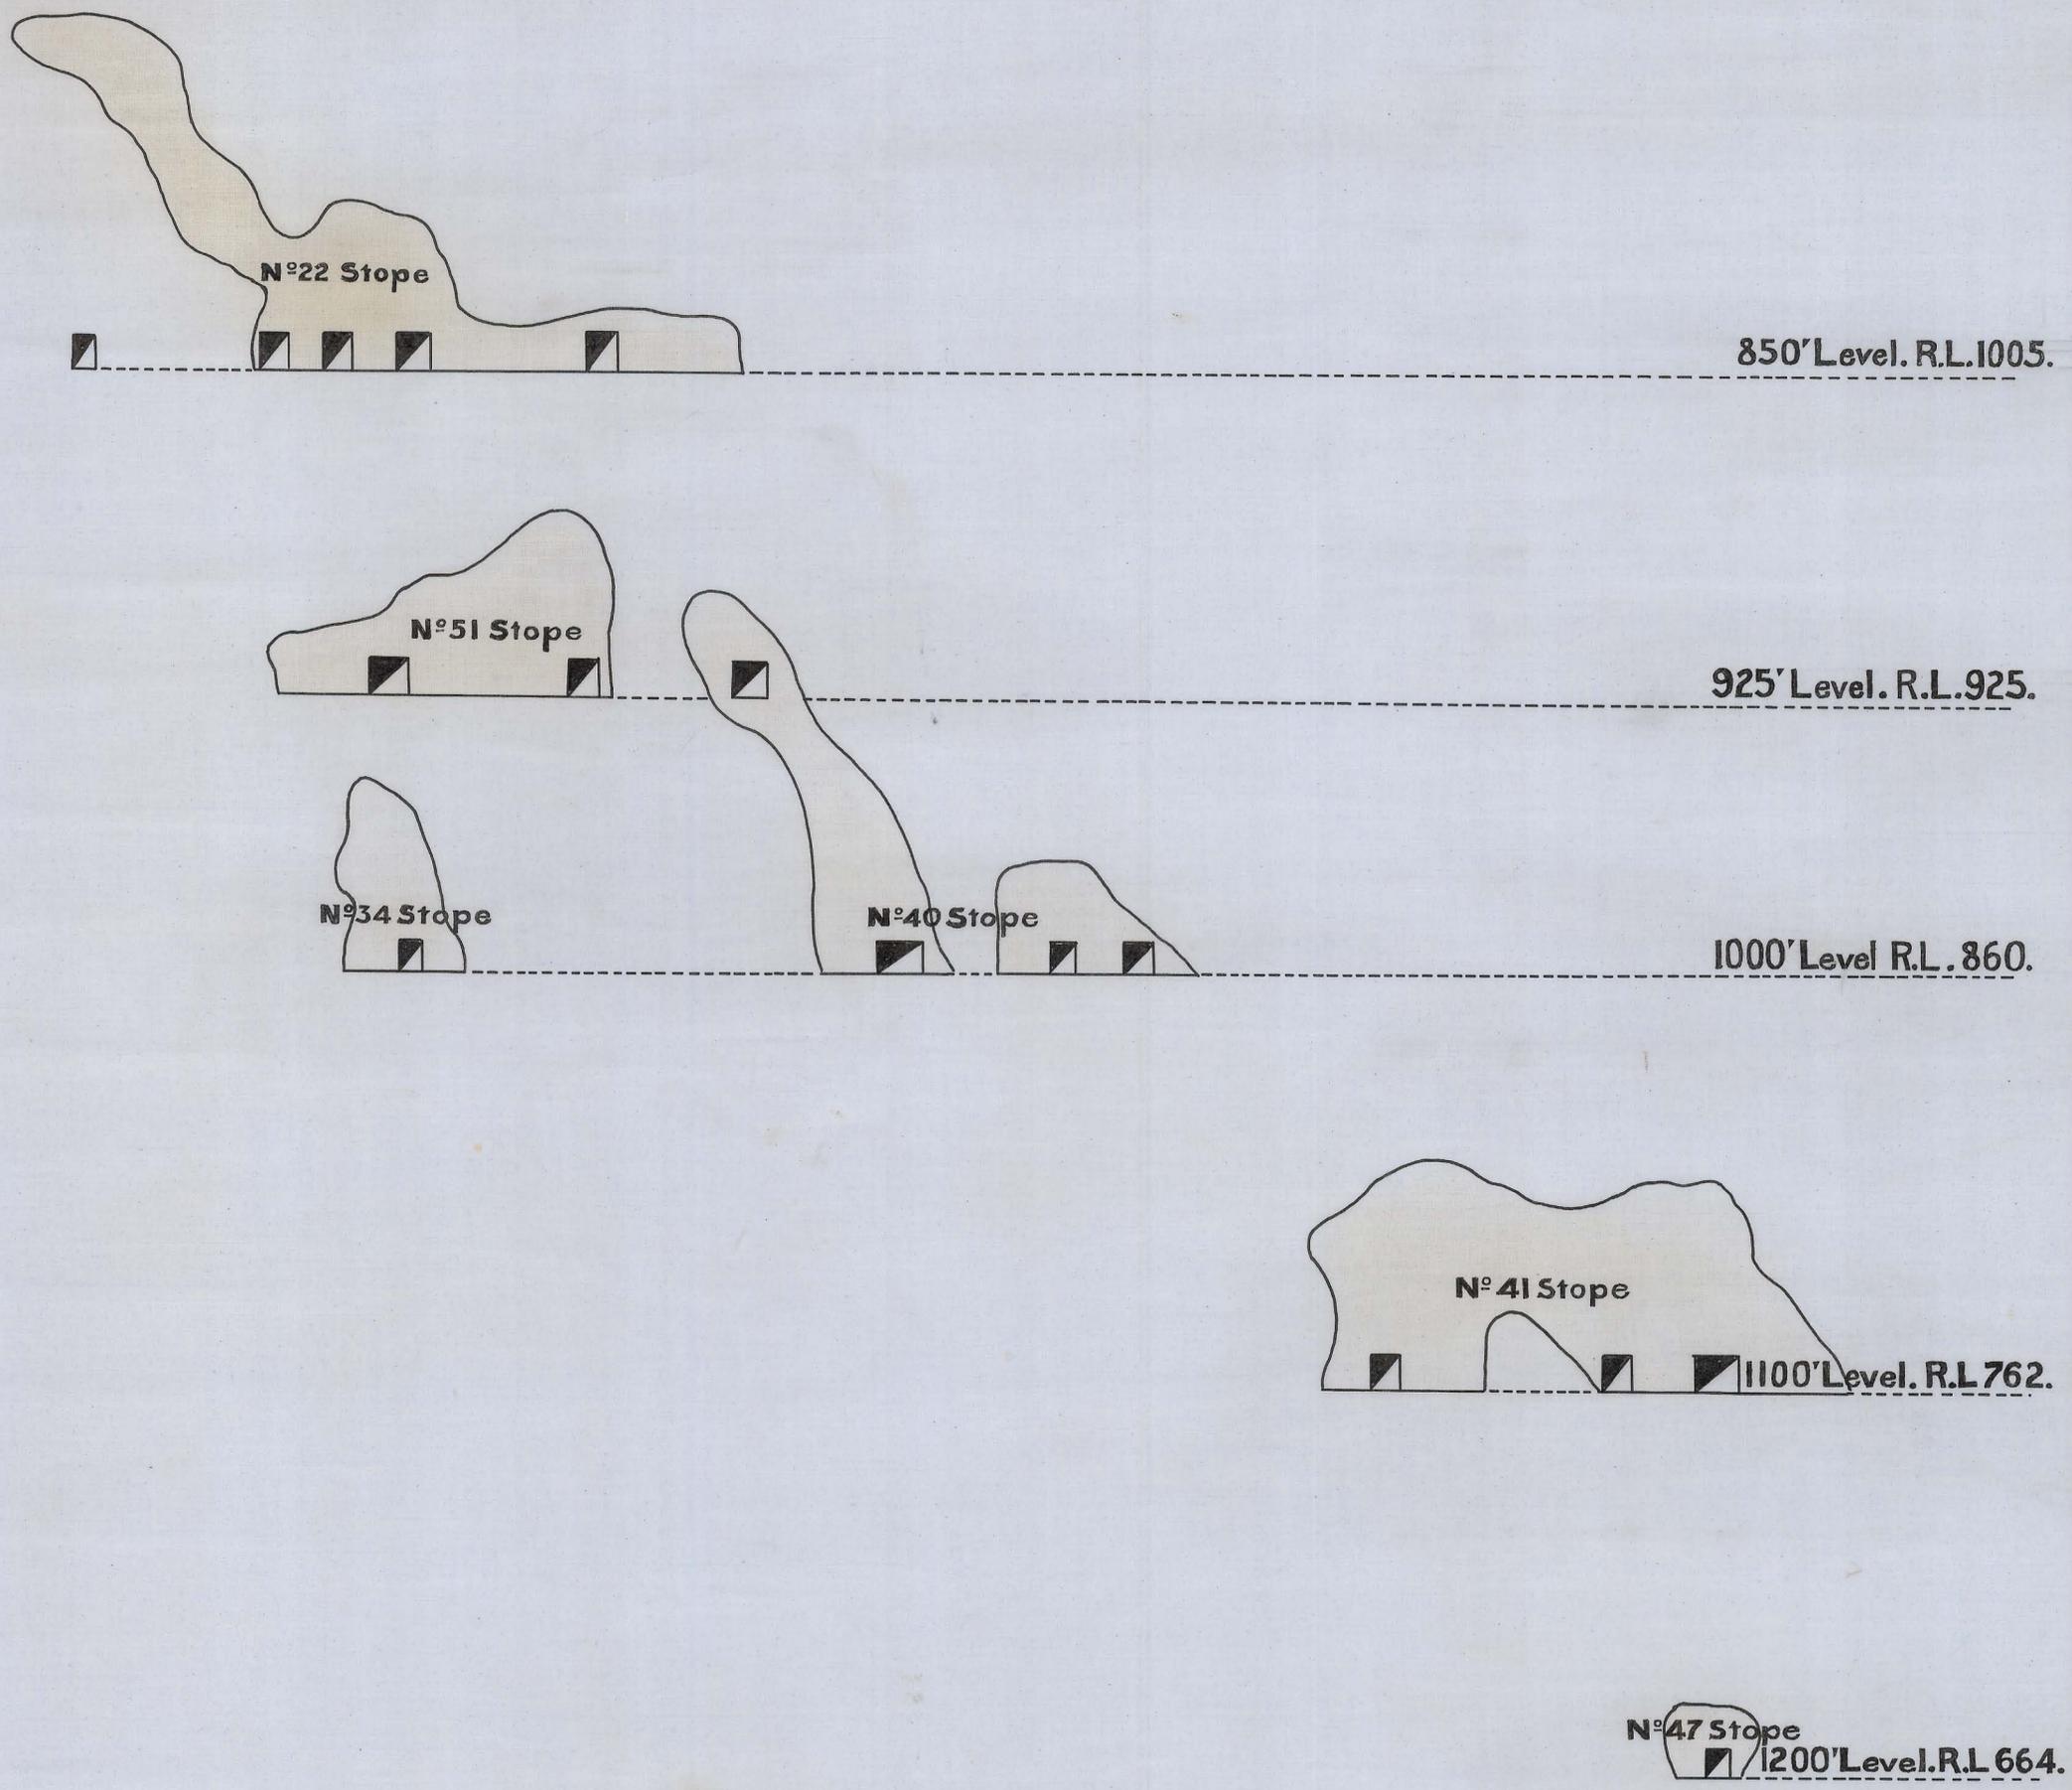

The Mount Lyell Mining & Railway Co., Ltd.

Mine Department

NORTH LYELL MINE

Section on Line DD looking North

Brought up to Dec. 31st 1923

Scale 1" = 30'

R. H. Murray General Manager
S. Fred. Jakub Mine Superintendent