


5 cm

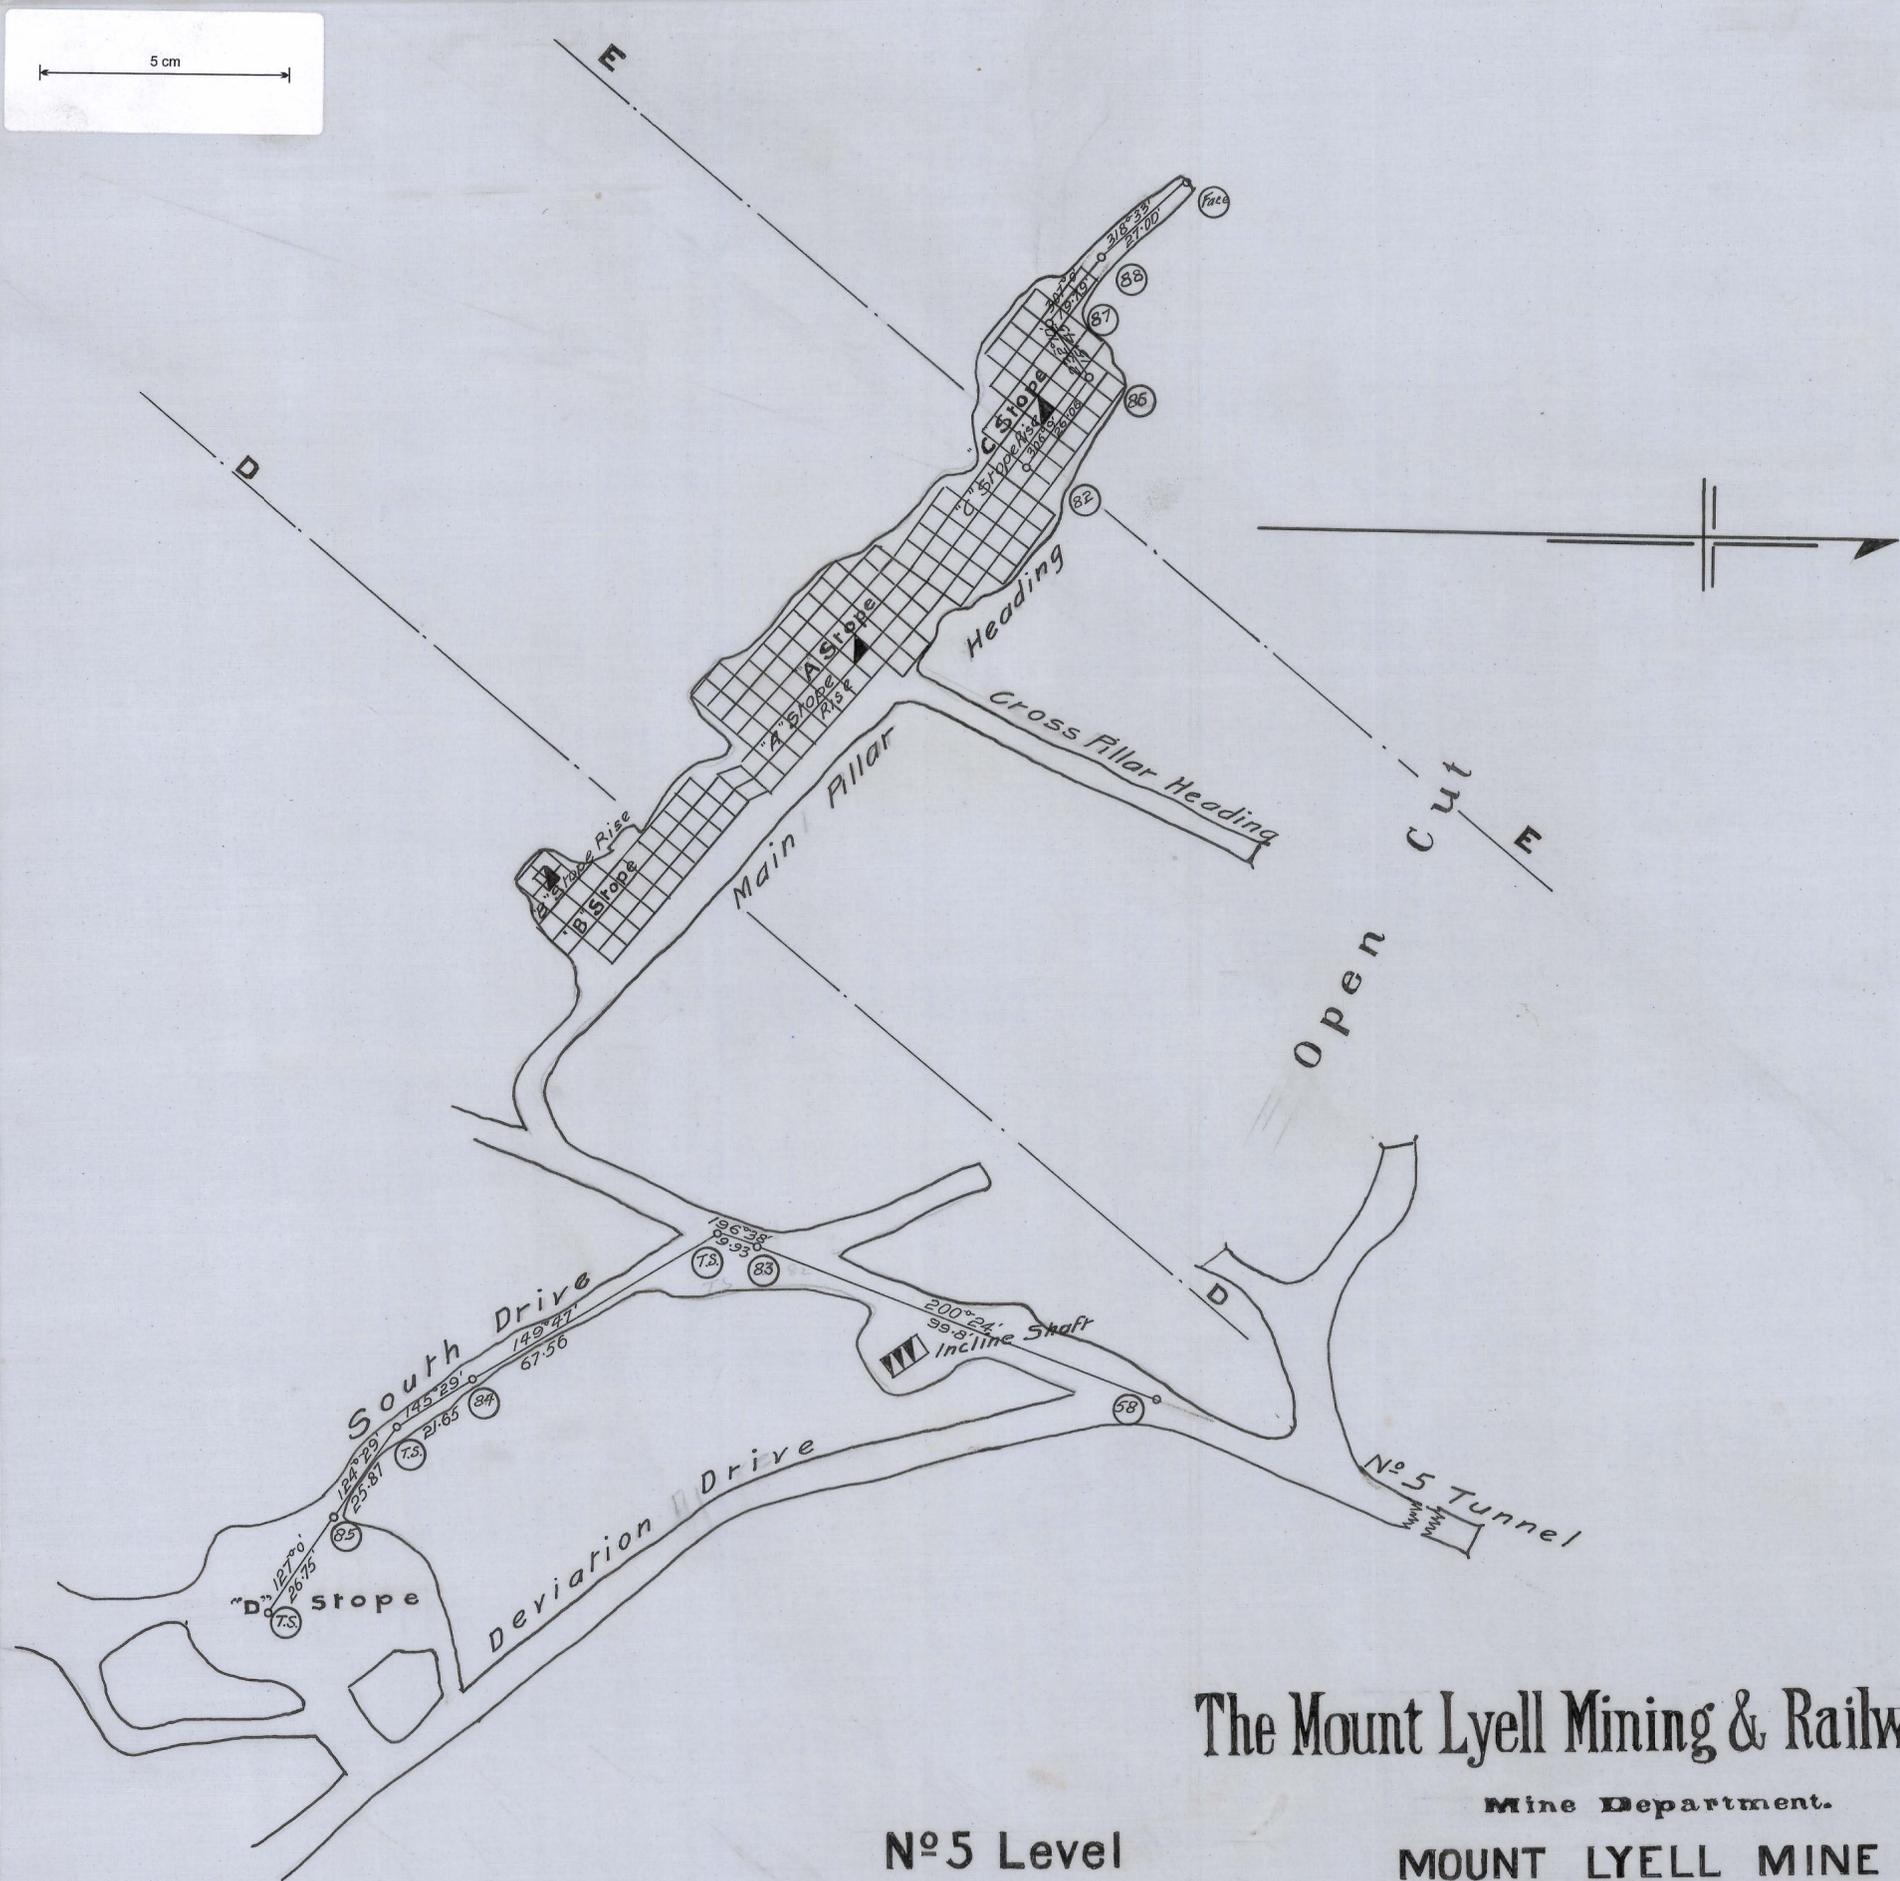

The Mount Lyell Mining & Railway Co., Ltd.

Mine Department.

MOUNT LYELL MINE

UNDERGROUND WORKINGS. 1923

Scale 1" = 30'

Nº 5 Level

R. H. Murray General Manager
G. Red. Jakins Mine Superintendent