


336
42

5 cm

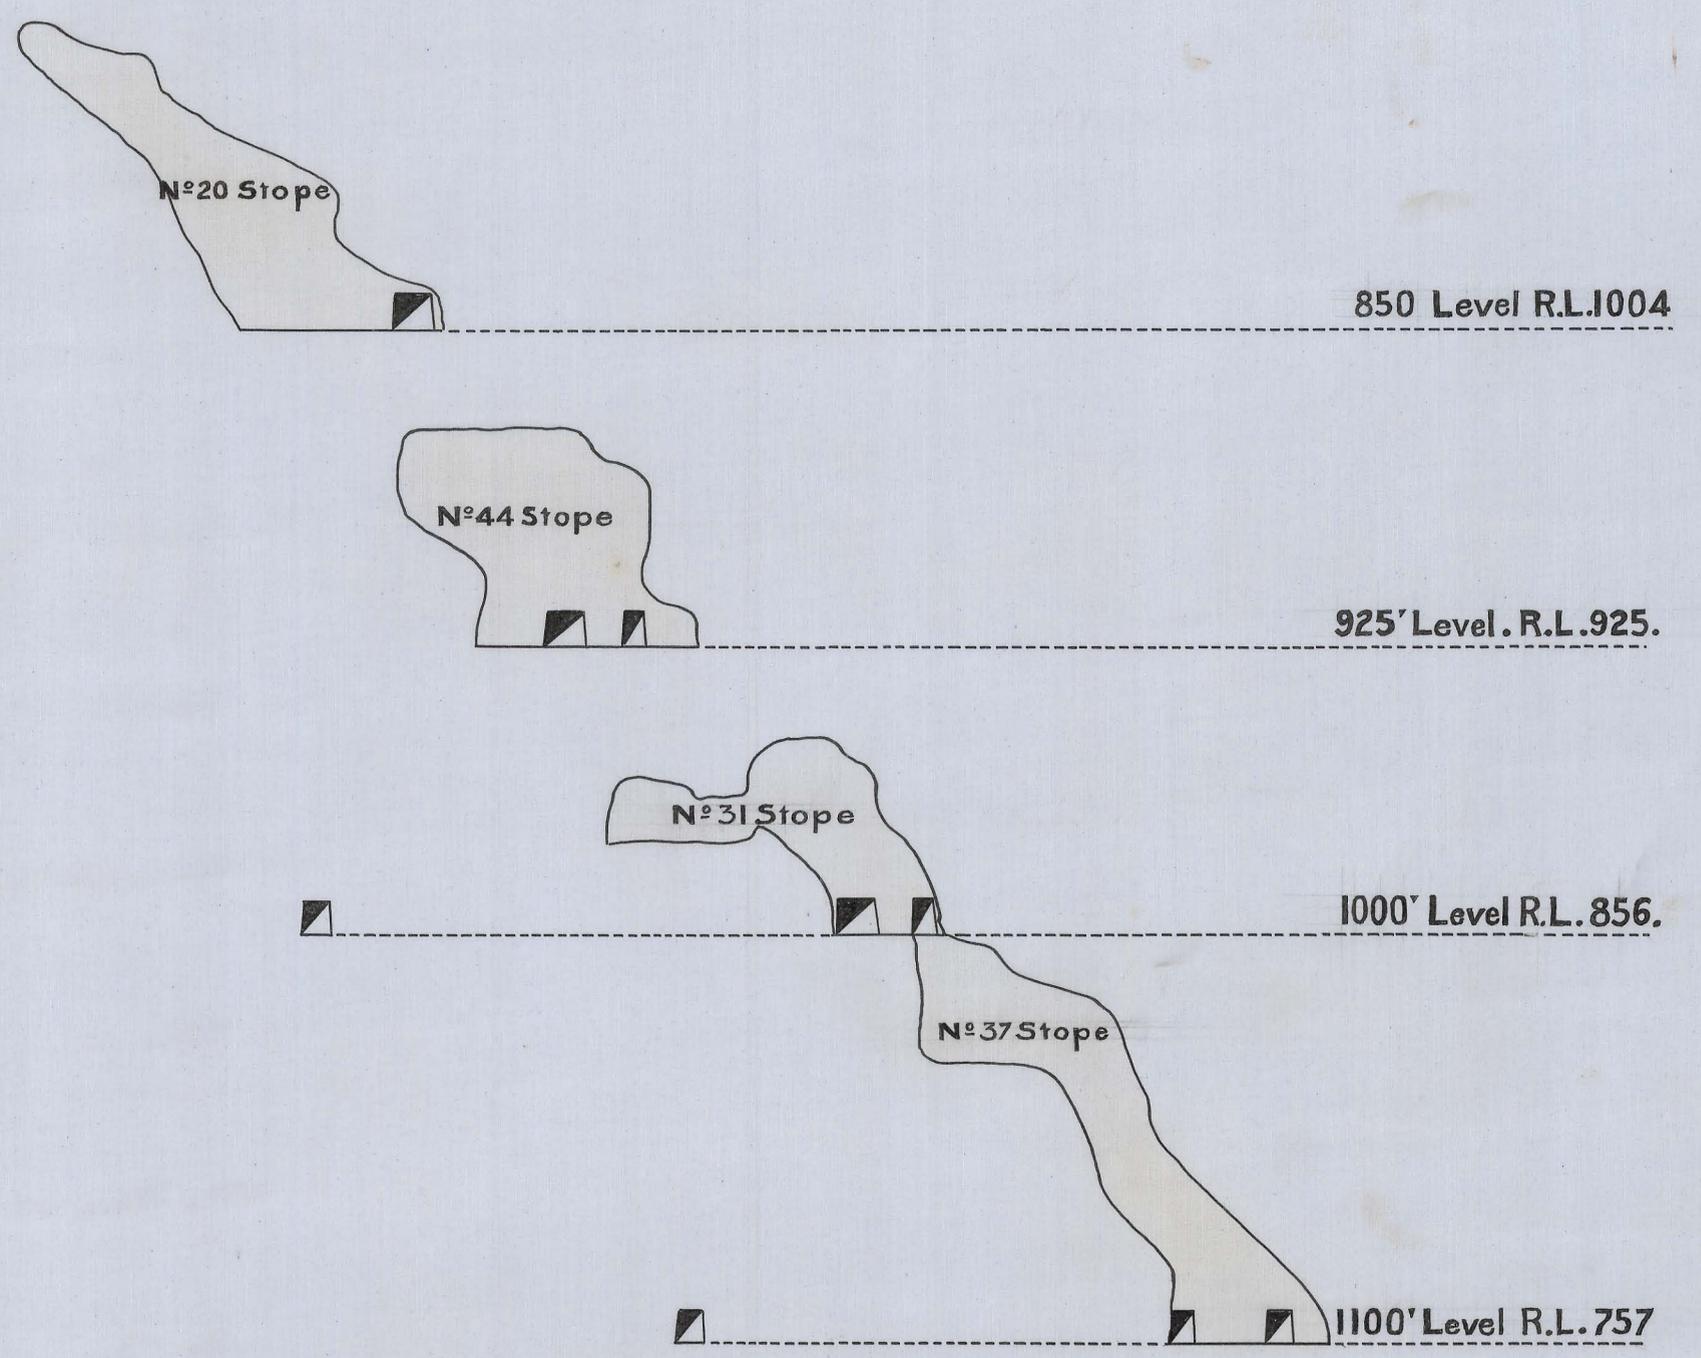

The Mount Lyell Mining & Railway Co., Ltd.

Mine Department

NORTH LYELL MINE Section on Line CC looking North

Brought up to Dec. 31st 1923
Scale 1" = 30'

R. H. Murray General Manager
G. Redford Mine Superintendent