


5 cm

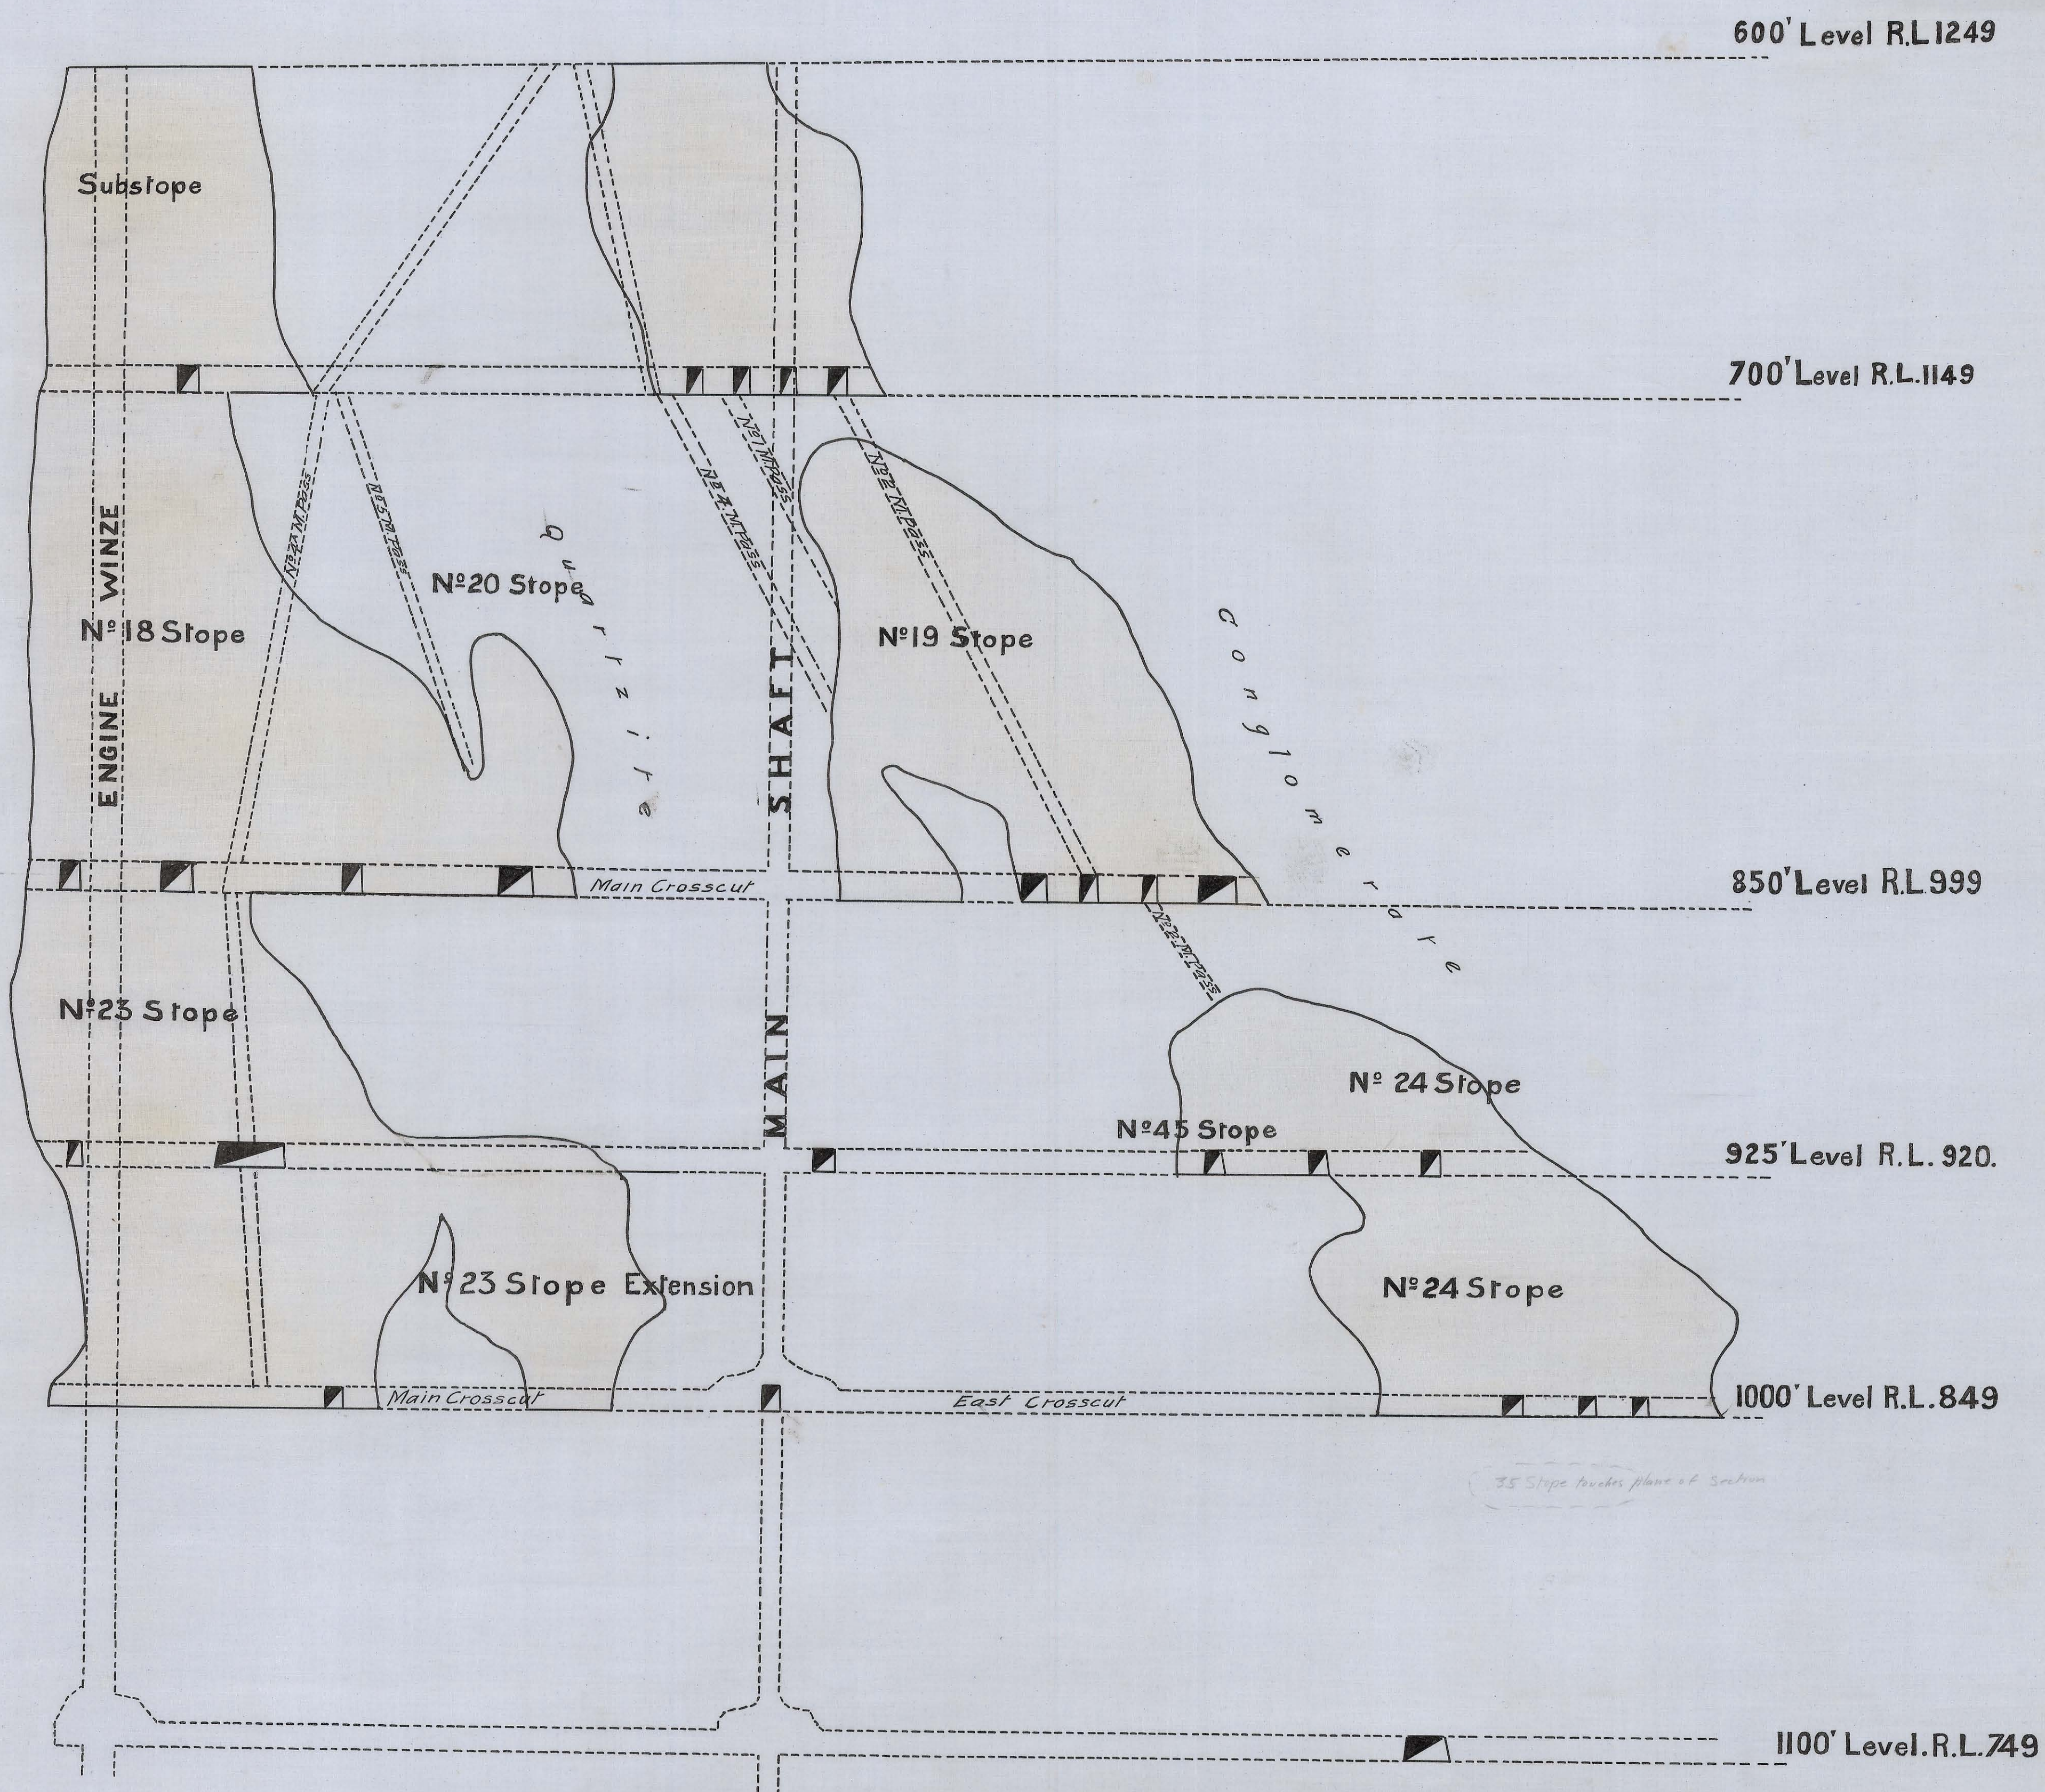

The Mount Lyell Mining & Railway Co. Ltd.

Mine Department

NORTH LYELL MINE

Section on Line BB looking North

Brought up to Dec 31st 1923

Scale 1" = 30'

[Signature] General Manager
[Signature] Mine Superintendent