


336  
47

5 cm

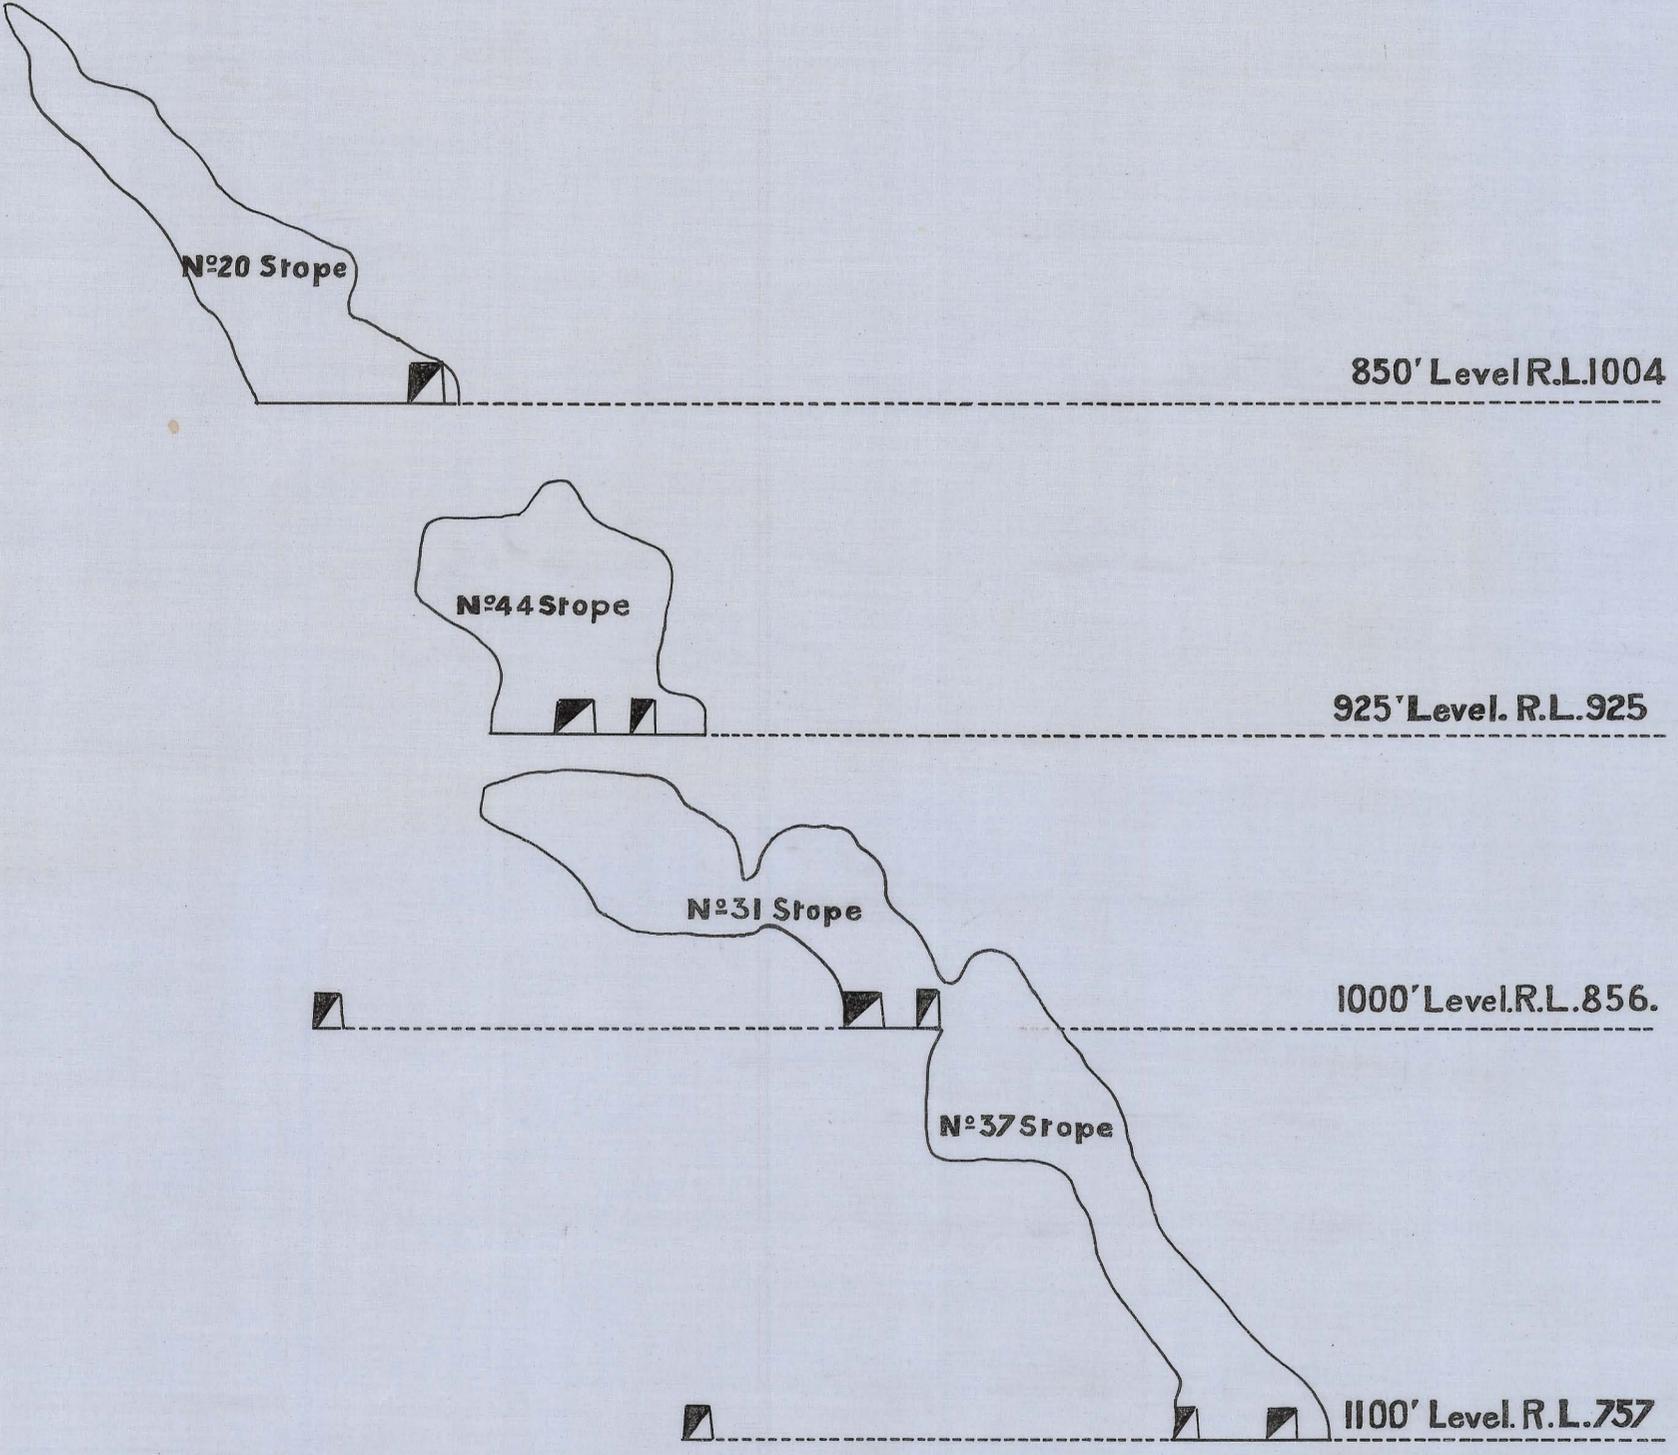

# The Mount Lyell Mining & Railway Co., Ltd.

Mine Department

## NORTH LYELL MINE Section on Line C C looking North

Brought up to Dec. 31<sup>st</sup> 1926  
Scale 1" = 30'

*R. H. ...* General Manager  
*G. Fred ...* Mine Superintendent