
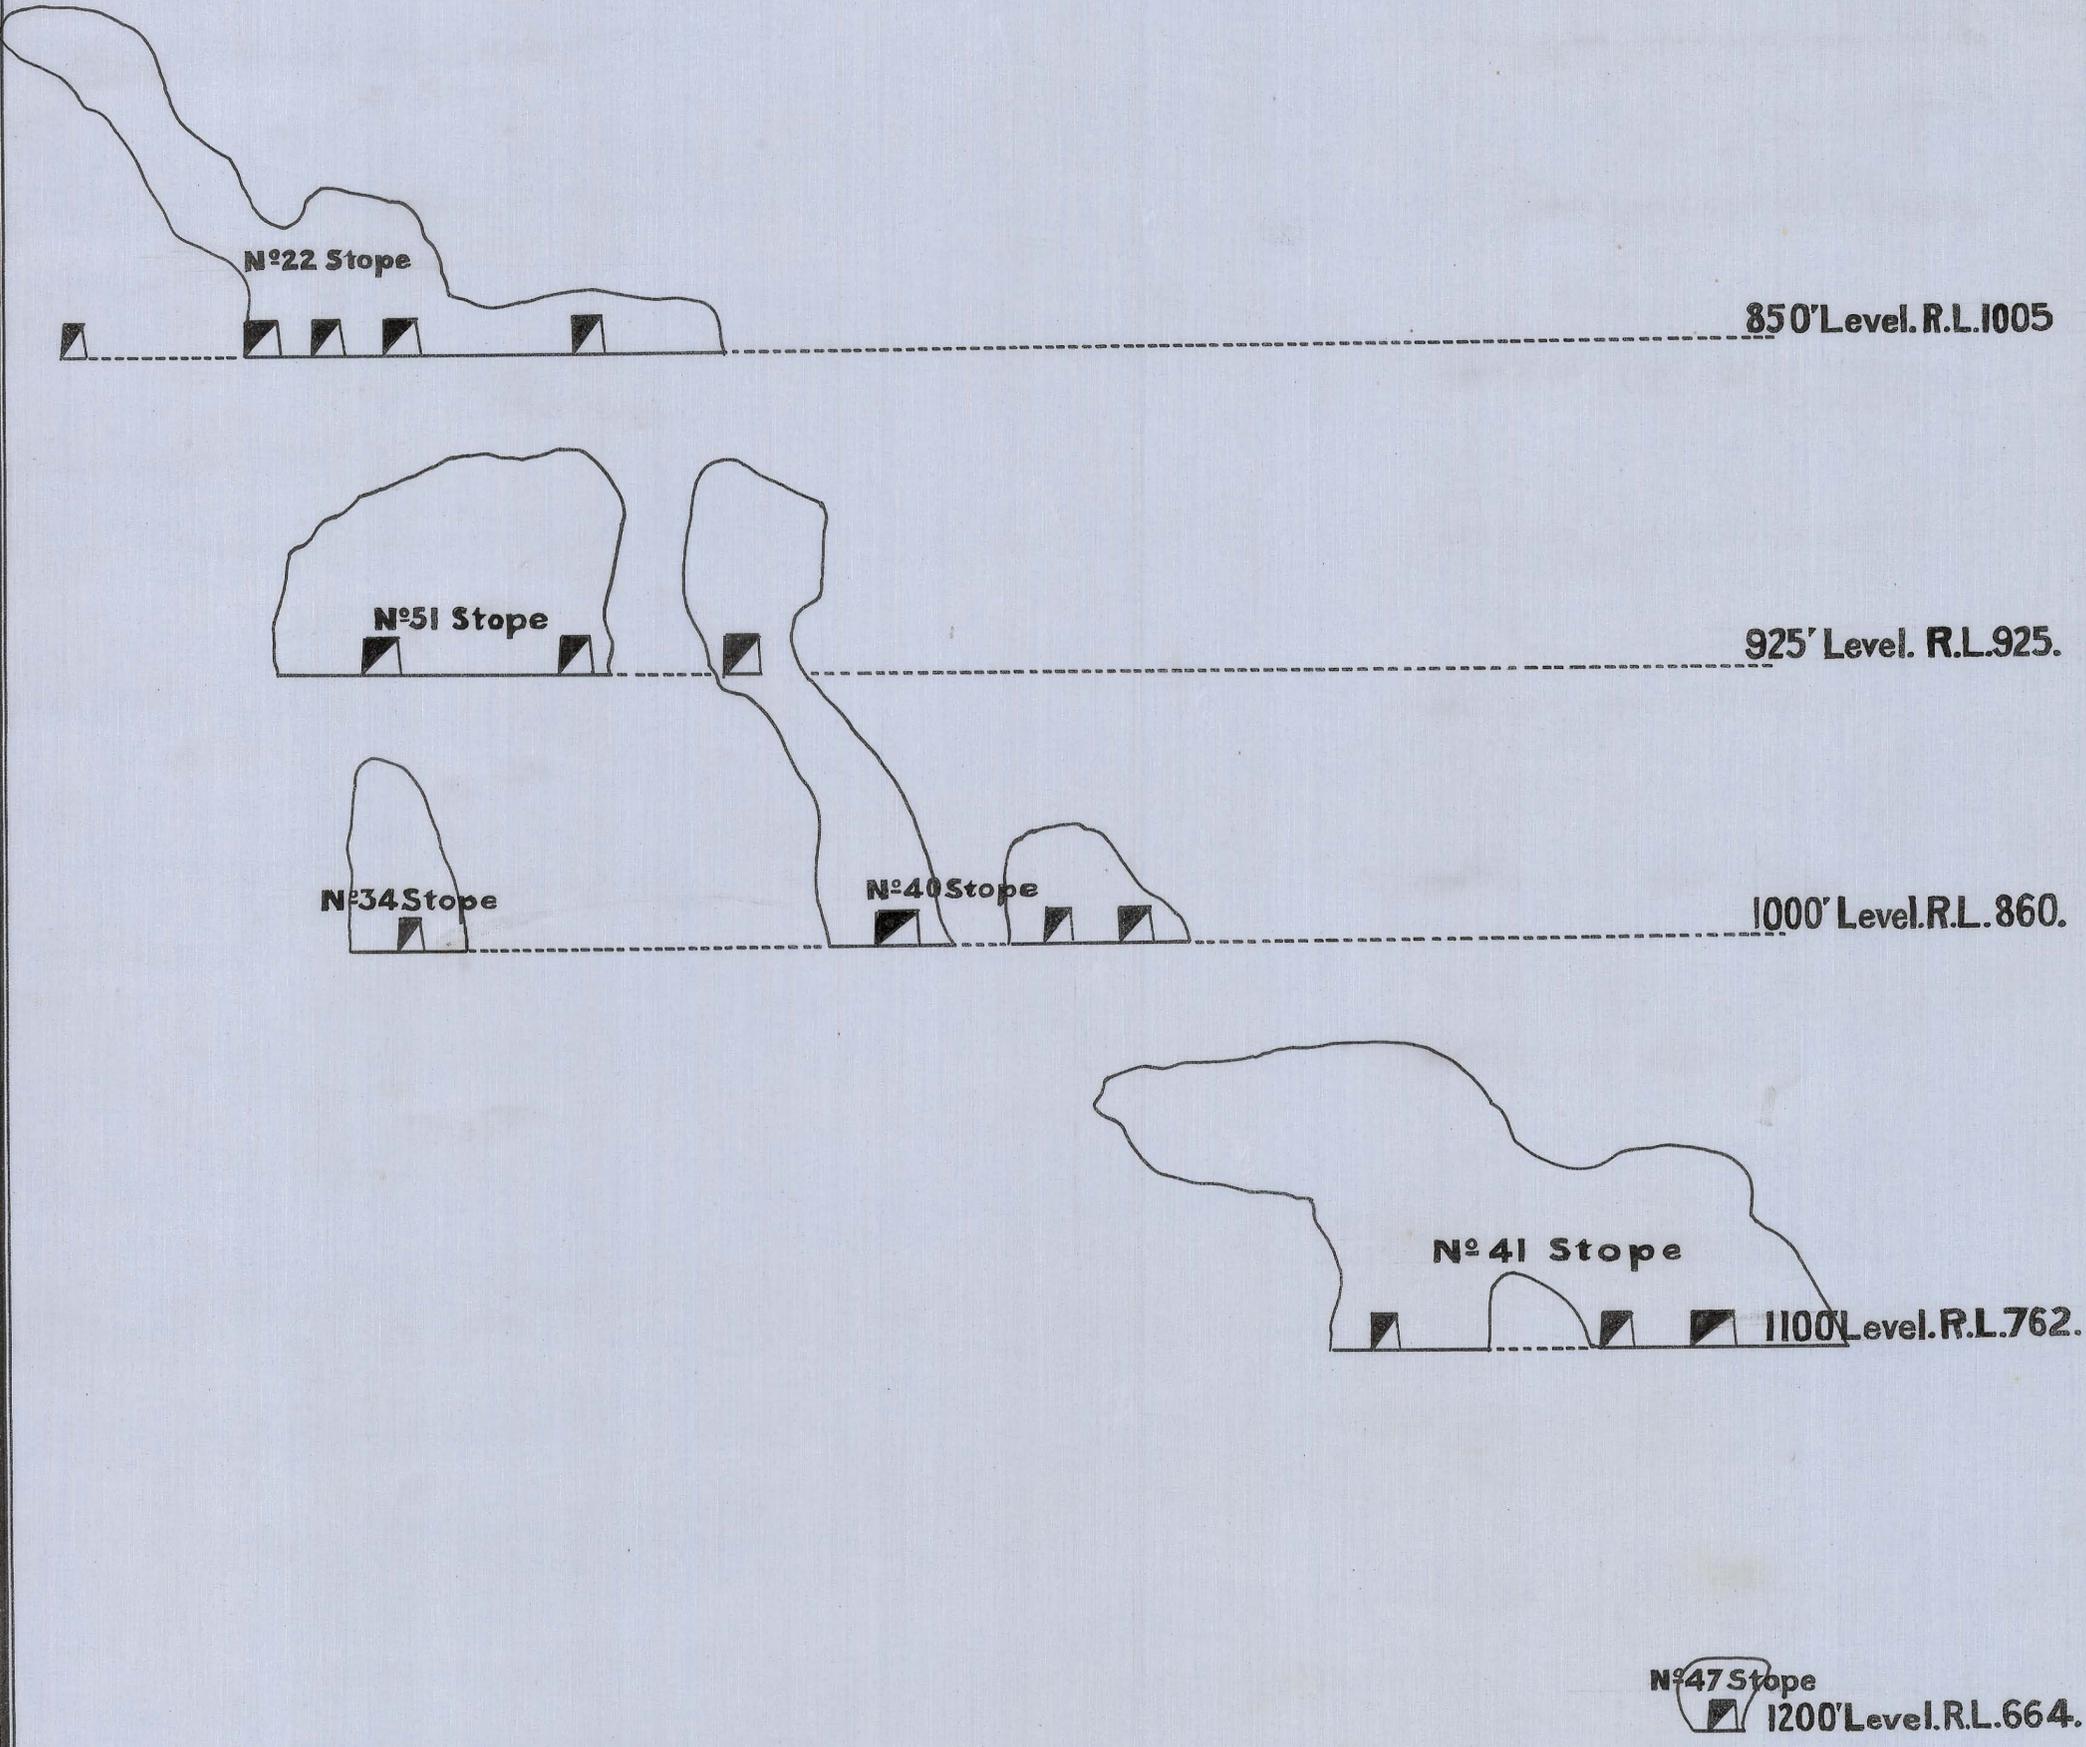


336  
48

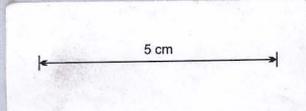

# The Mount Lyell Mining & Railway Co., Ltd.

Mine Department

## NORTH LYELL MINE

Section on Line DD looking North

Brought up to Dec. 31<sup>st</sup> 1926

Scale ÷ 1" = 30'

*[Signature]* General Manager  
*[Signature]* Mine Superintendent