


336
49

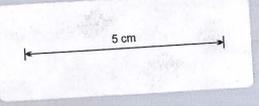

600' Level R.L. 1249.


700' Level R.L. 1149.

850' Level R.L. 999.

925' Level R.L. 920.

1000' Level R.L. 849.

1100' Level R.L. 749.

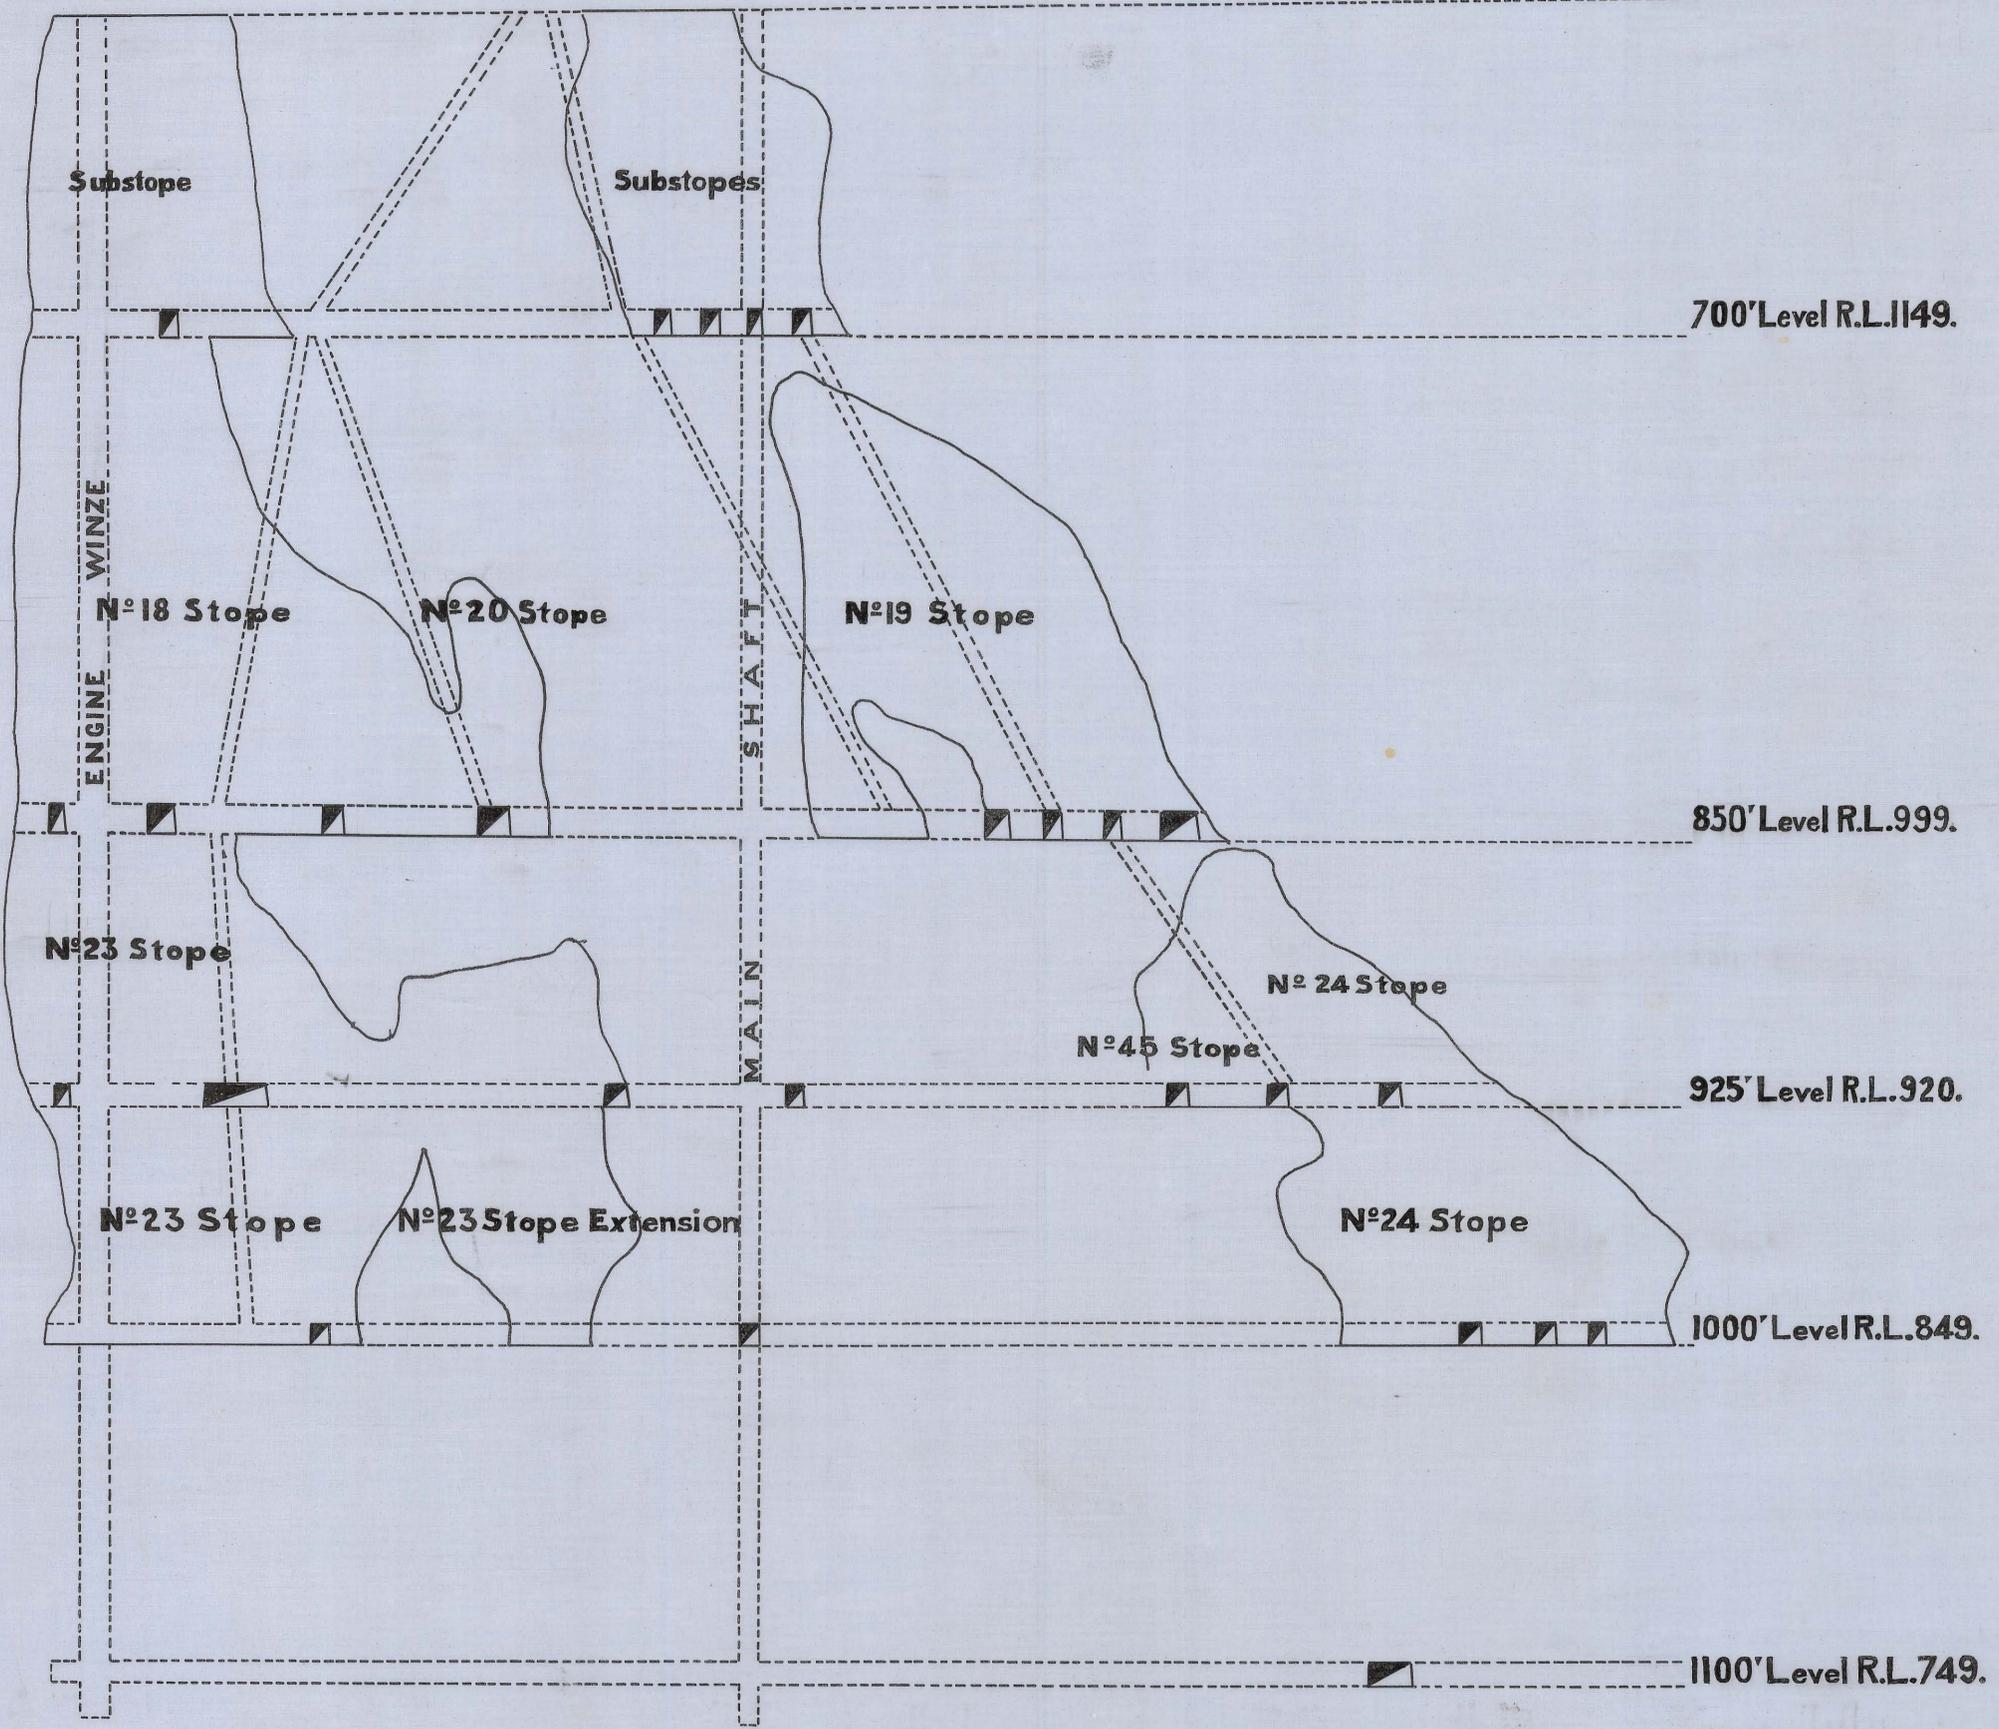

The Mount Lyell Mining & Railway Co. Ltd.

Mine Department
NORTH LYELL MINE
Section on Line BB looking North

Brought up to Dec. 31st 1926
Scale ÷ 1" = 30'

R. J. ... General Manager
J. ... Mine Superintendent