


336
Q

5 cm

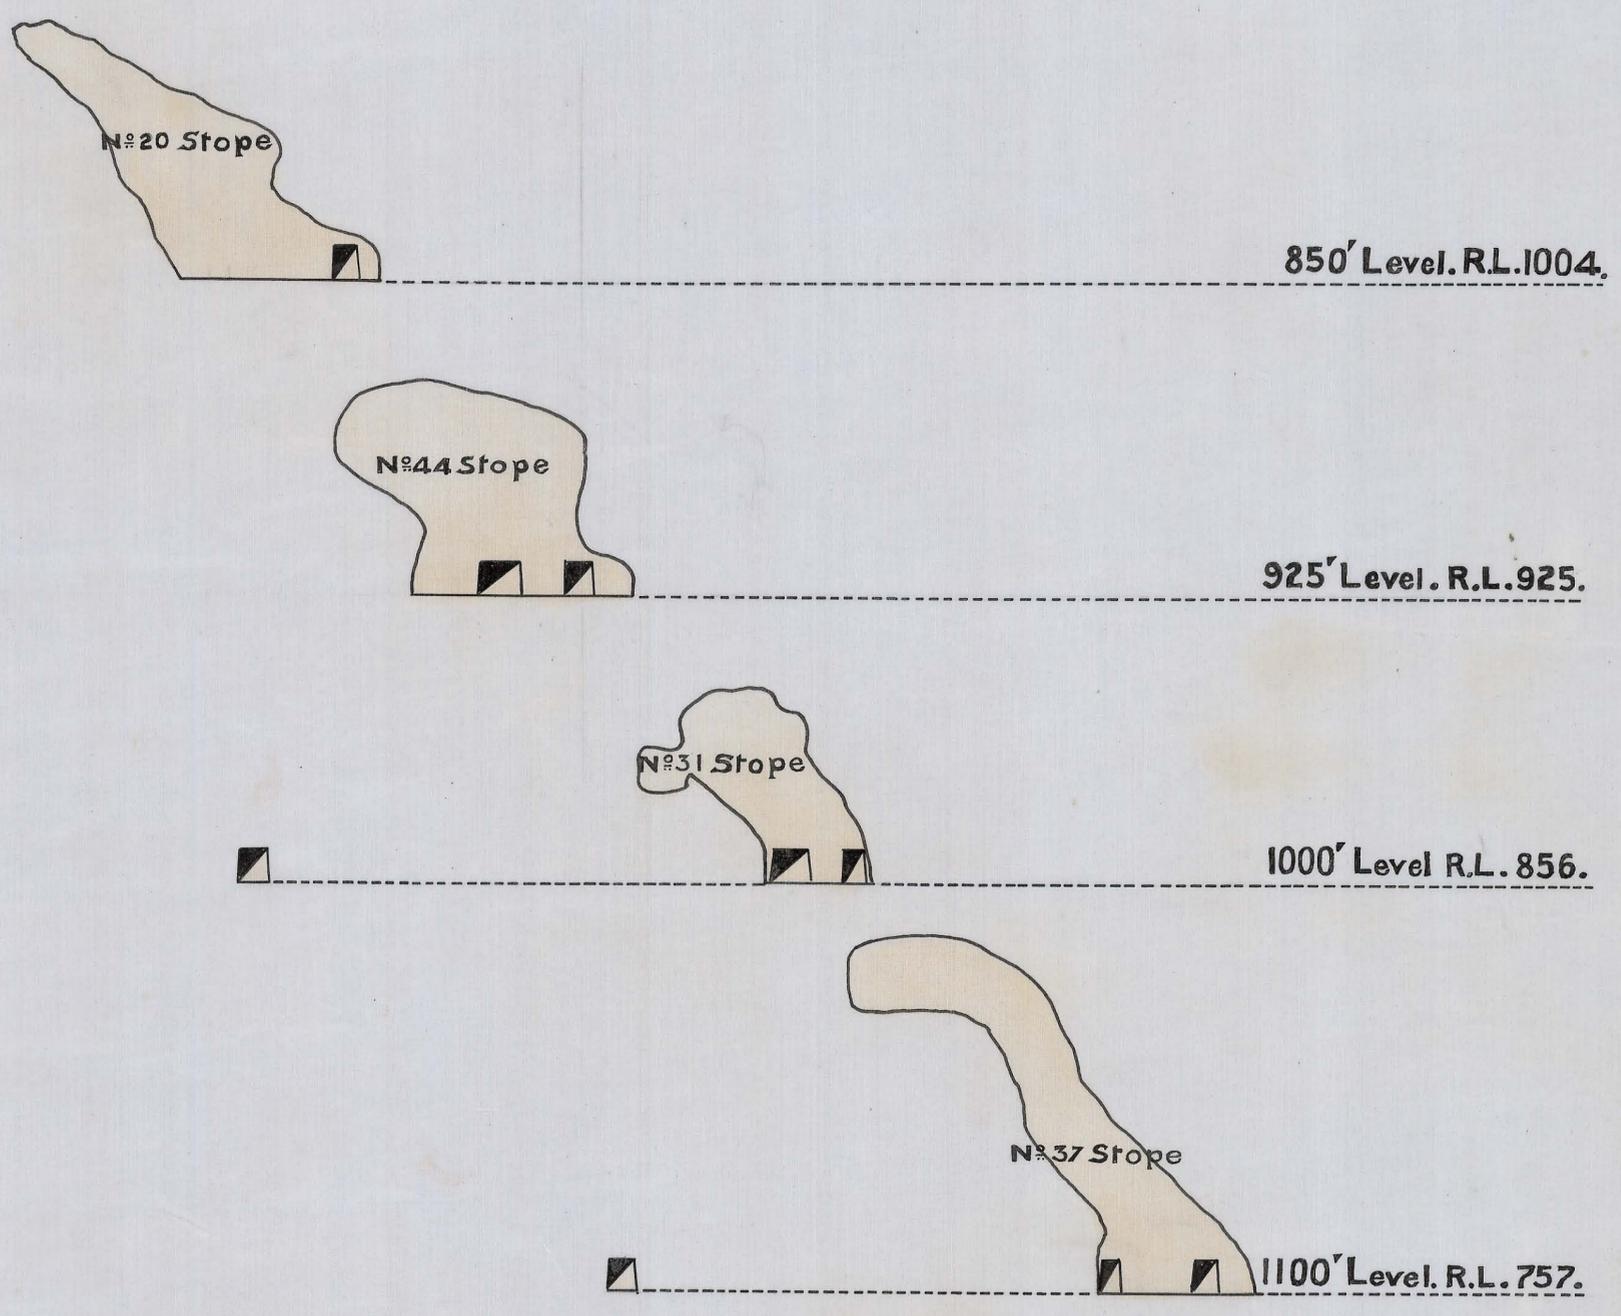

The Mount Lyell Mining & Railway Co., Ltd.

Mine Department

NORTH LYELL MINE Section on Line CC looking North

Brought up to Dec 31st 1922

Scale 1" = 30'

R. H. ... General Manager
G. Red. Jakub Mine Superintendent