

336
53



5 cm



850' Level. R.L. 1005.




925' Level. R.L. 925.

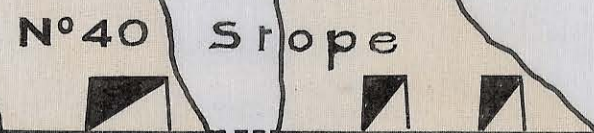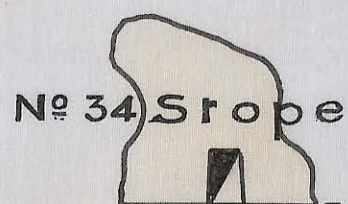

1000' Level R.L. 860.



1100' Level. R.L. 762

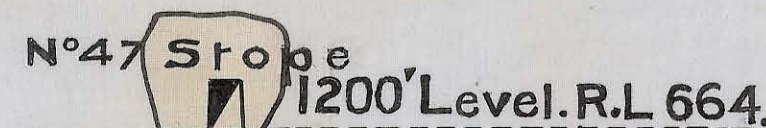

1200' Level. R.L. 664.

The Mount Lyell Mining & Railway Co., Ltd.

Mine Department

NORTH LYELL MINE

Section on Line DD looking North

Brought up to Dec 31st 1922

Scale 1" = 30'

R. H. Murray General Manager
G. H. J. ... Mine Superintendent