


336
54

5 cm

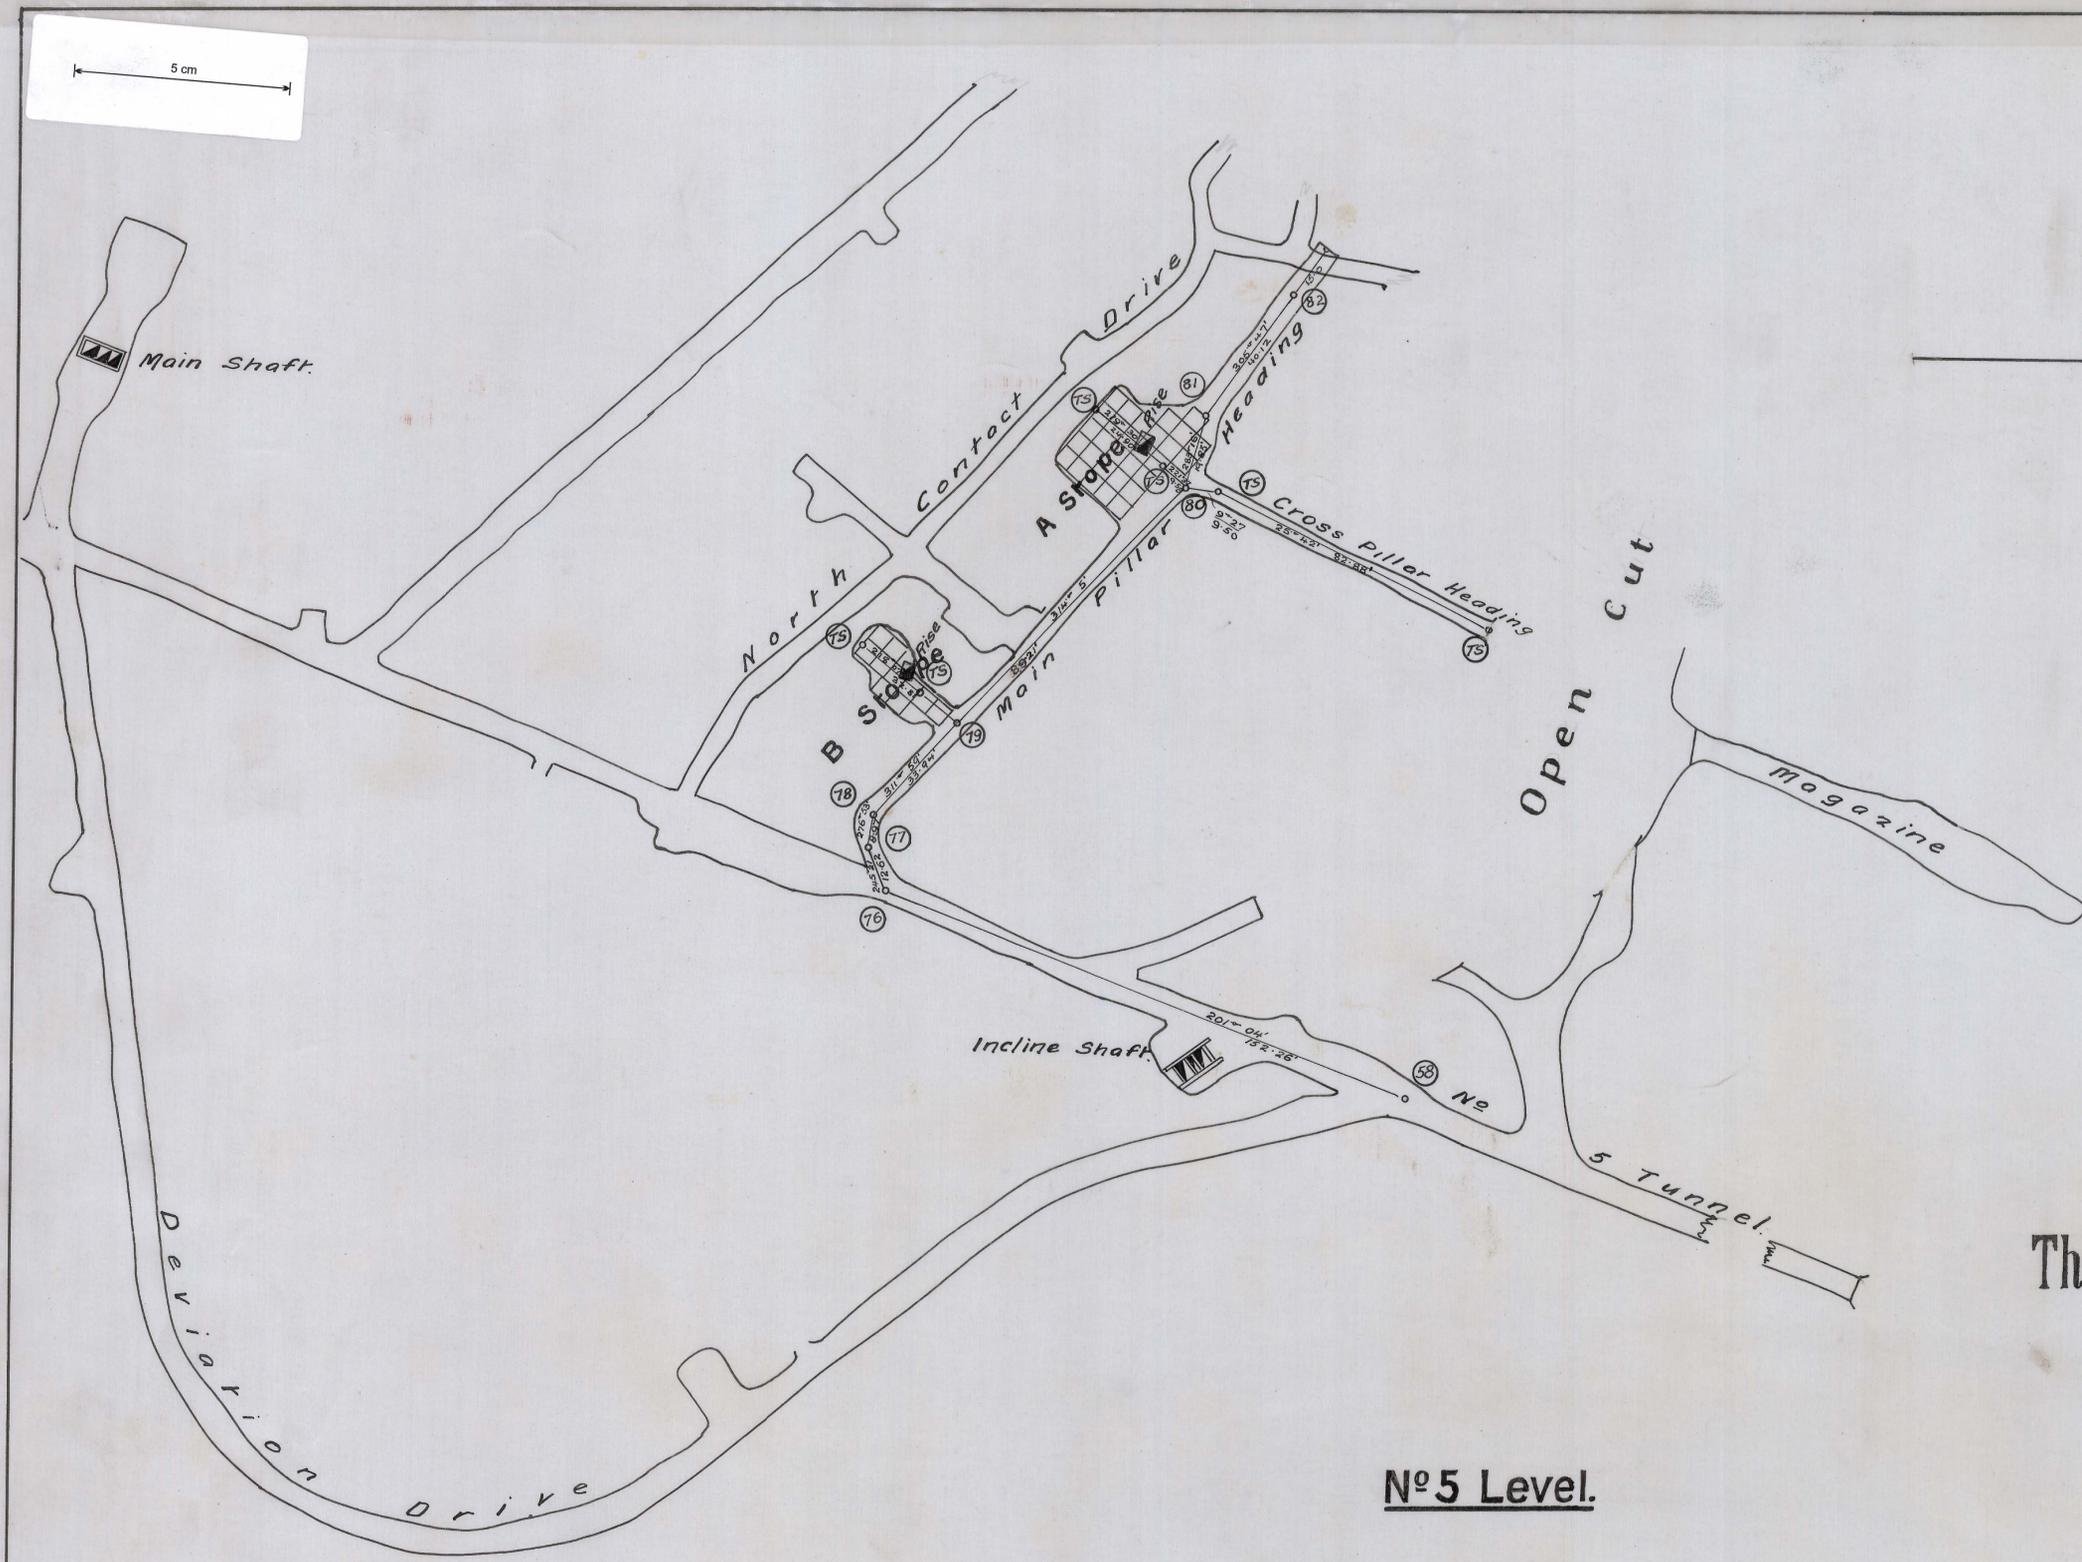

The Mount Lyell Mining & Railway Co., Ltd.

Mine Department.

MOUNT LYELL MINE

UNDERGROUND WORKINGS. 1922

SCALE: 1 INCH = 30 FEET

N°5 Level.

P. W. Murray General Manager
G. Fred. Jakins Mine Superintendent

11-10-23