


337-01

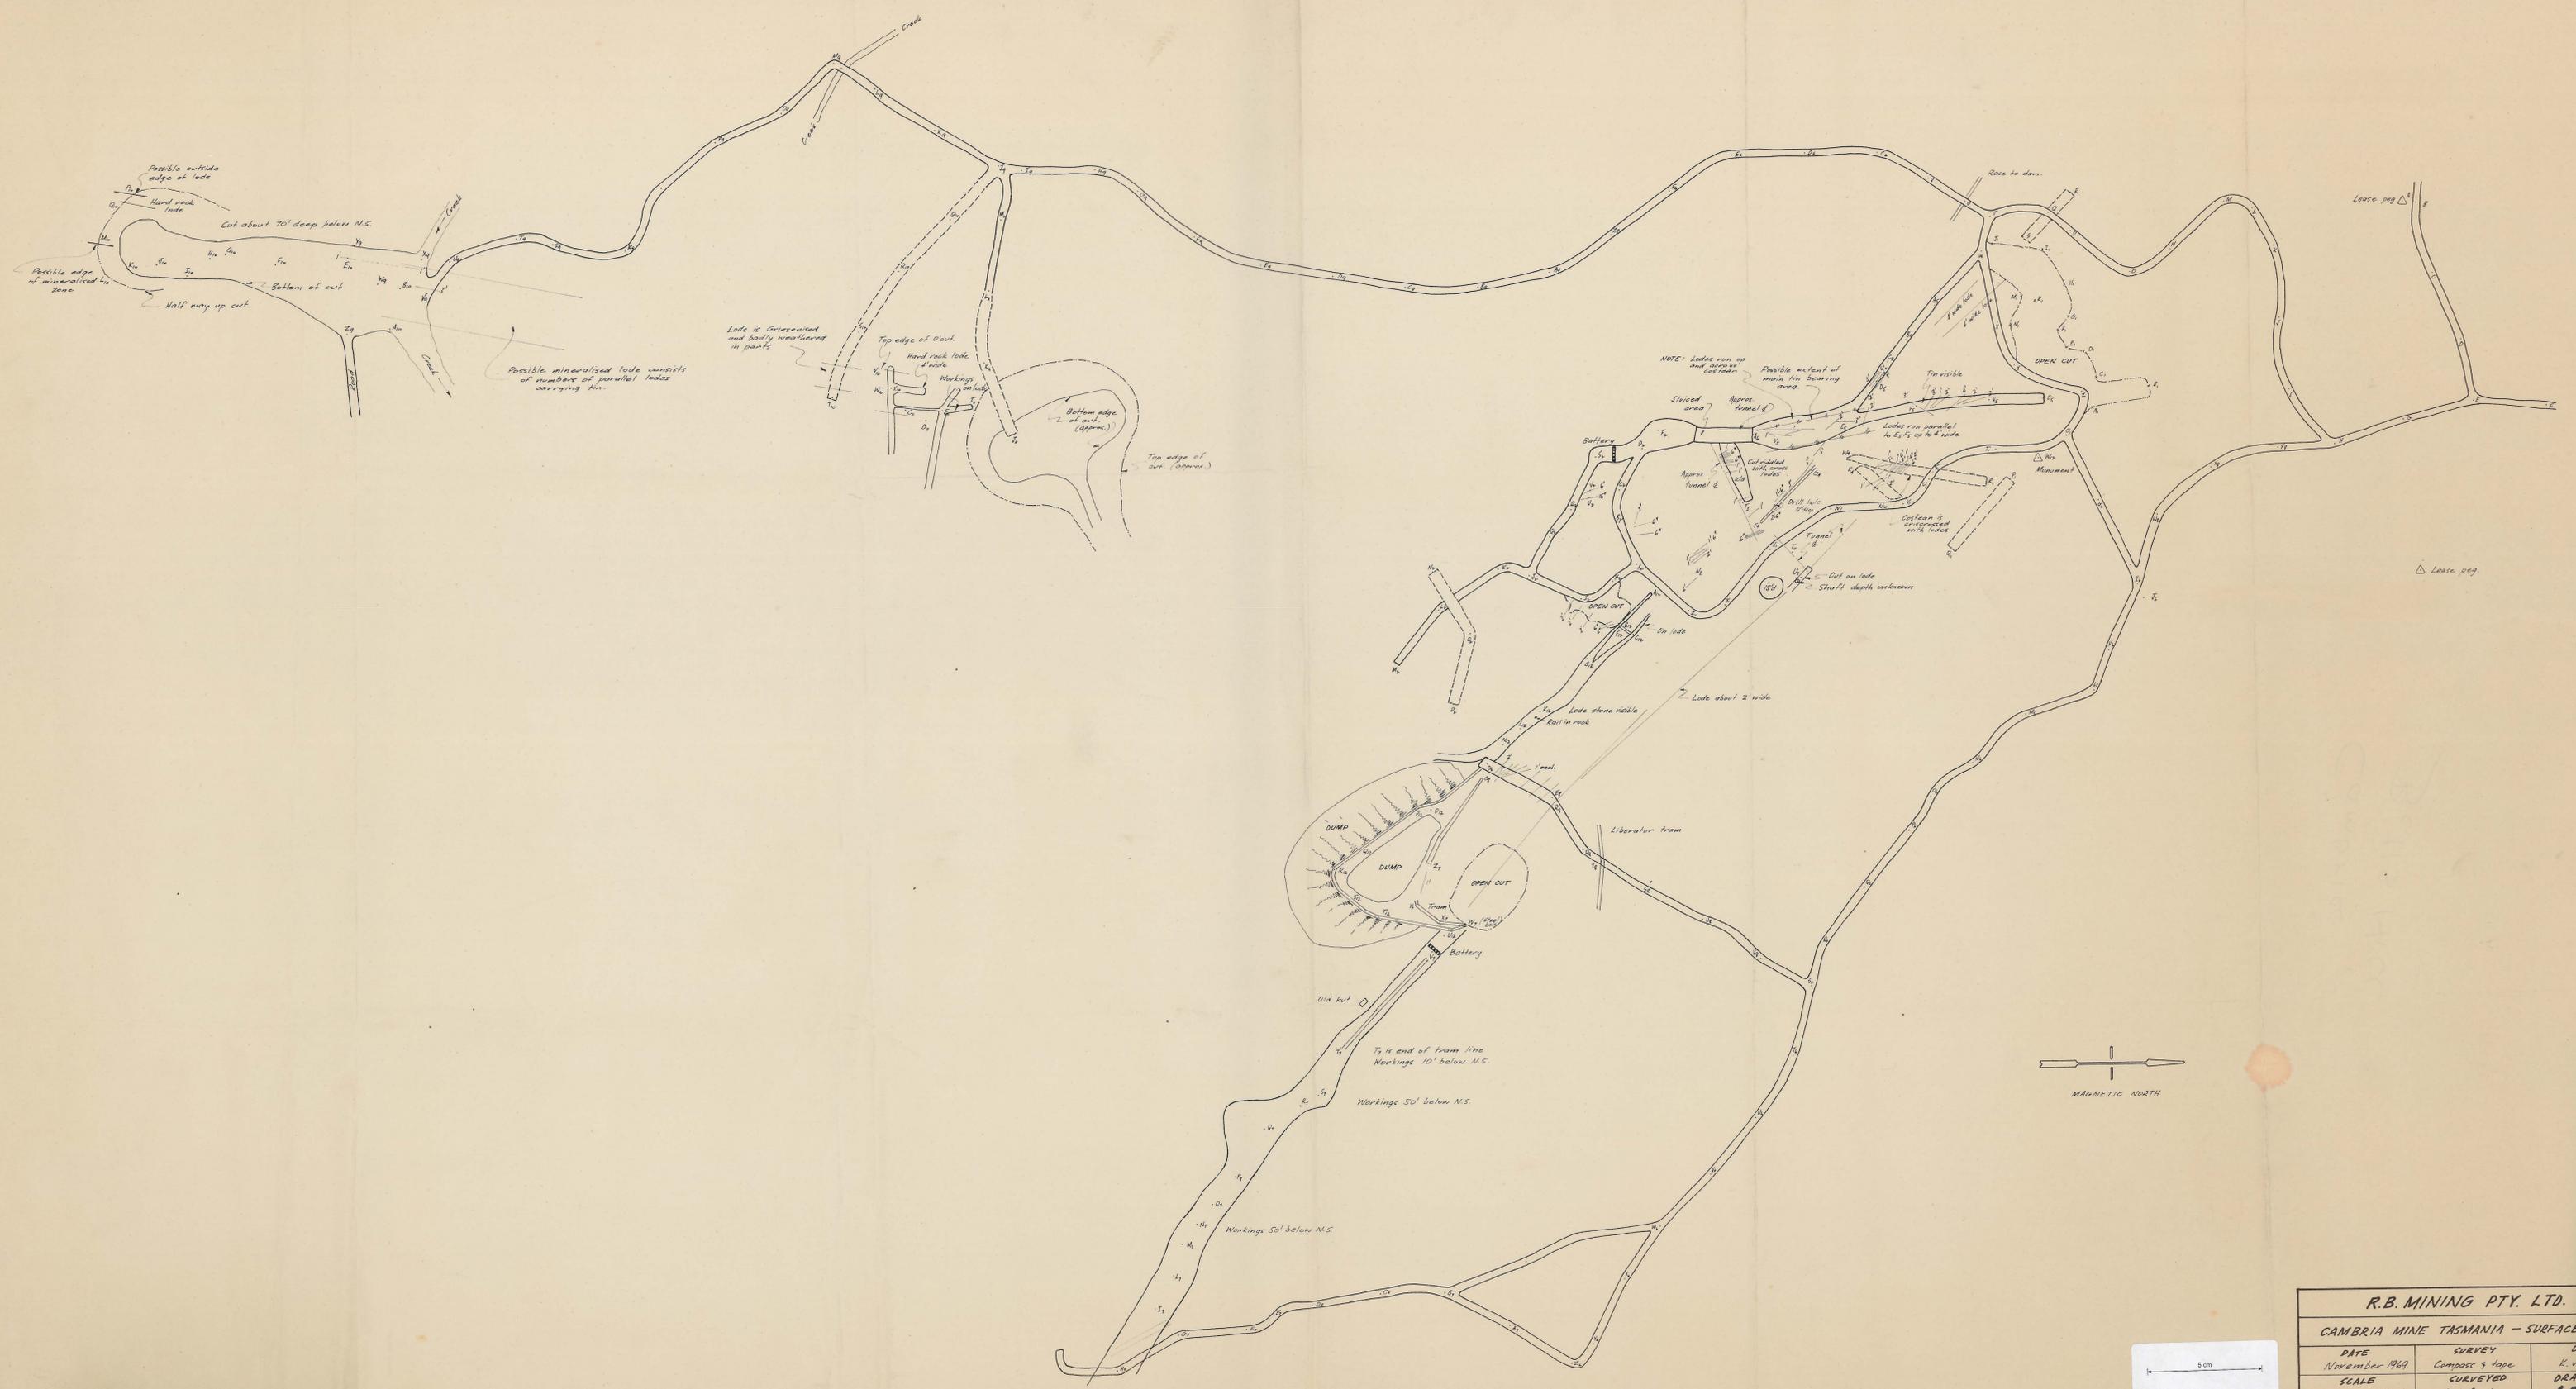

R.B. MINING PTY. LTD.		
CAMBRIA MINE TASMANIA - SURFACE PLAN.		
DATE November 1969.	SURVEY Compass & tape	DRAWN K.V. Roche
SCALE 1 inch = 80 feet	CURVEYED K.V. Roche	DRAWING No. 65-5