



22

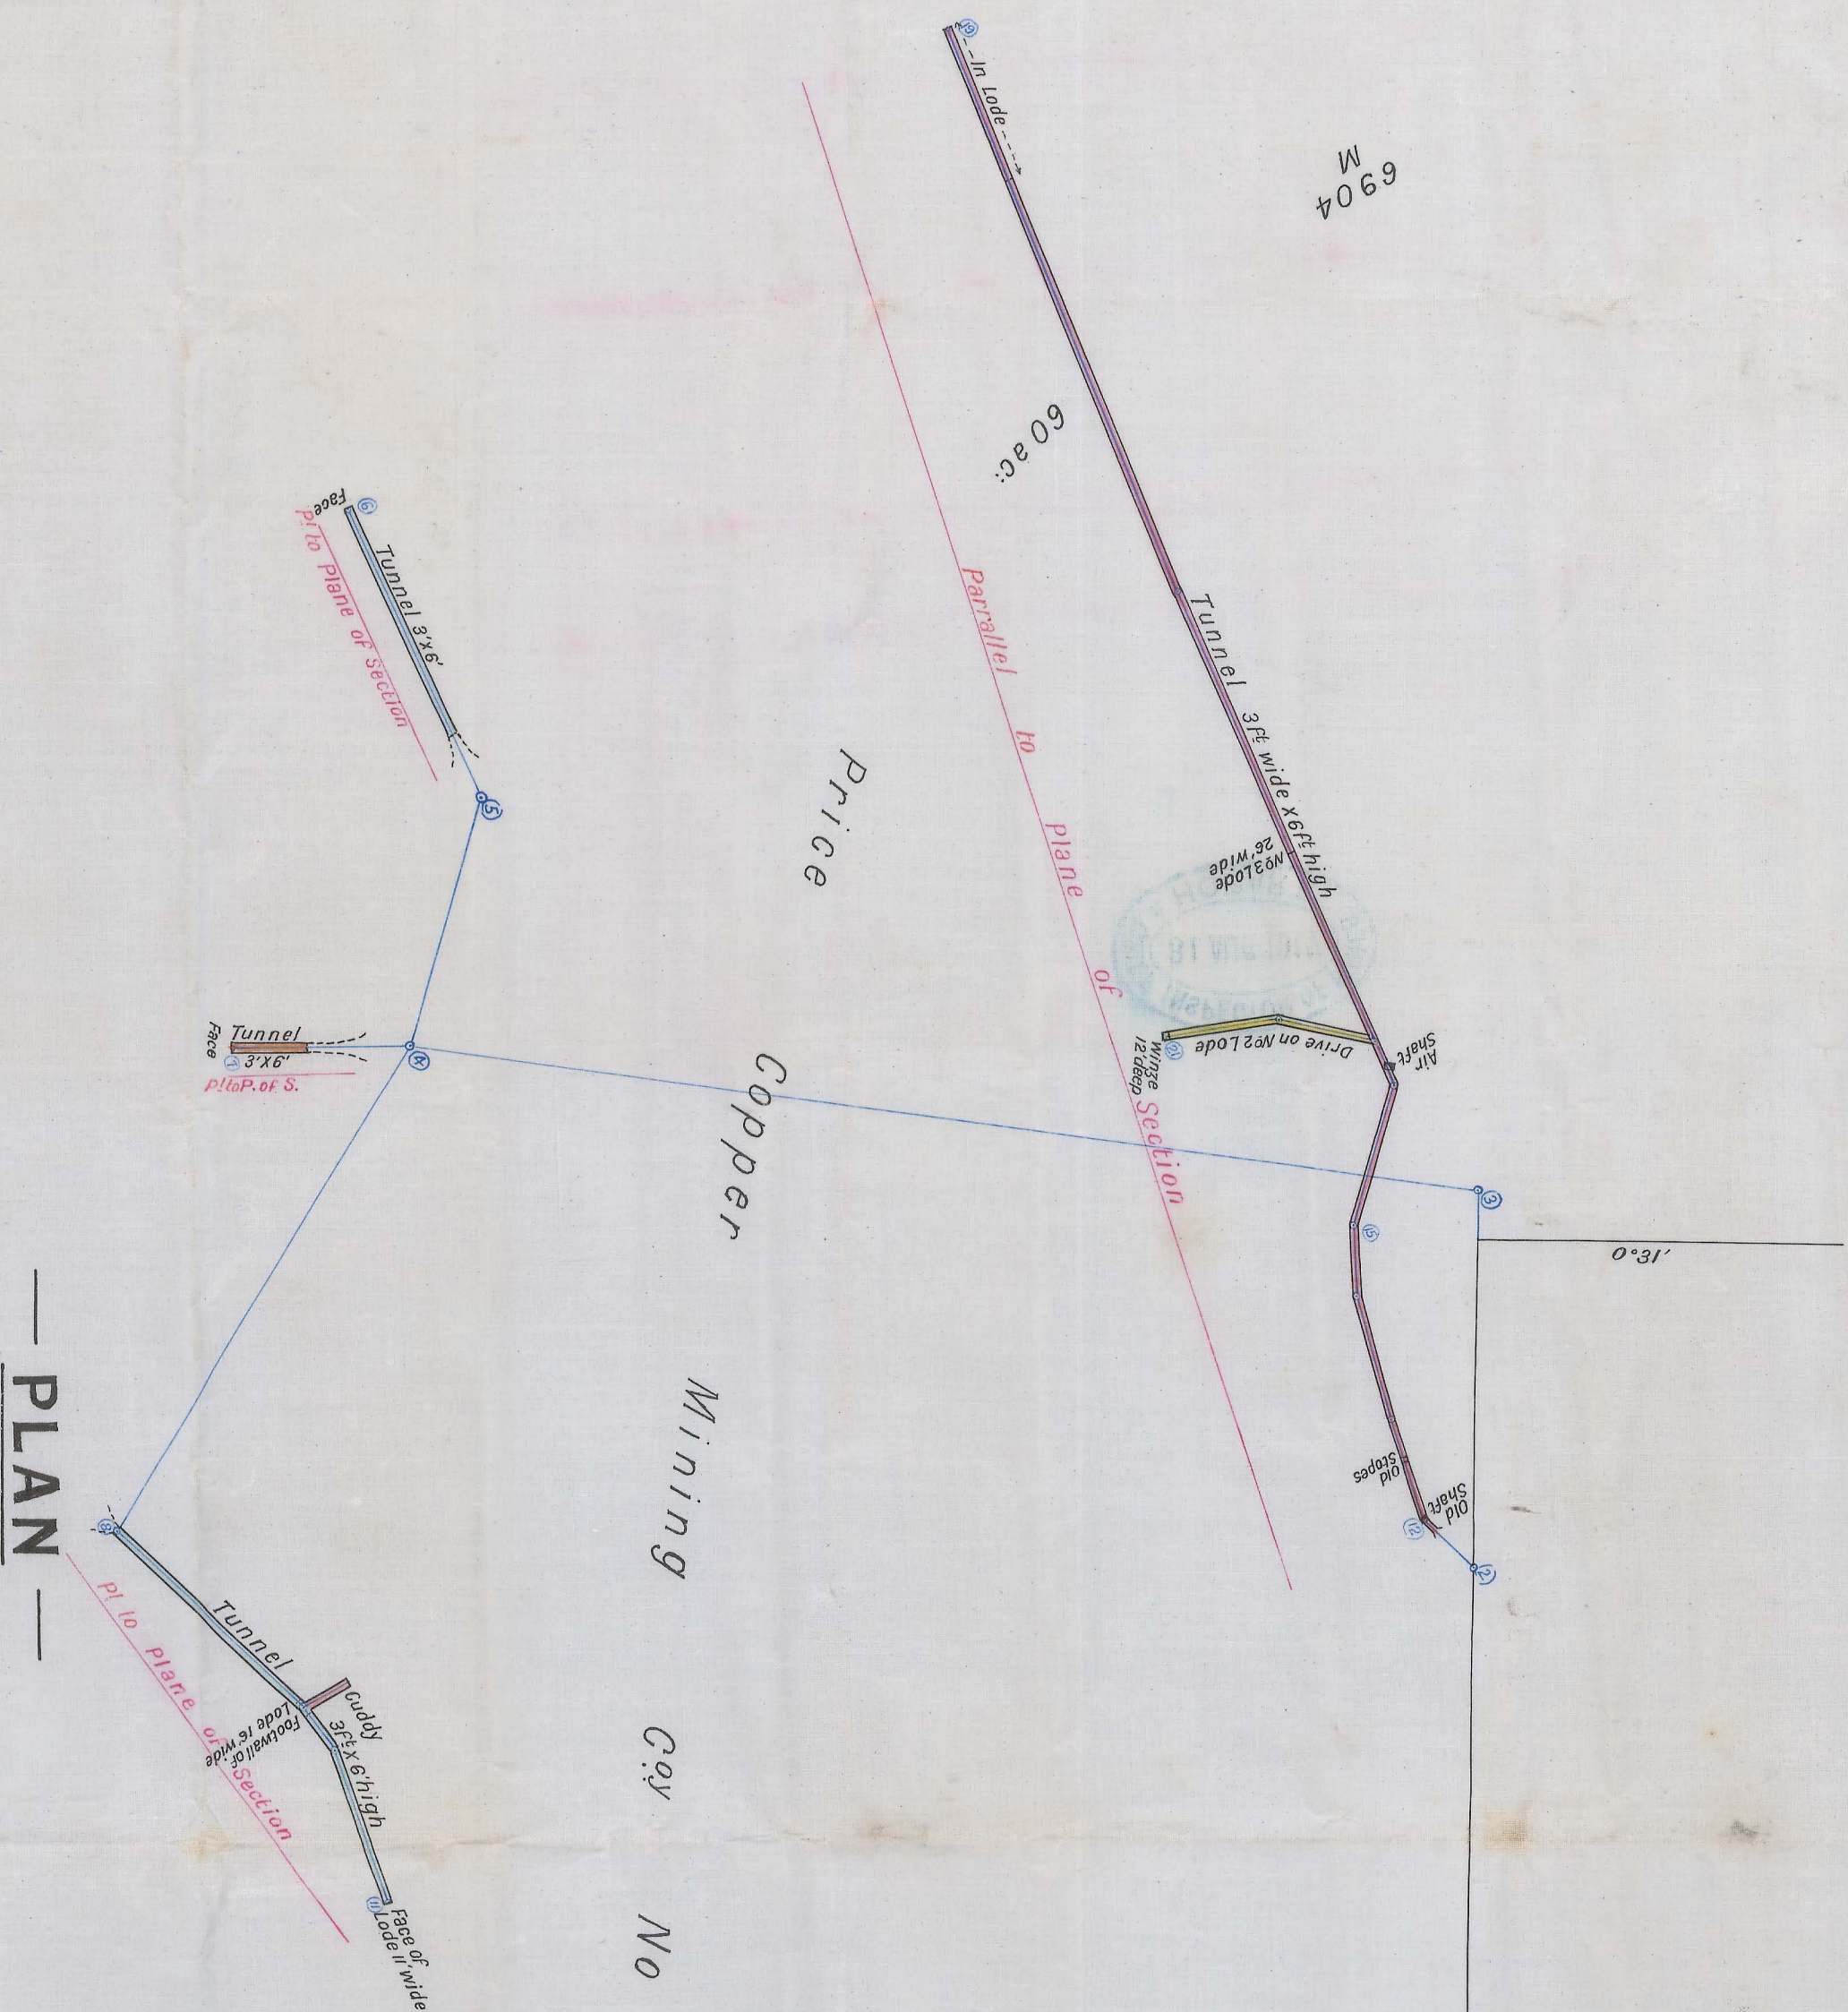

PLAN

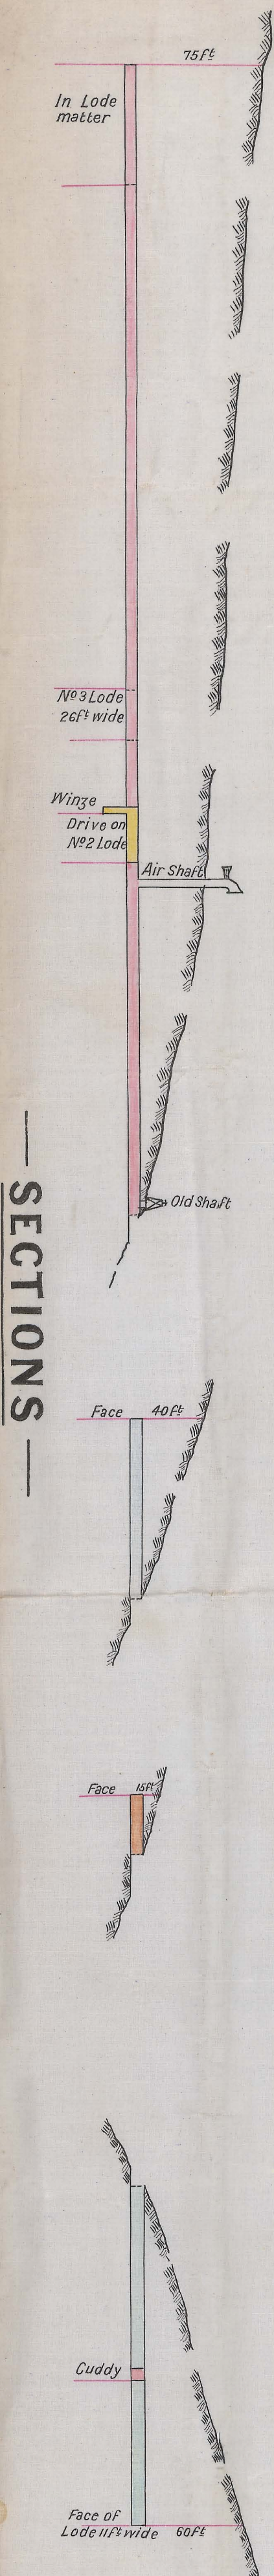

SECTIONS

PRICE COPPER MINE

COUNTY OF WELLINGTON

PARISH OF STOWPORT

Scale-1 chain to an inch

H. F. Miles
District Surveyor

500
 100
 100