

# NORTH CROWN LYELL M. CO.

Underground Survey For 1900

Scale 25 feet = 1 inch


Survey made with 5 Theodolite and steel band



Approved  
Authorized Surveyor  
10th September 1901



N.B. The plan by John B. Lee, bearing date 31 May 1900, was destroyed; it was very roughly drawn, had no lengths or bearings, and no field notes. This plan shows all the work that was contained on the 1900 run.

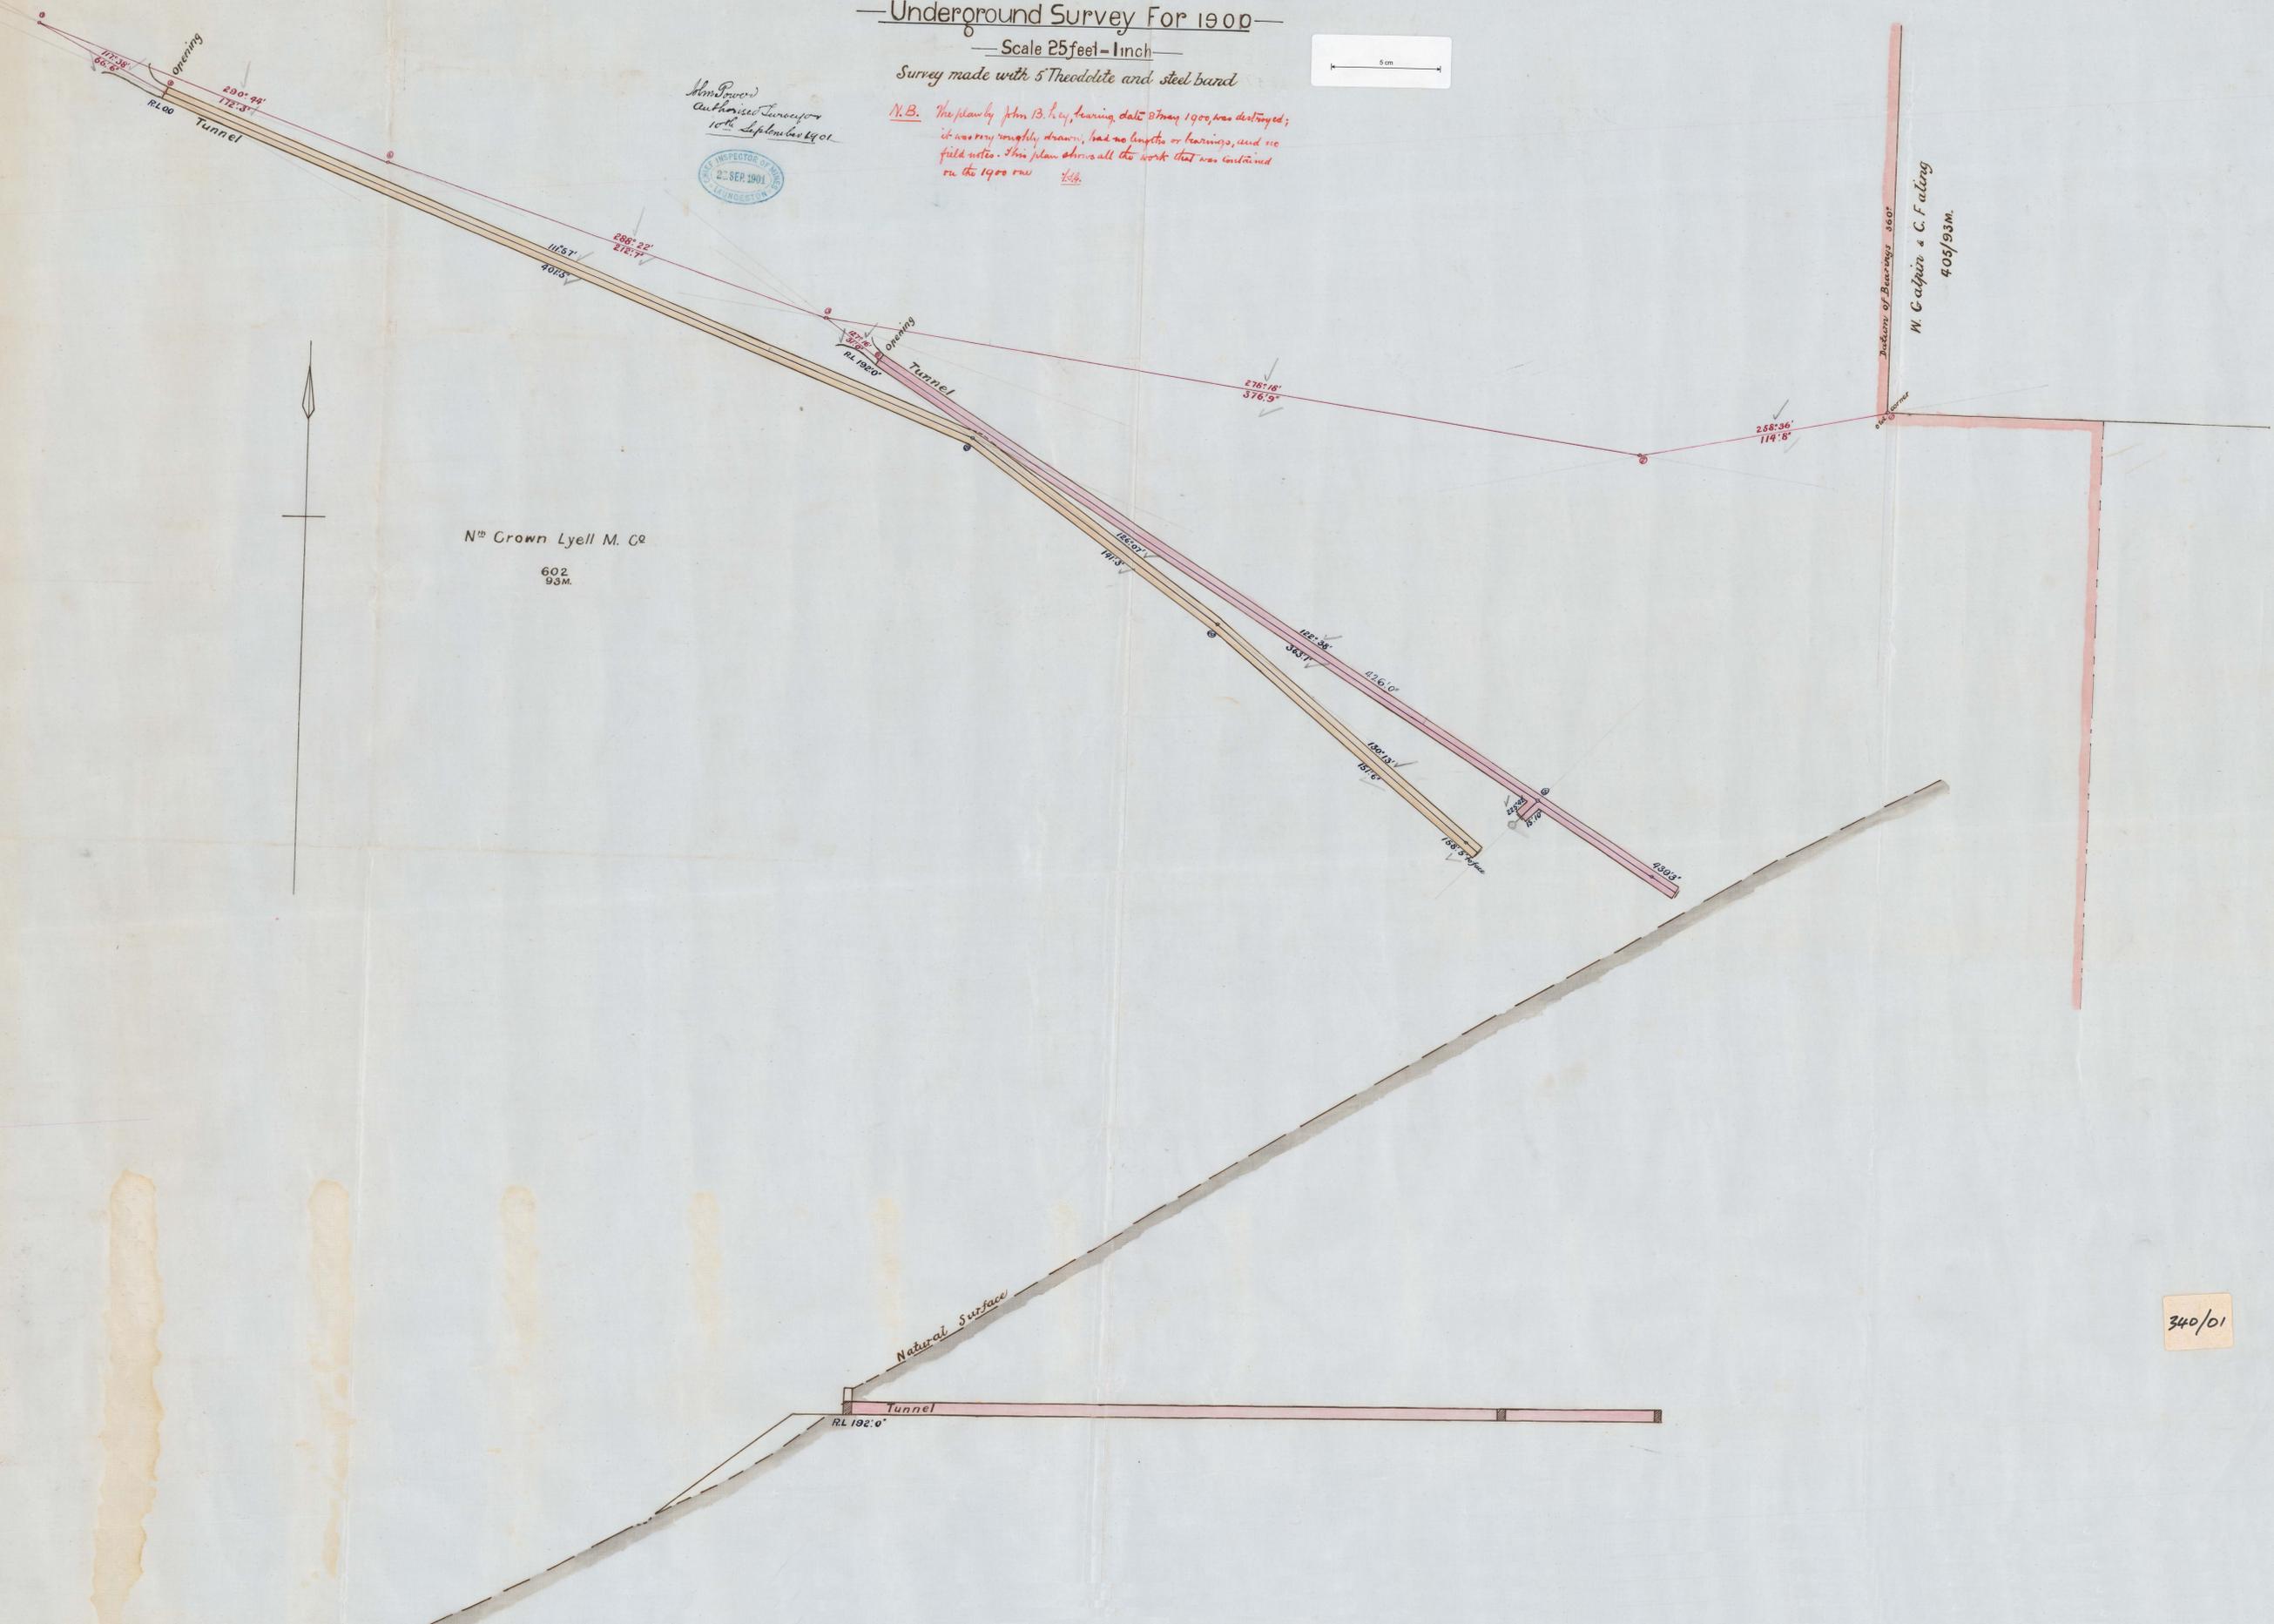

340/01