


207
1928




PLAN OF THE UNDERGROUND WORKS OF BALSTRUP'S SECTION M^T ZEEHAN

— Scale 30 feet to One Inch —

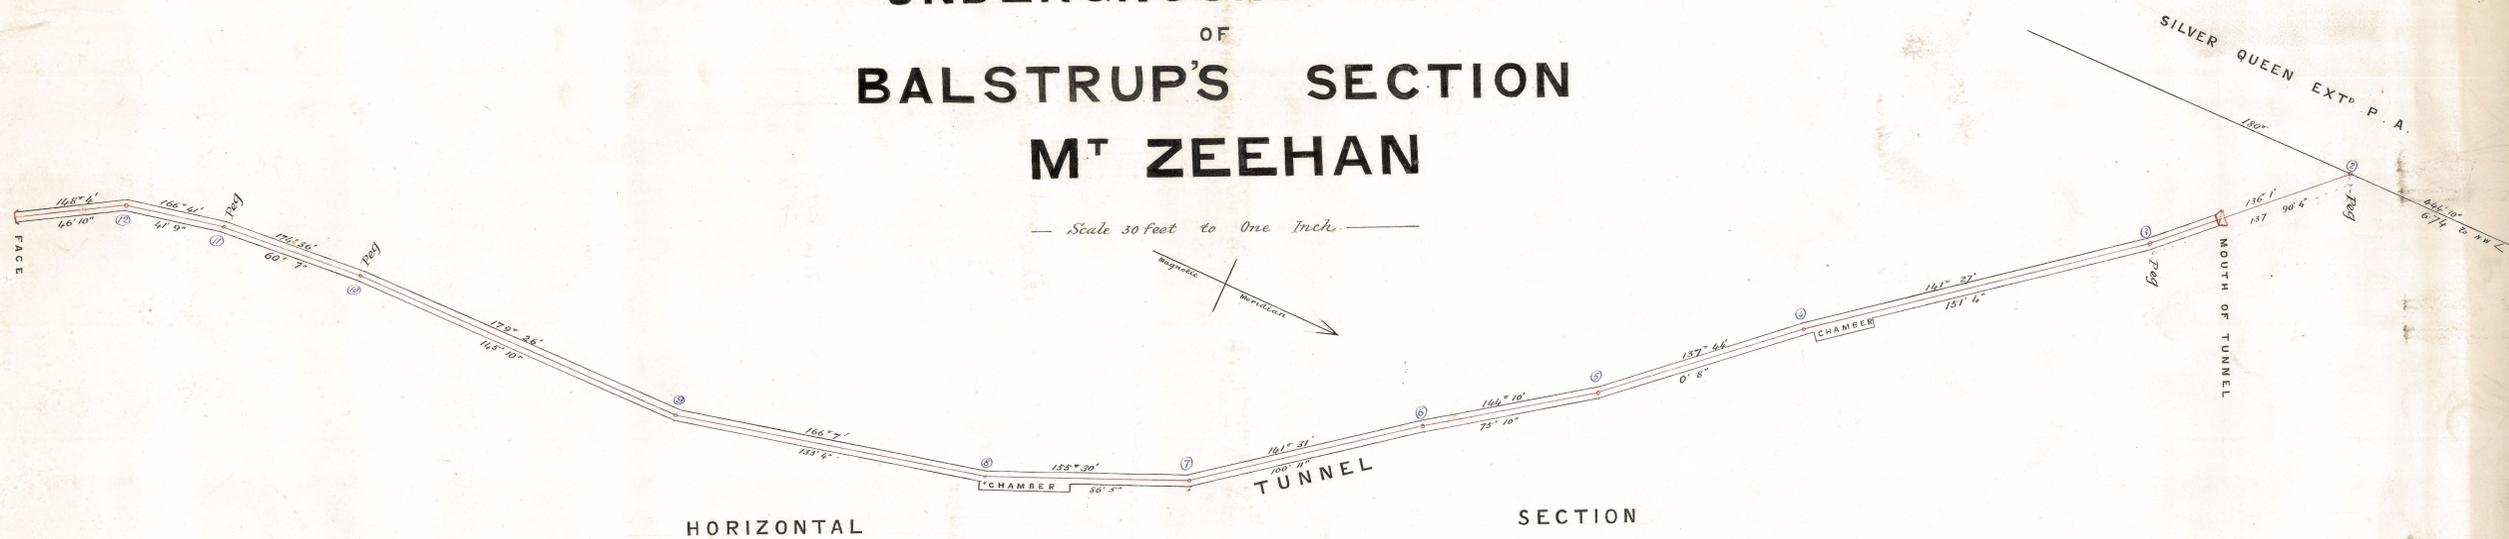

LONGITUDINAL SECTION

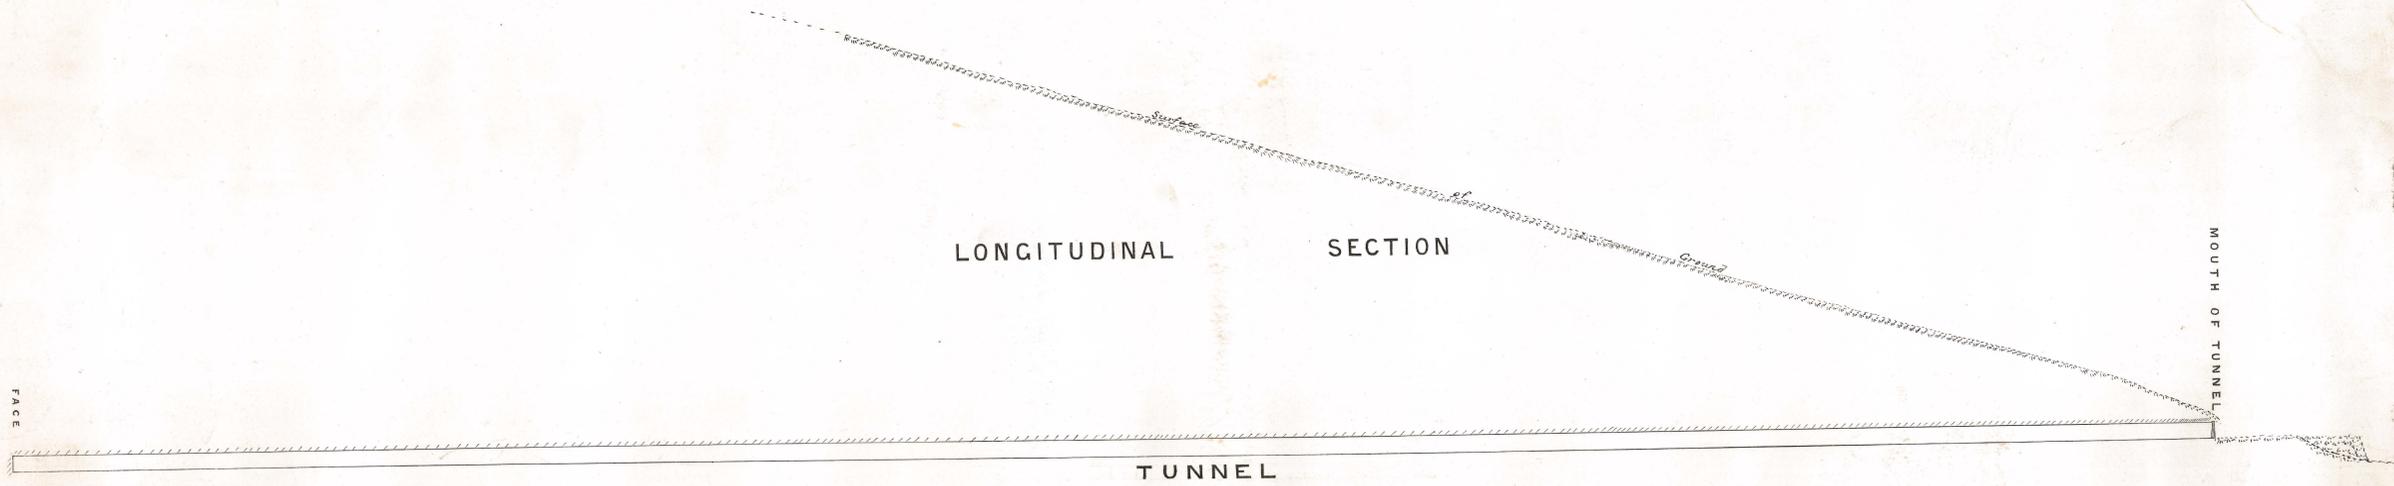

*Cholera
Auto Surveyor
Mt Zeehan*