
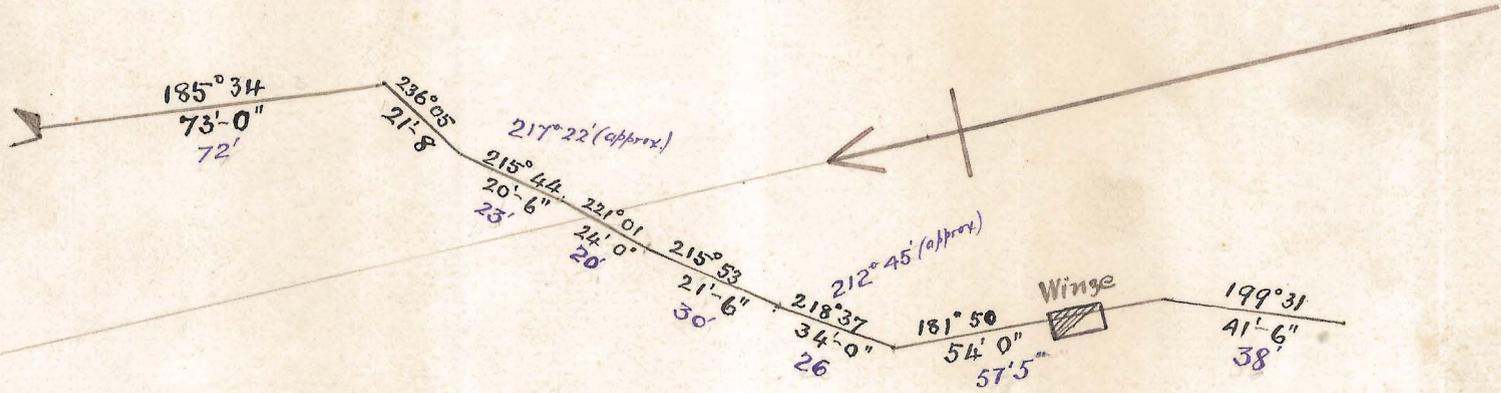


342
02

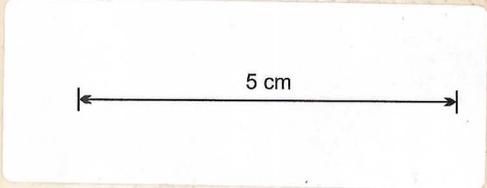

BURNIE COPPER MINES, NO-LIABILITY
 Showing Traverse Lines
 N^o 2 Tunnel
 24.6.08

Scale 40' = 1"

Leigh C. Hancock