
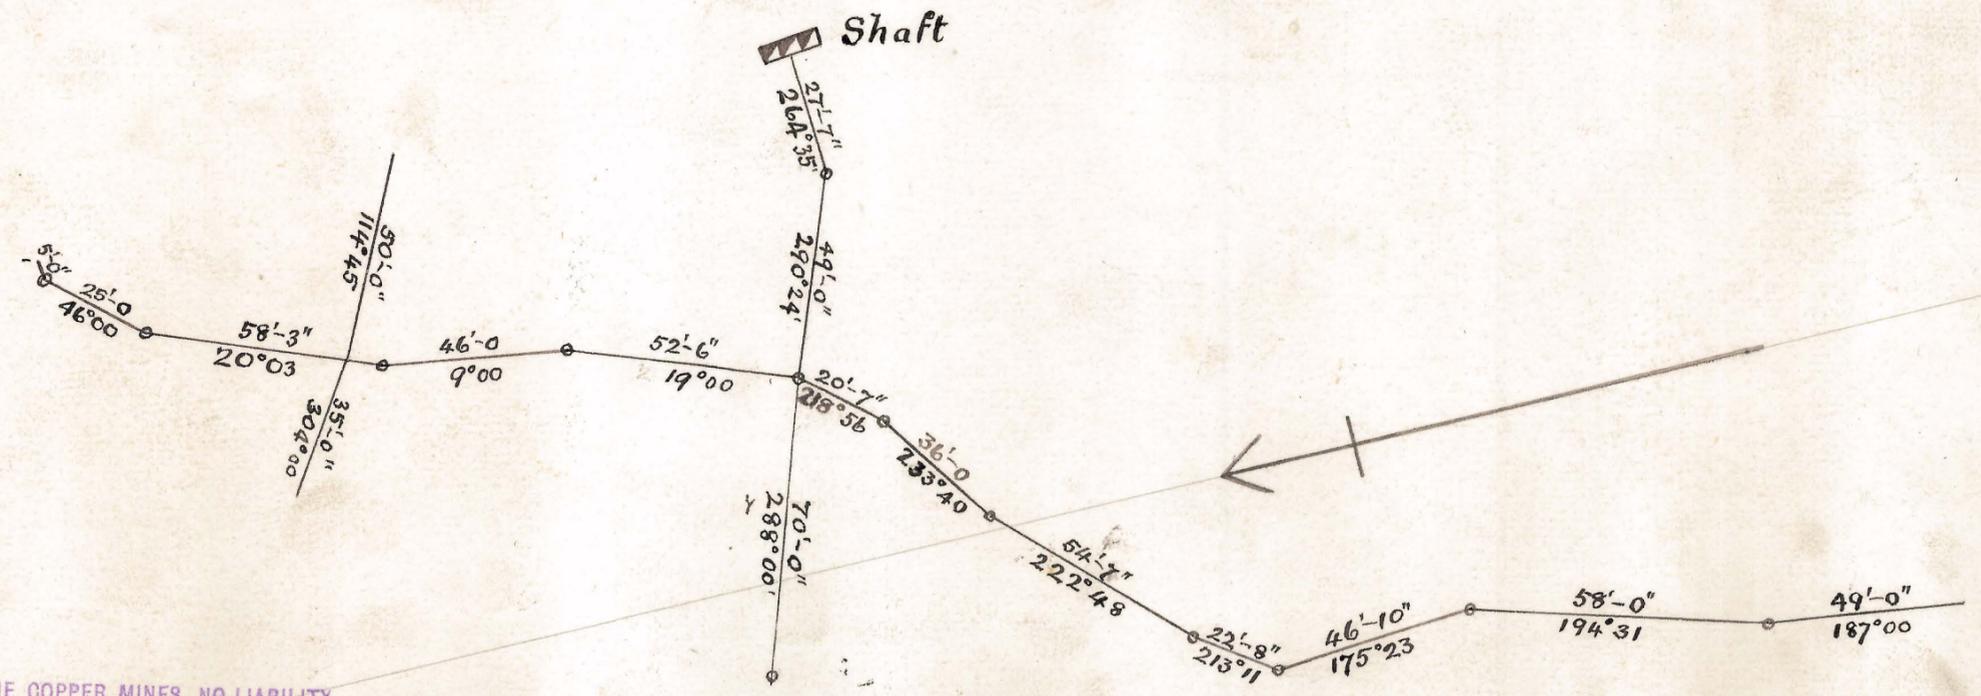


342
03

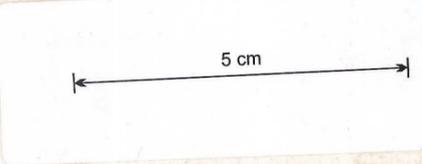

BURNIE COPPER MINES, NO-LIABILITY.

Showing Survey Lines
N°1 Level 150 ft.

Scale 40' = 1"

24. 6 08

Leigh D. Hancock