



342
04

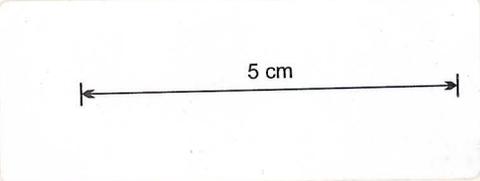

Shaft

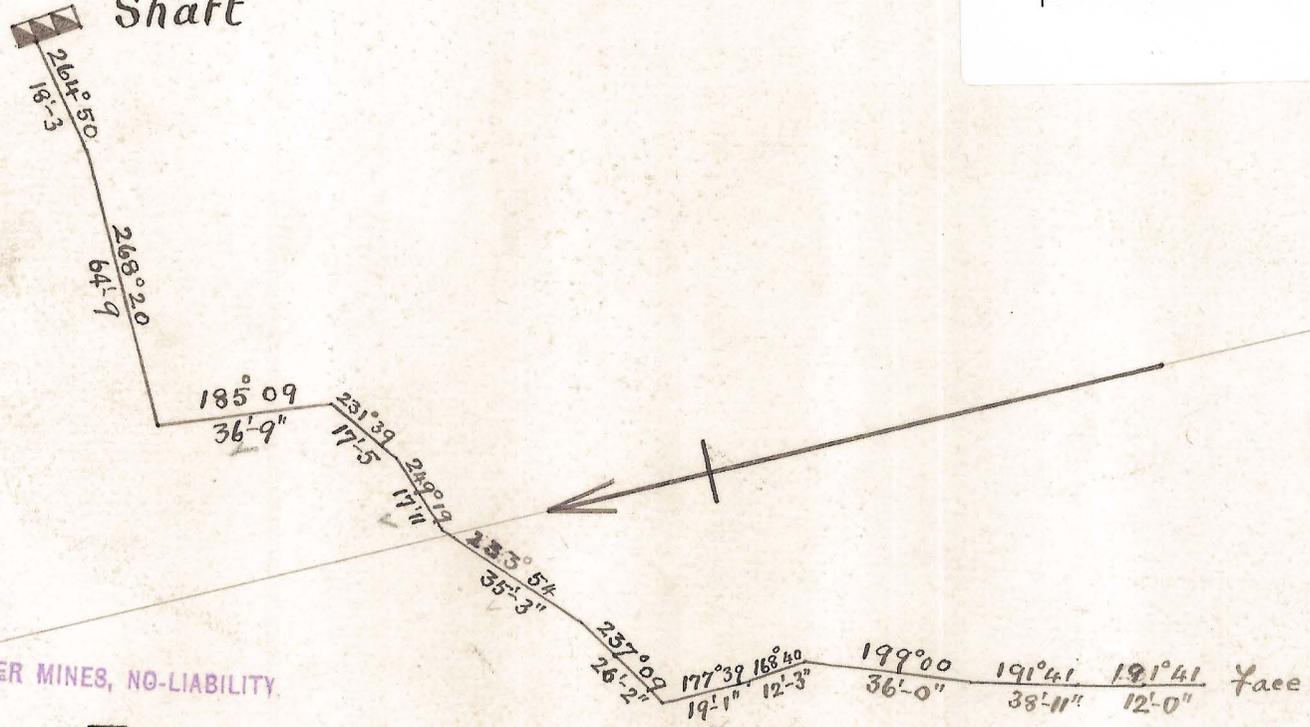

BURNIE COPPER MINES, NO-LIABILITY.

Showing Traverse Lines
N^o 2 Level 258 feet
24.6.08

Scale 40' = 1"

Leif D. Hancock